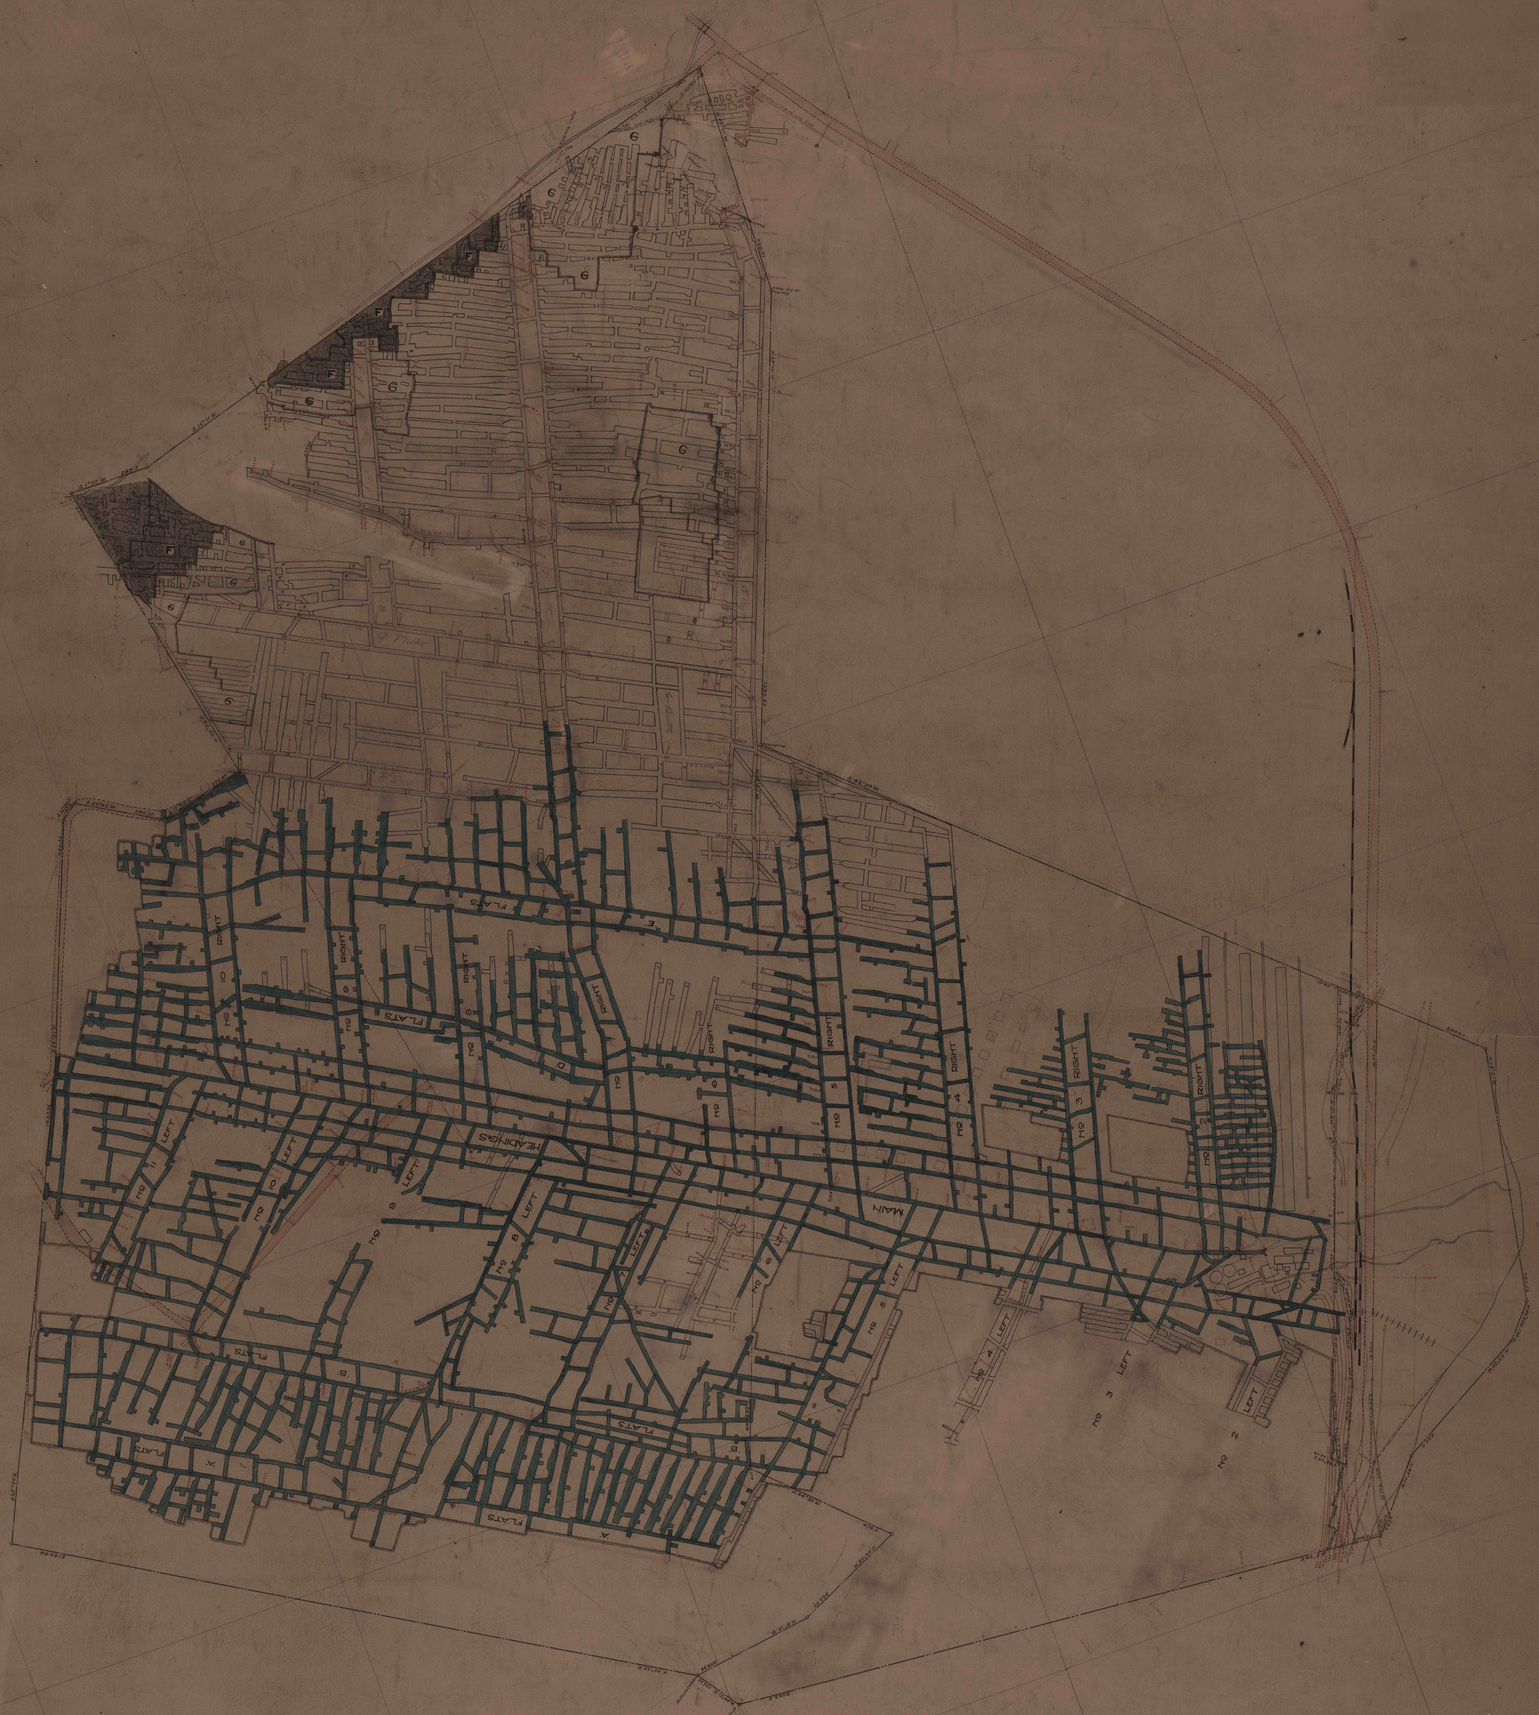
FLATS
HEADINGS
MAIN
No 1 LEFT
No 2 LEFT
No 3 LEFT
No 4 LEFT
No 5 RIGHT
No 6 RIGHT
No 7 RIGHT
No 8 RIGHT
No 9 LEFT
No 10 LEFT
No 11 LEFT