

W. Robinson
L. F.
Cutting machine & pick
Pony haulage

Complex

H. Lawhead Mine


Custom

304131

N. Robinson

L. F.

Cutting machine & pick
Pony Haulage

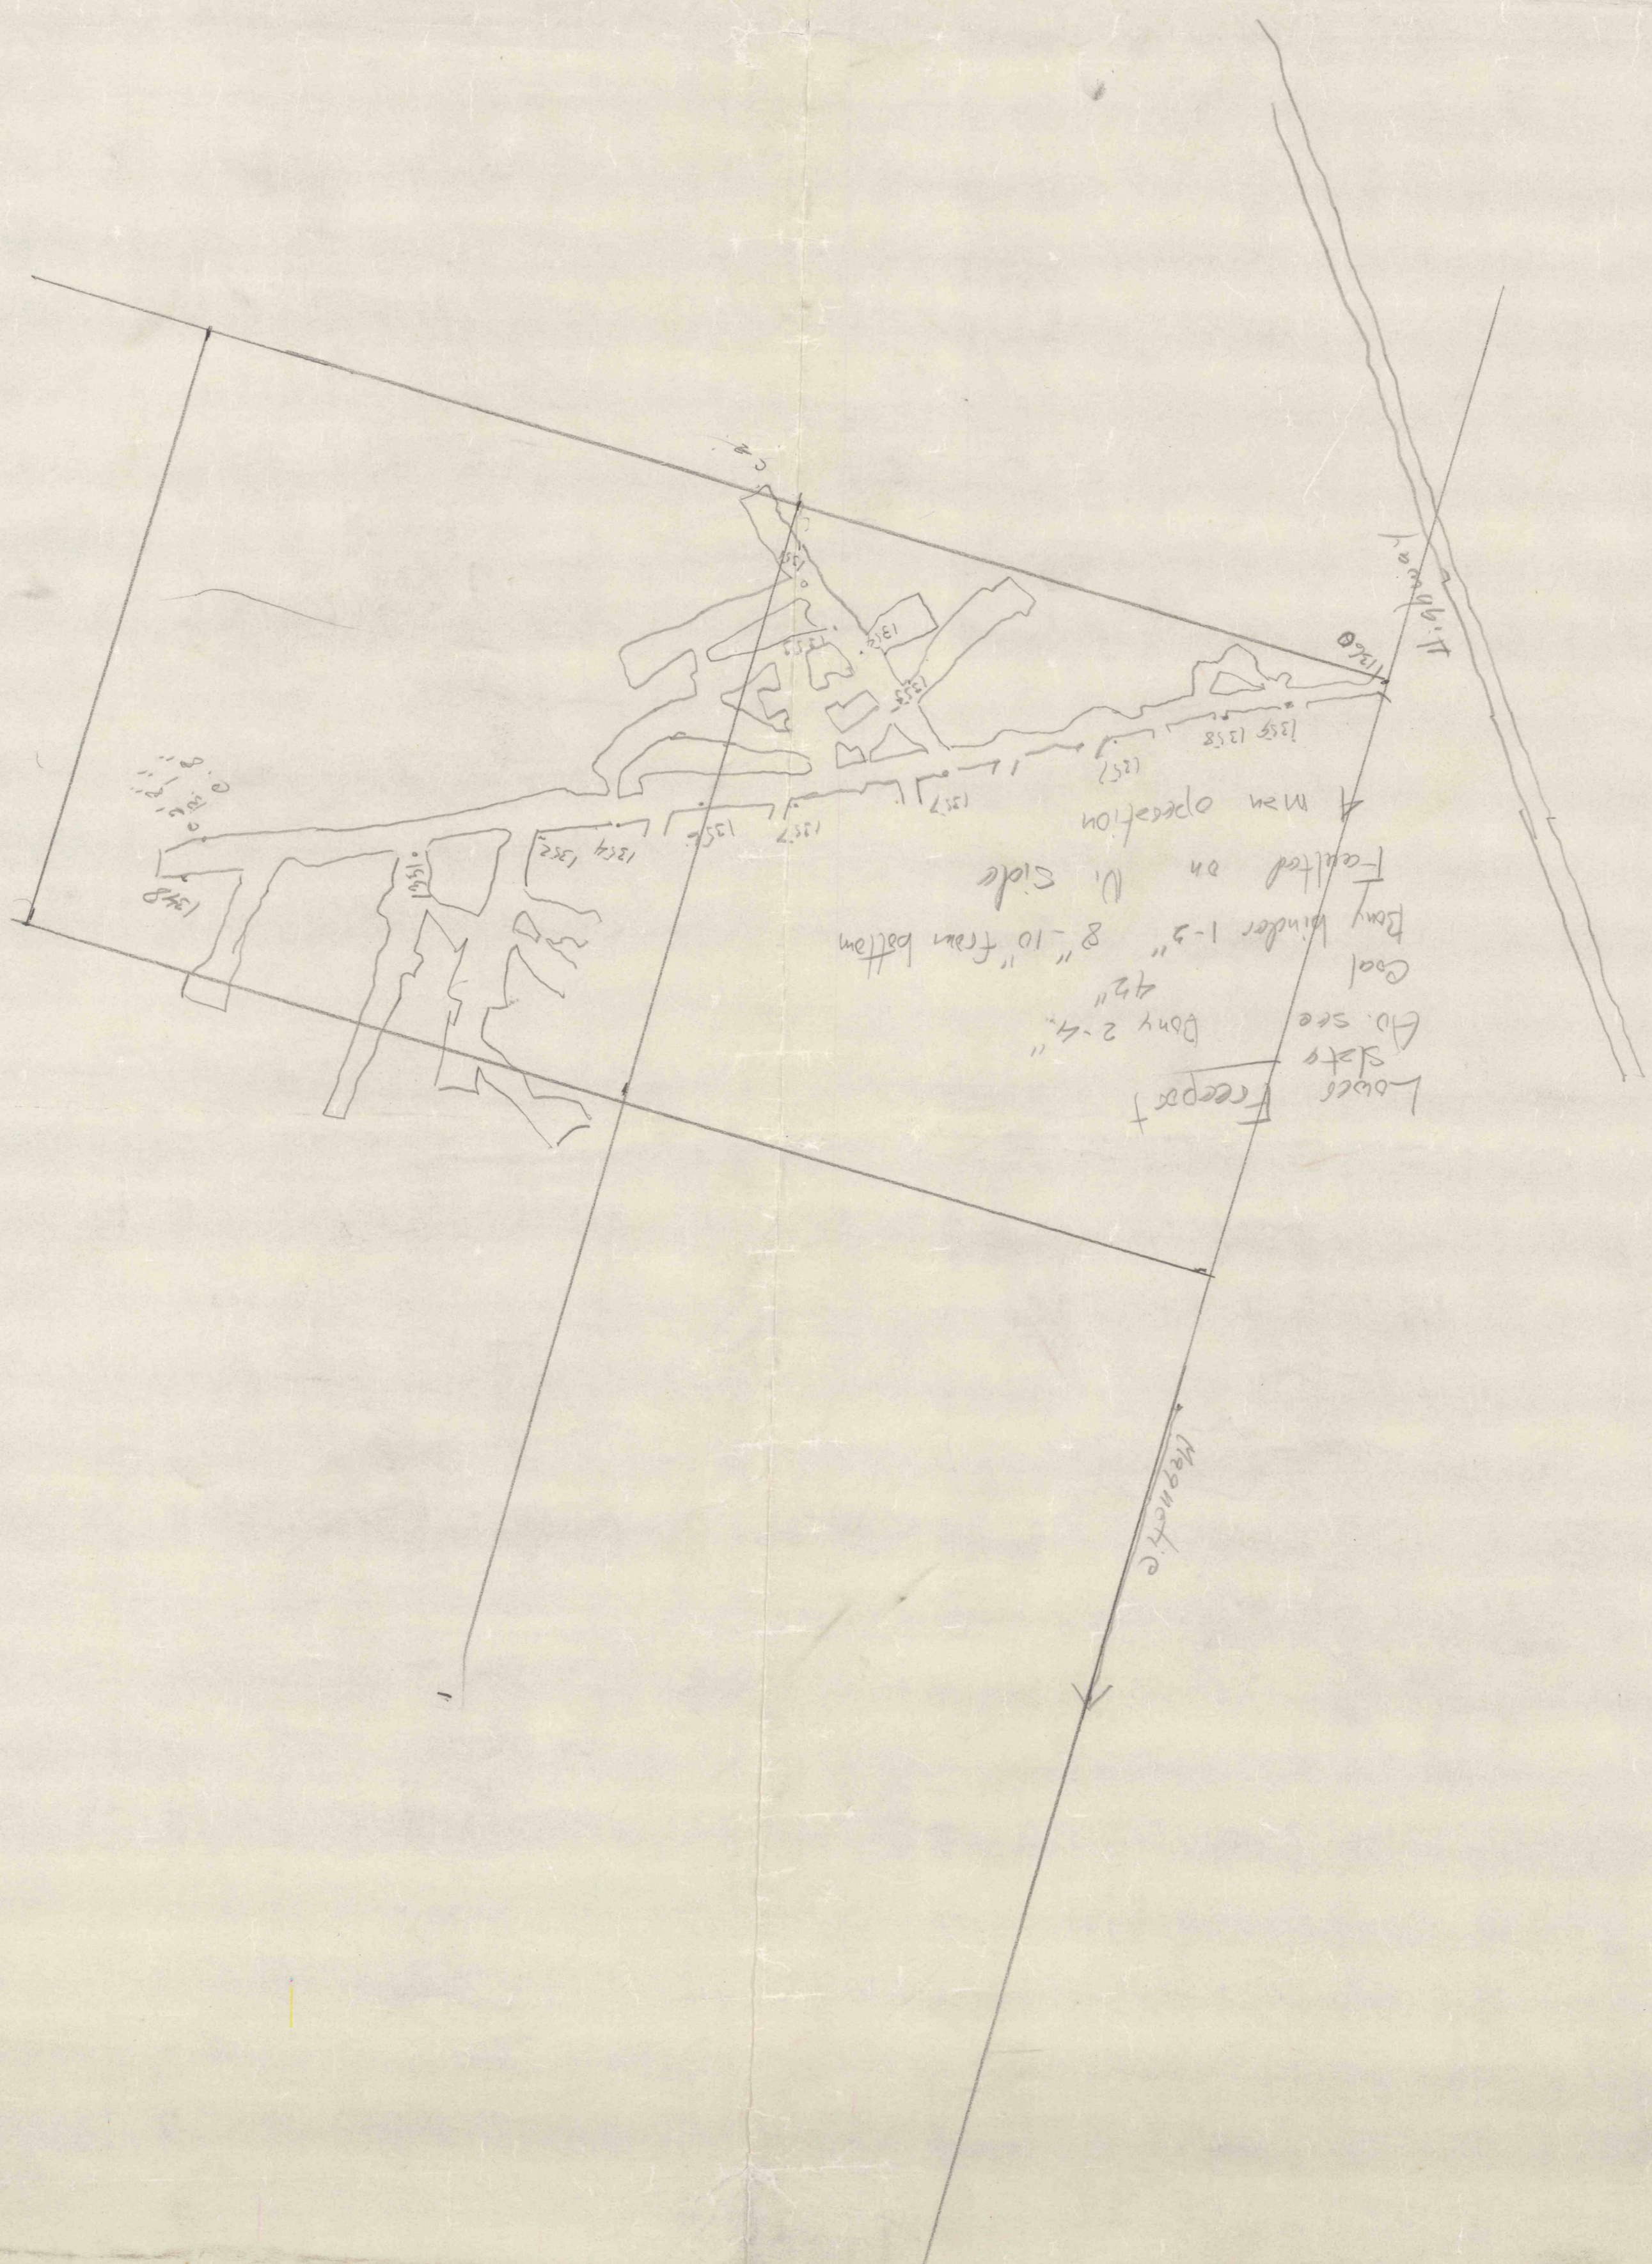

H LAWHEAD COAL CO

LAWHEAD MINE

1" = 100'