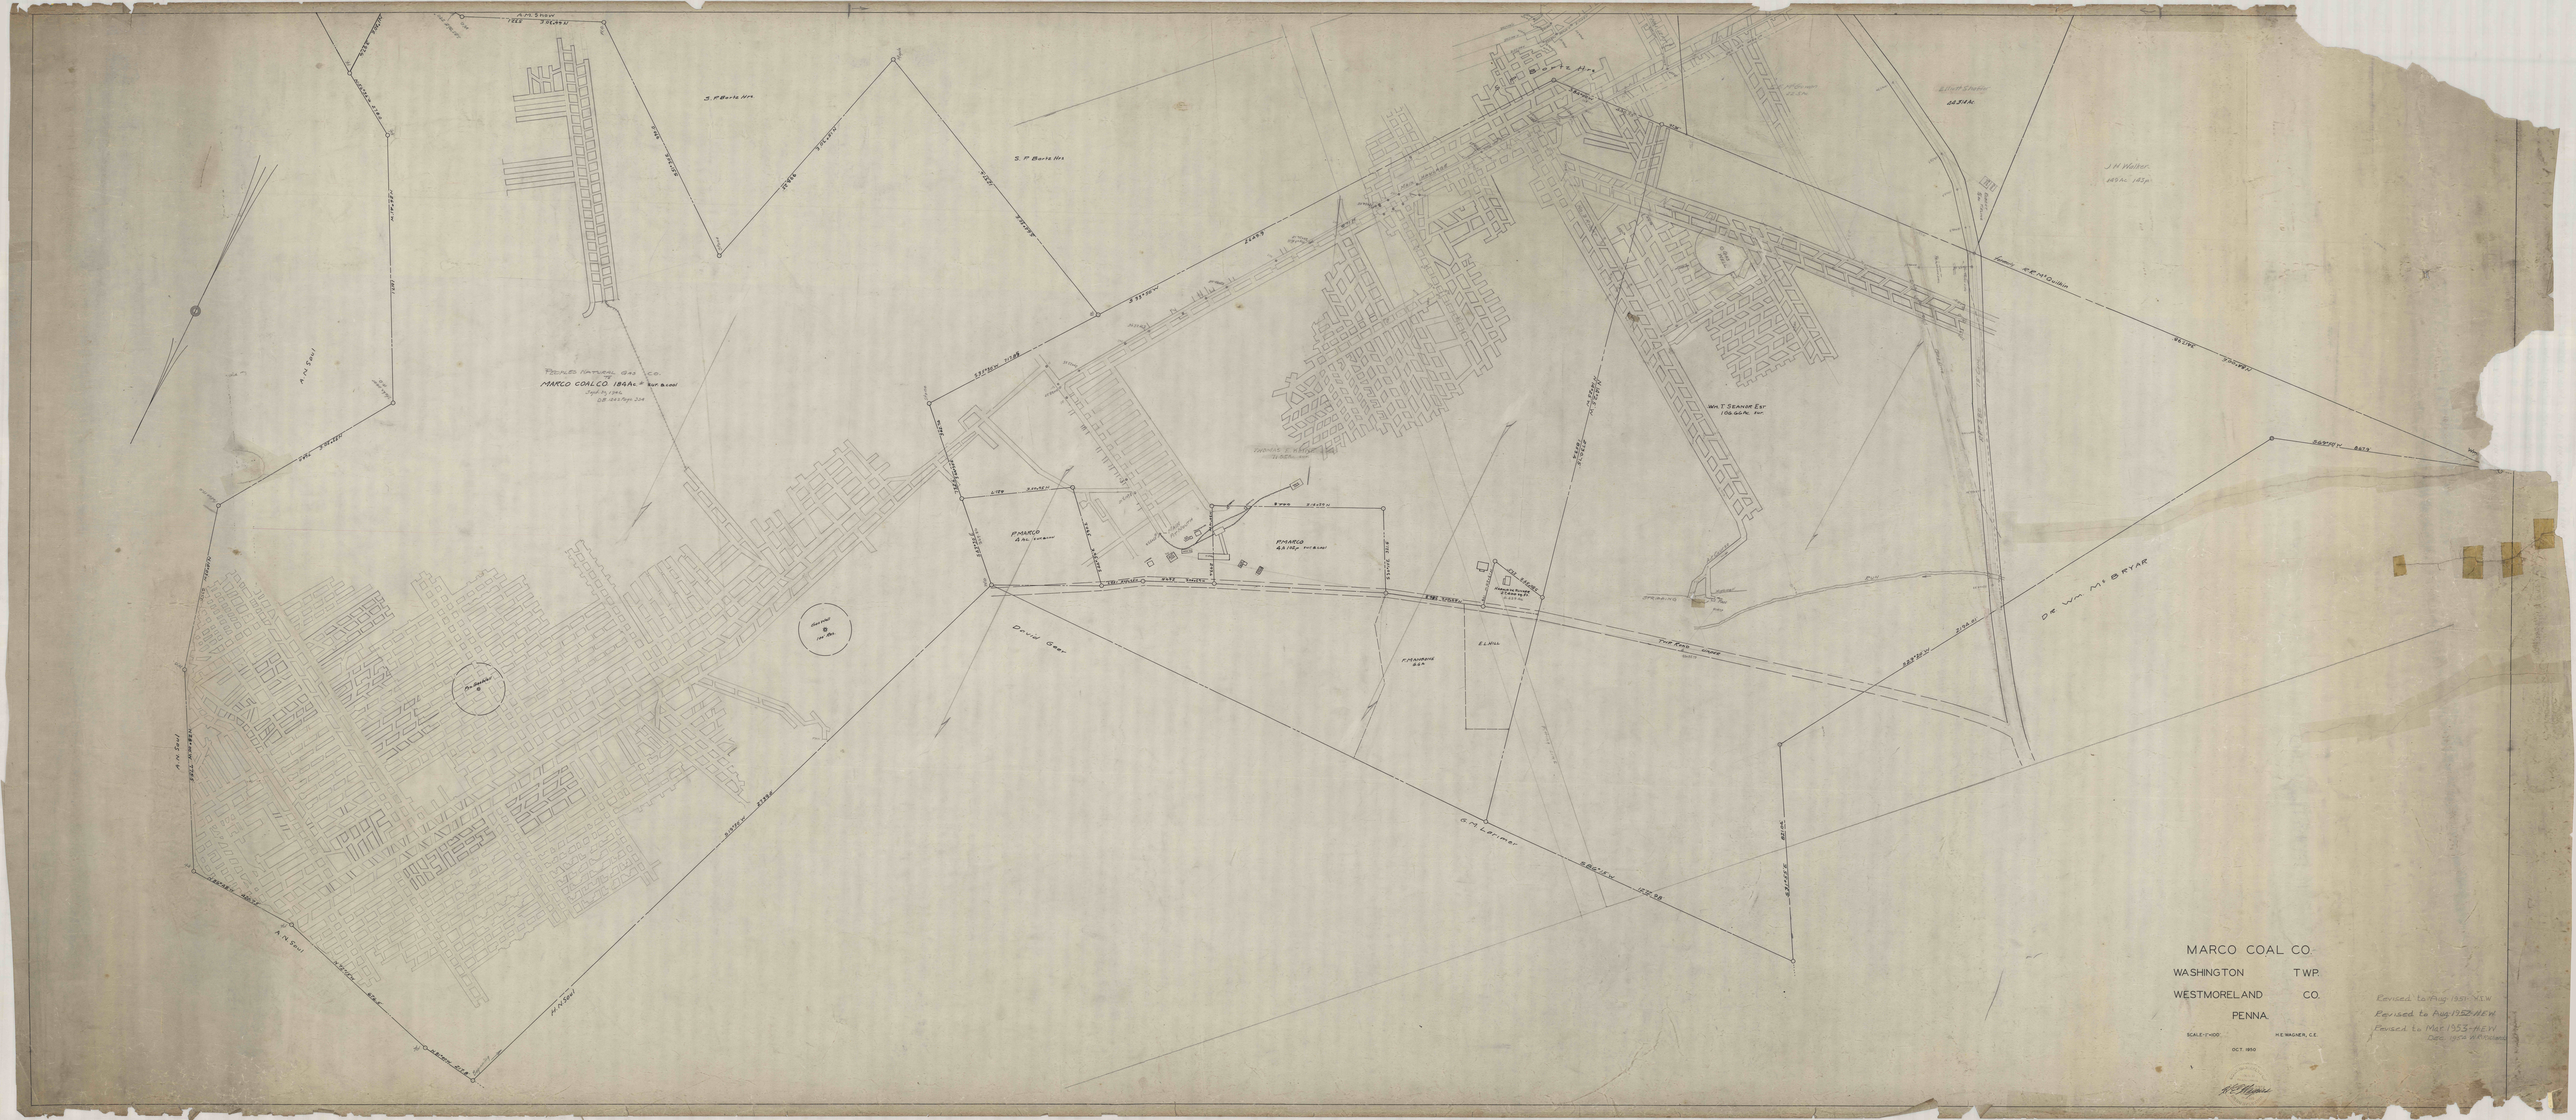
MARCO COAL CO.
WASHINGTON T.WP.
WESTMORELAND CO.
PENNA.
SCALE-1"=100'
OCT. 1950
H.E. WAGNER, C.E.
Revised to Aug 1951 H.E.W.
Revised to Aug 1952 H.E.W.
Revised to Mar 1953 H.E.W.
Pittsburgh Natural Gas Co.
MARCO COAL CO. 184Ac ± Surface
Sept 15, 1926
DB 661 Pg. 334
S. F. Barto Hrs.
J. H. Walter
165 Ac. ± Surface
Wm. T. Seanor Est.
106.66 Ac. ± Surface
P. MARCO
A.R. Surface
P. MARCO
A.R. 118 Ac. ± Surface
Drum Gear
