



183 N 1/4


184 ac.

3 ac.

MARCO COAL COMPANY

WASHINGTON TWP.
WESTMORELAND CO.

PENNA.

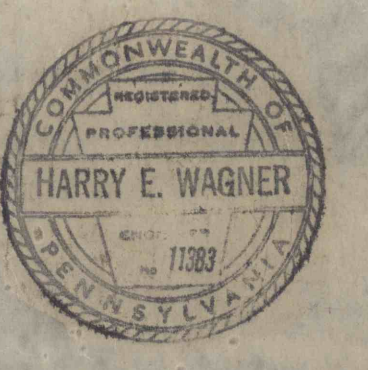

H.E. WAGNER-RE-11383

SCALE-1"=100'

Engineer's Note:
This map shows only the portions of Marco Coal Co.
workings currently being worked as re-surveyed
by me in date. This map will be revised and
additional information, as required by Law, will
be added from each month until complete.
Feb. 5, 1949 H.E. Wagner, R.P.E. 11383.