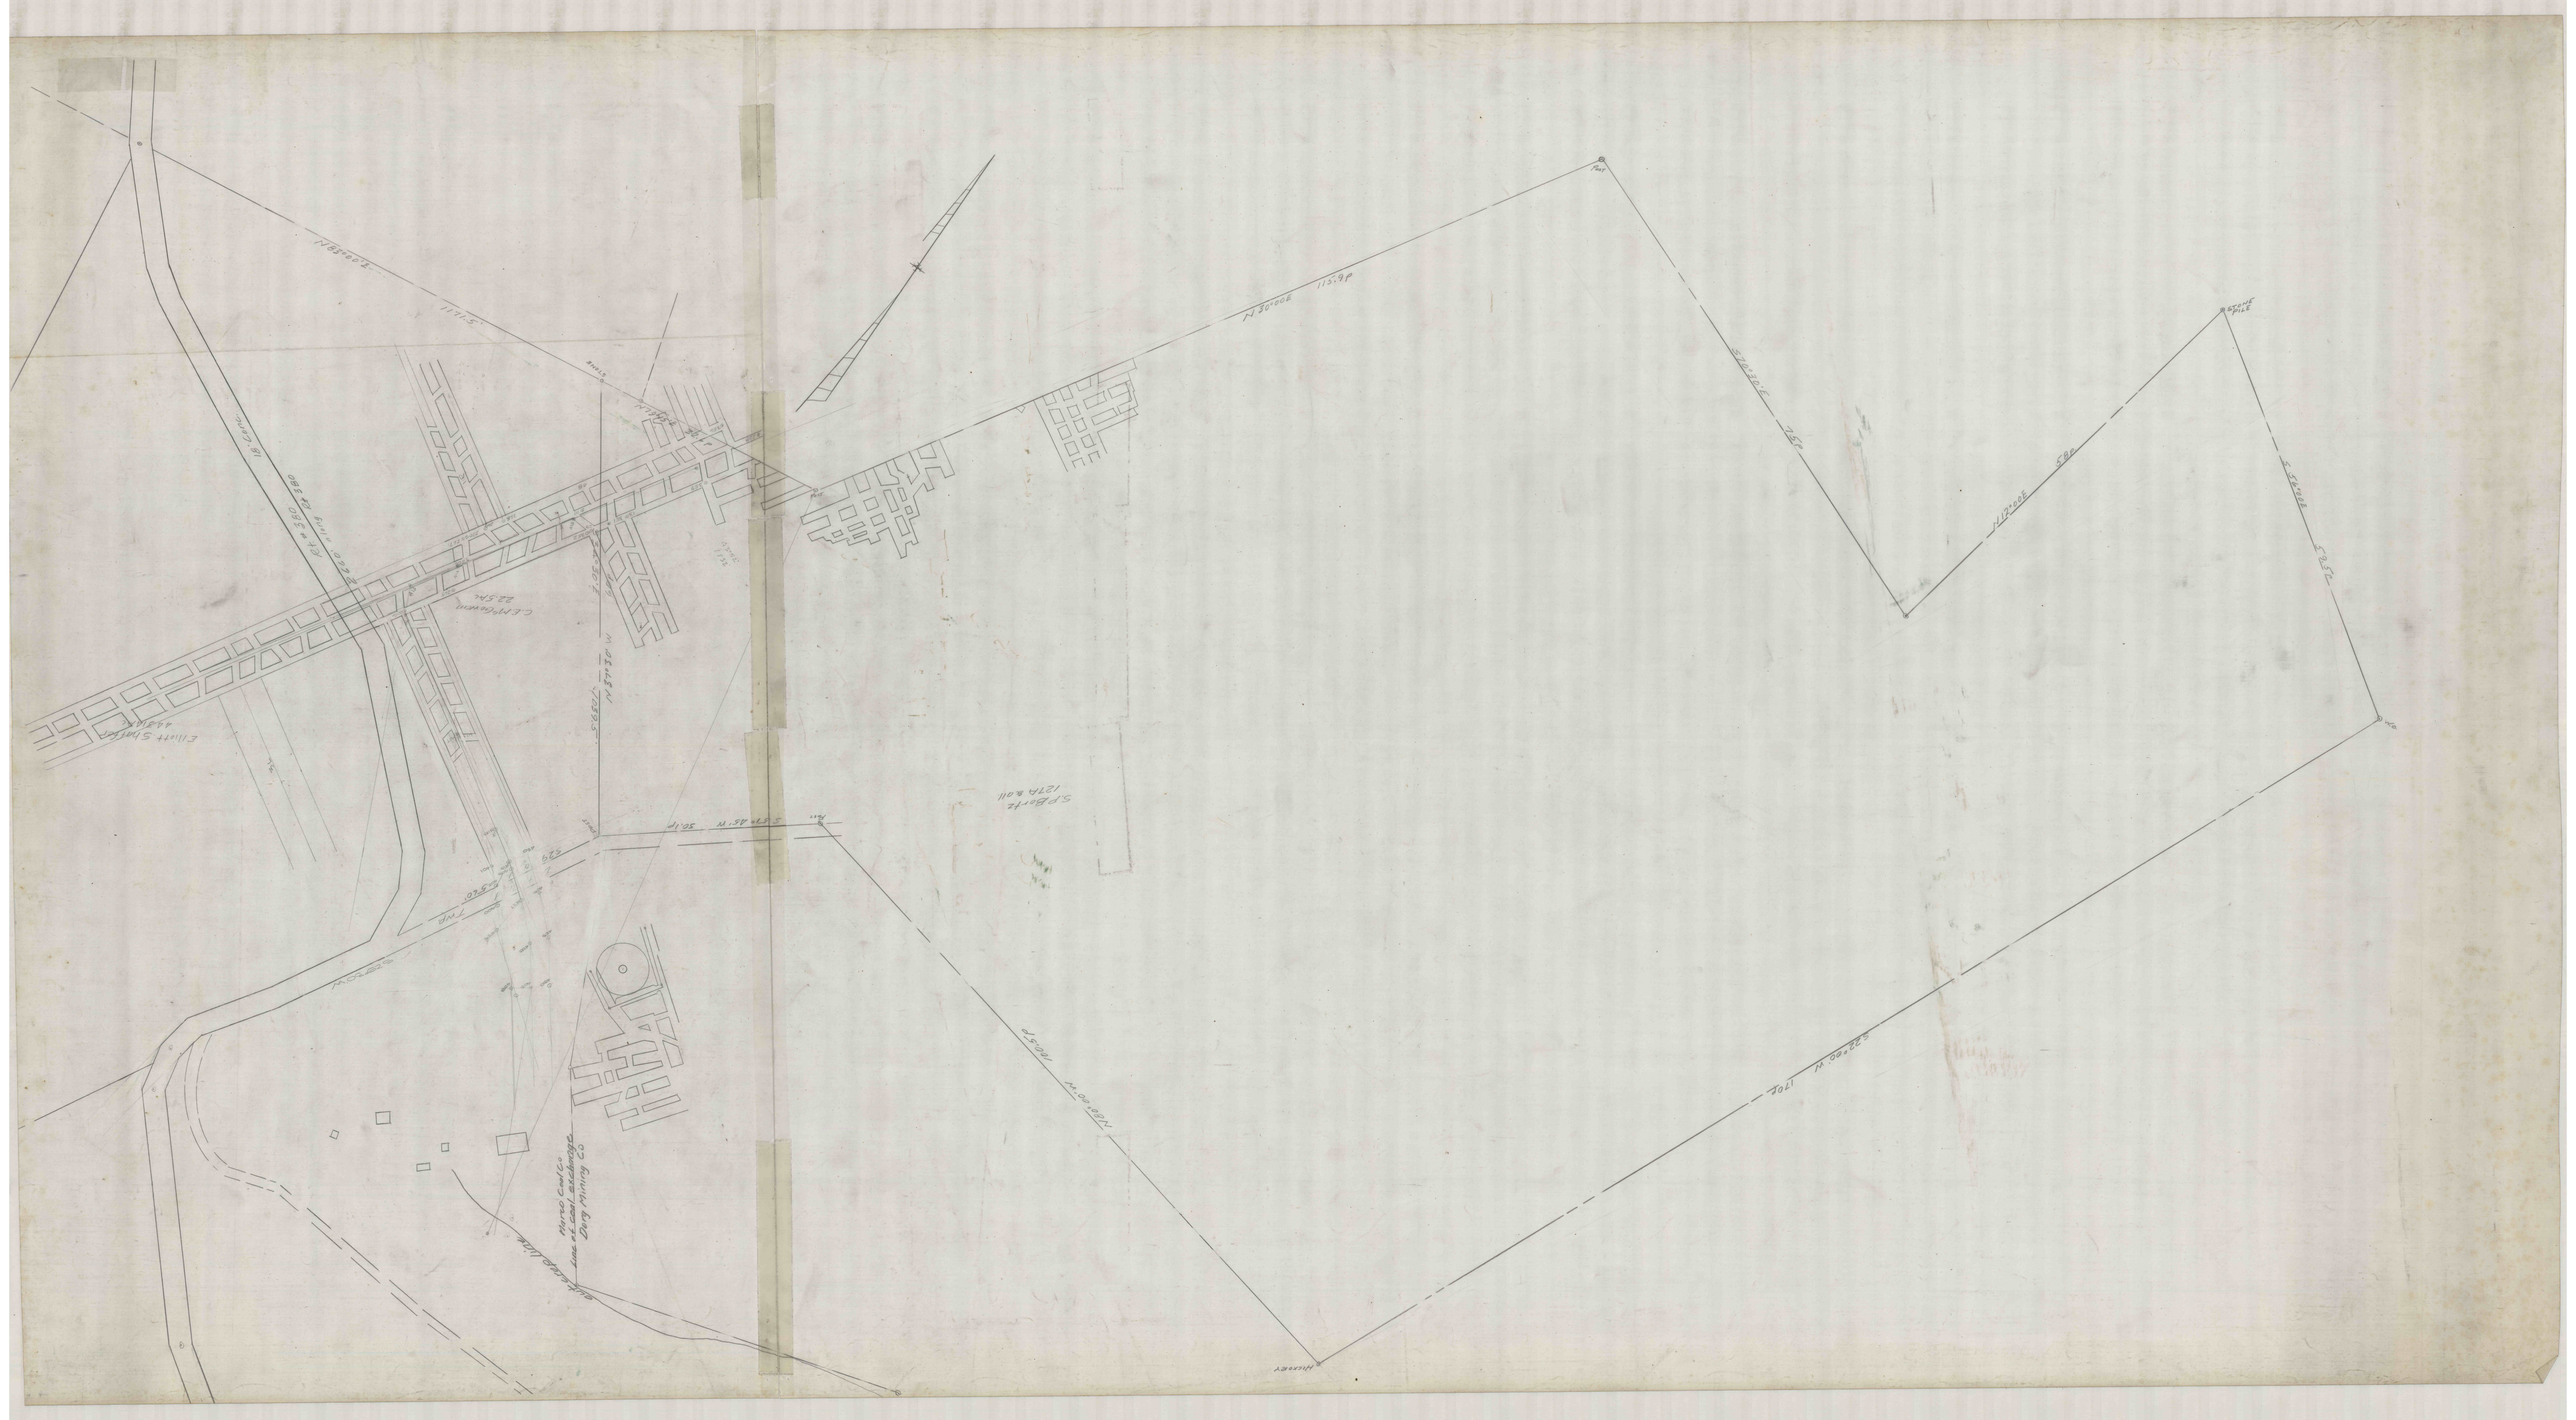

Elliott Shafter
C.E.McGowan
S.P.Bortz
Marco Coal Co
Line of Coal exchange
Dorg Mining Co