


MAP SHOWING
 FRONTAGE OF BARNES LEASE
 AND
 STERLING NO 7 MINE
 Bakeron, Camb. Co., Penna.
 Scale 1"=100' July 1915.

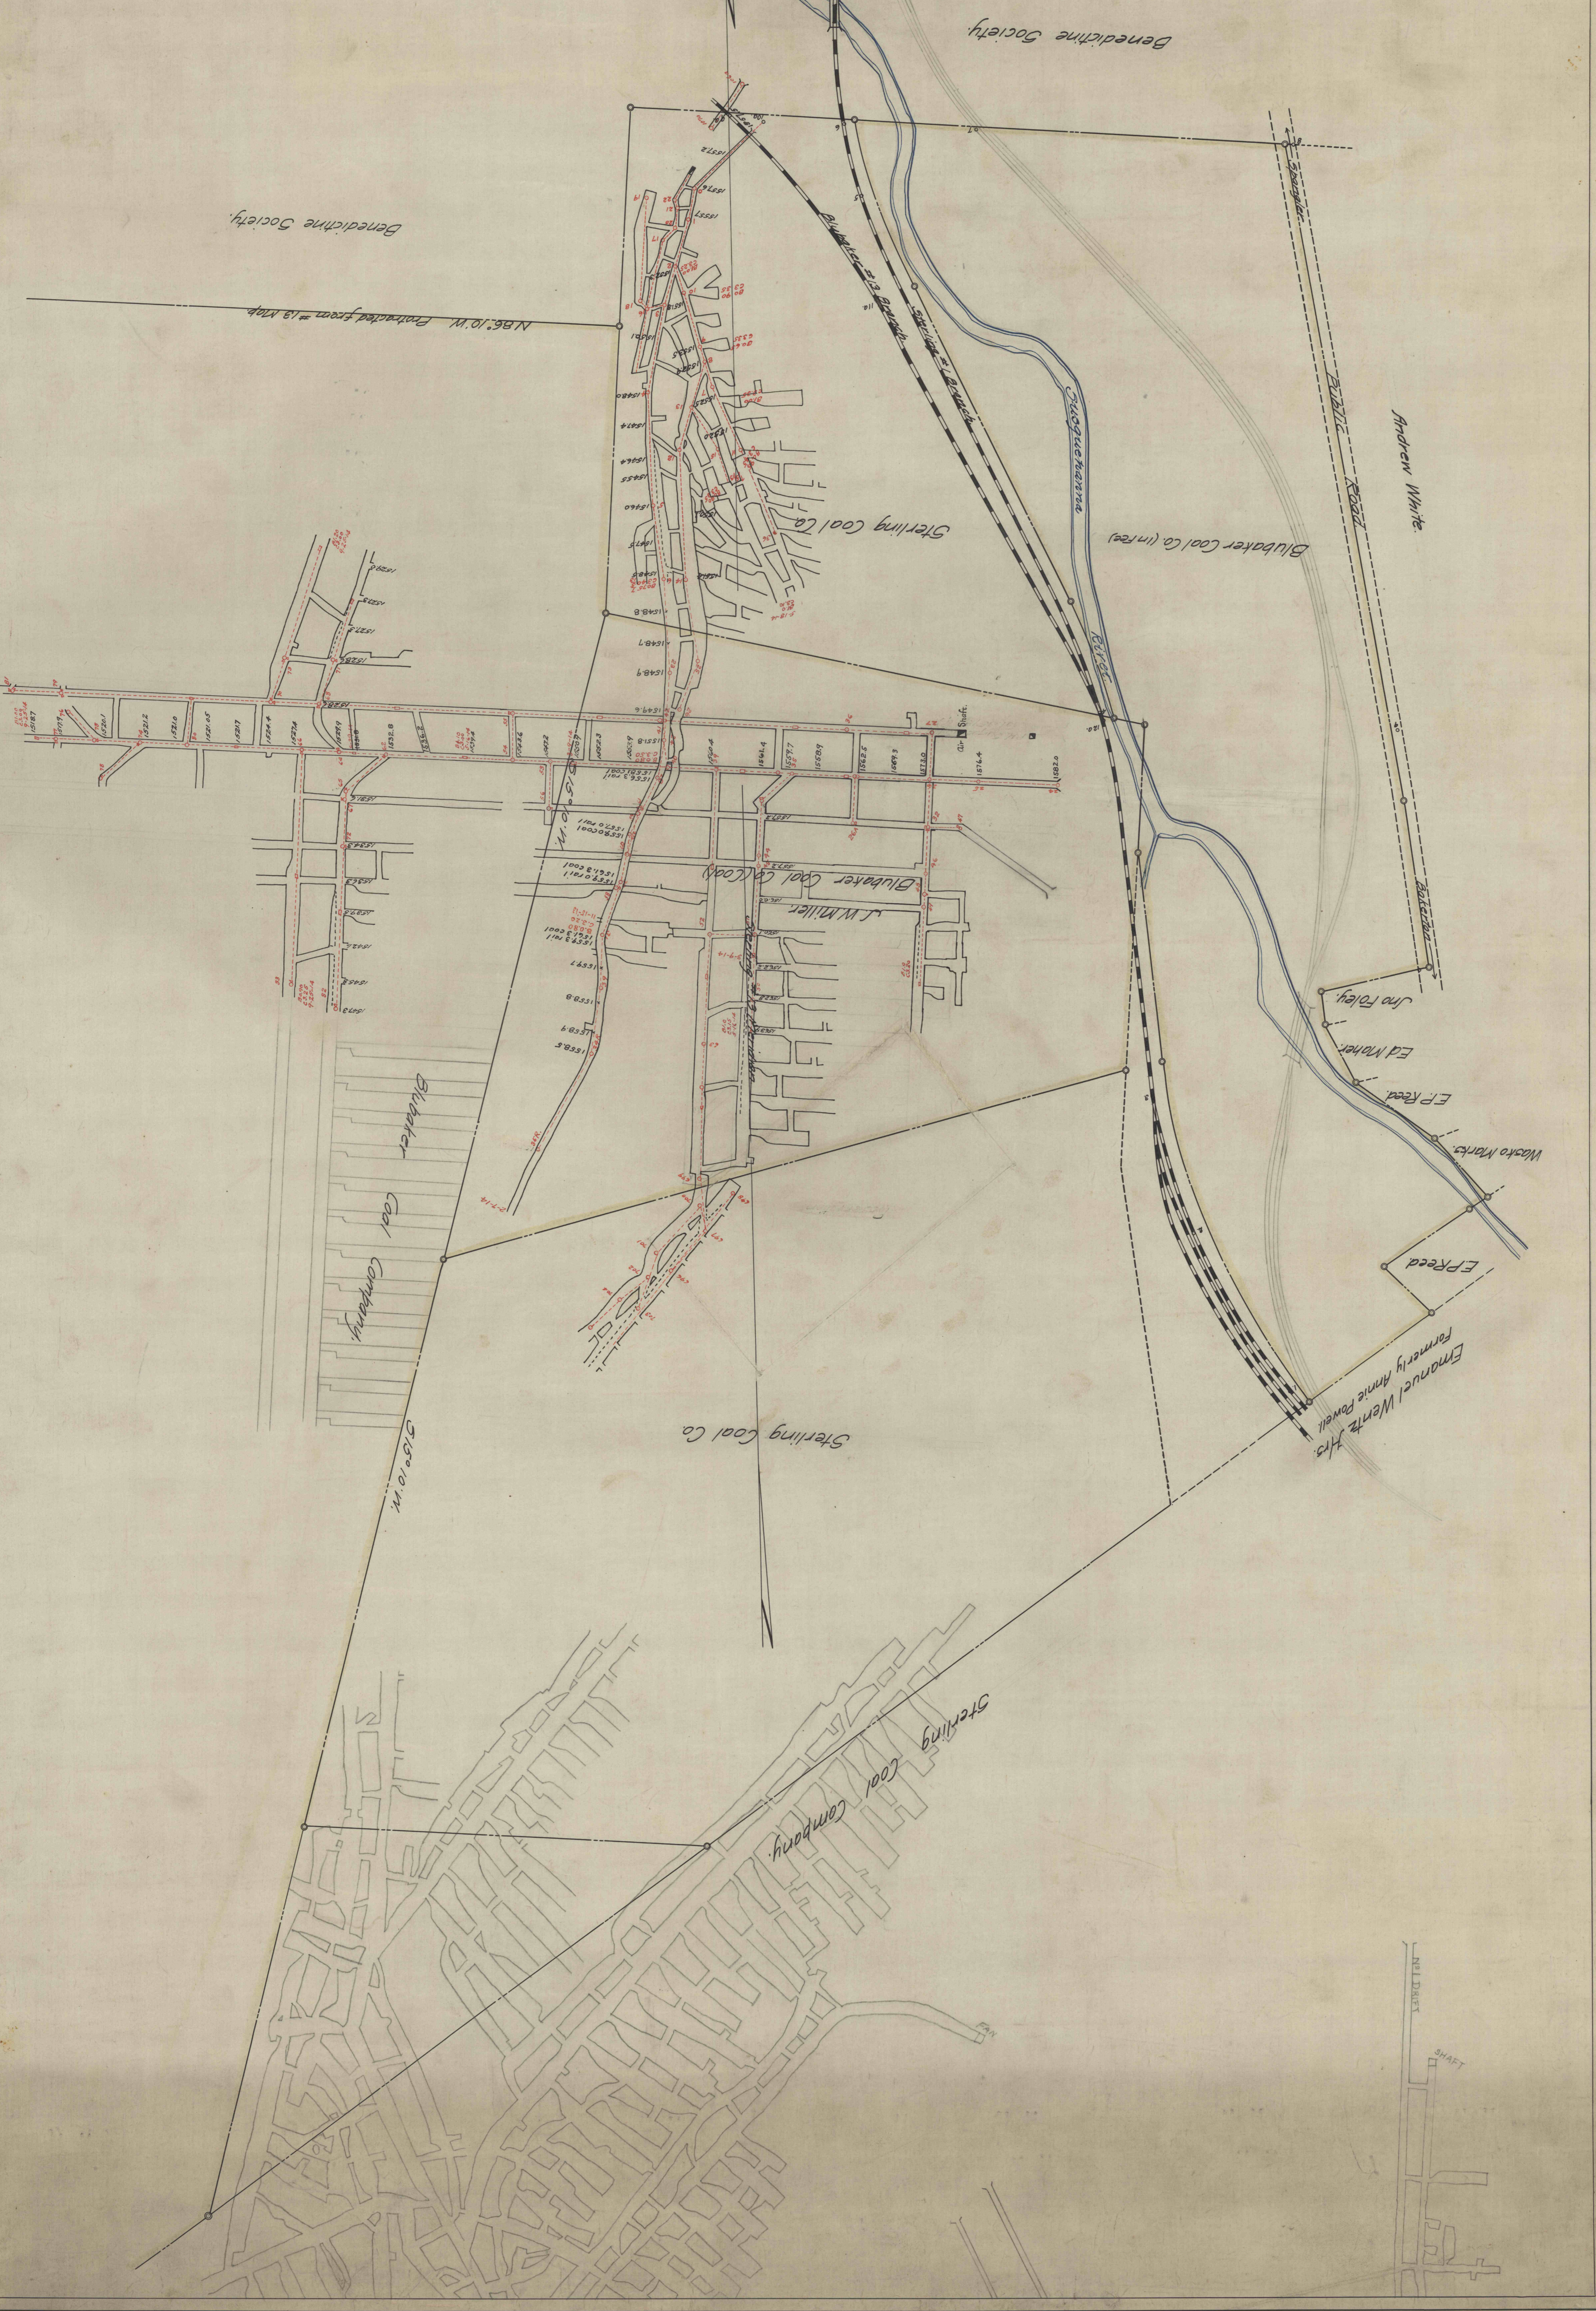

Chas E. Schickler Eng'r

SHAFT
 NEL DURY