


LLY COAL COMPANY

27 A. condemned
Rem. due to
Water had
33C

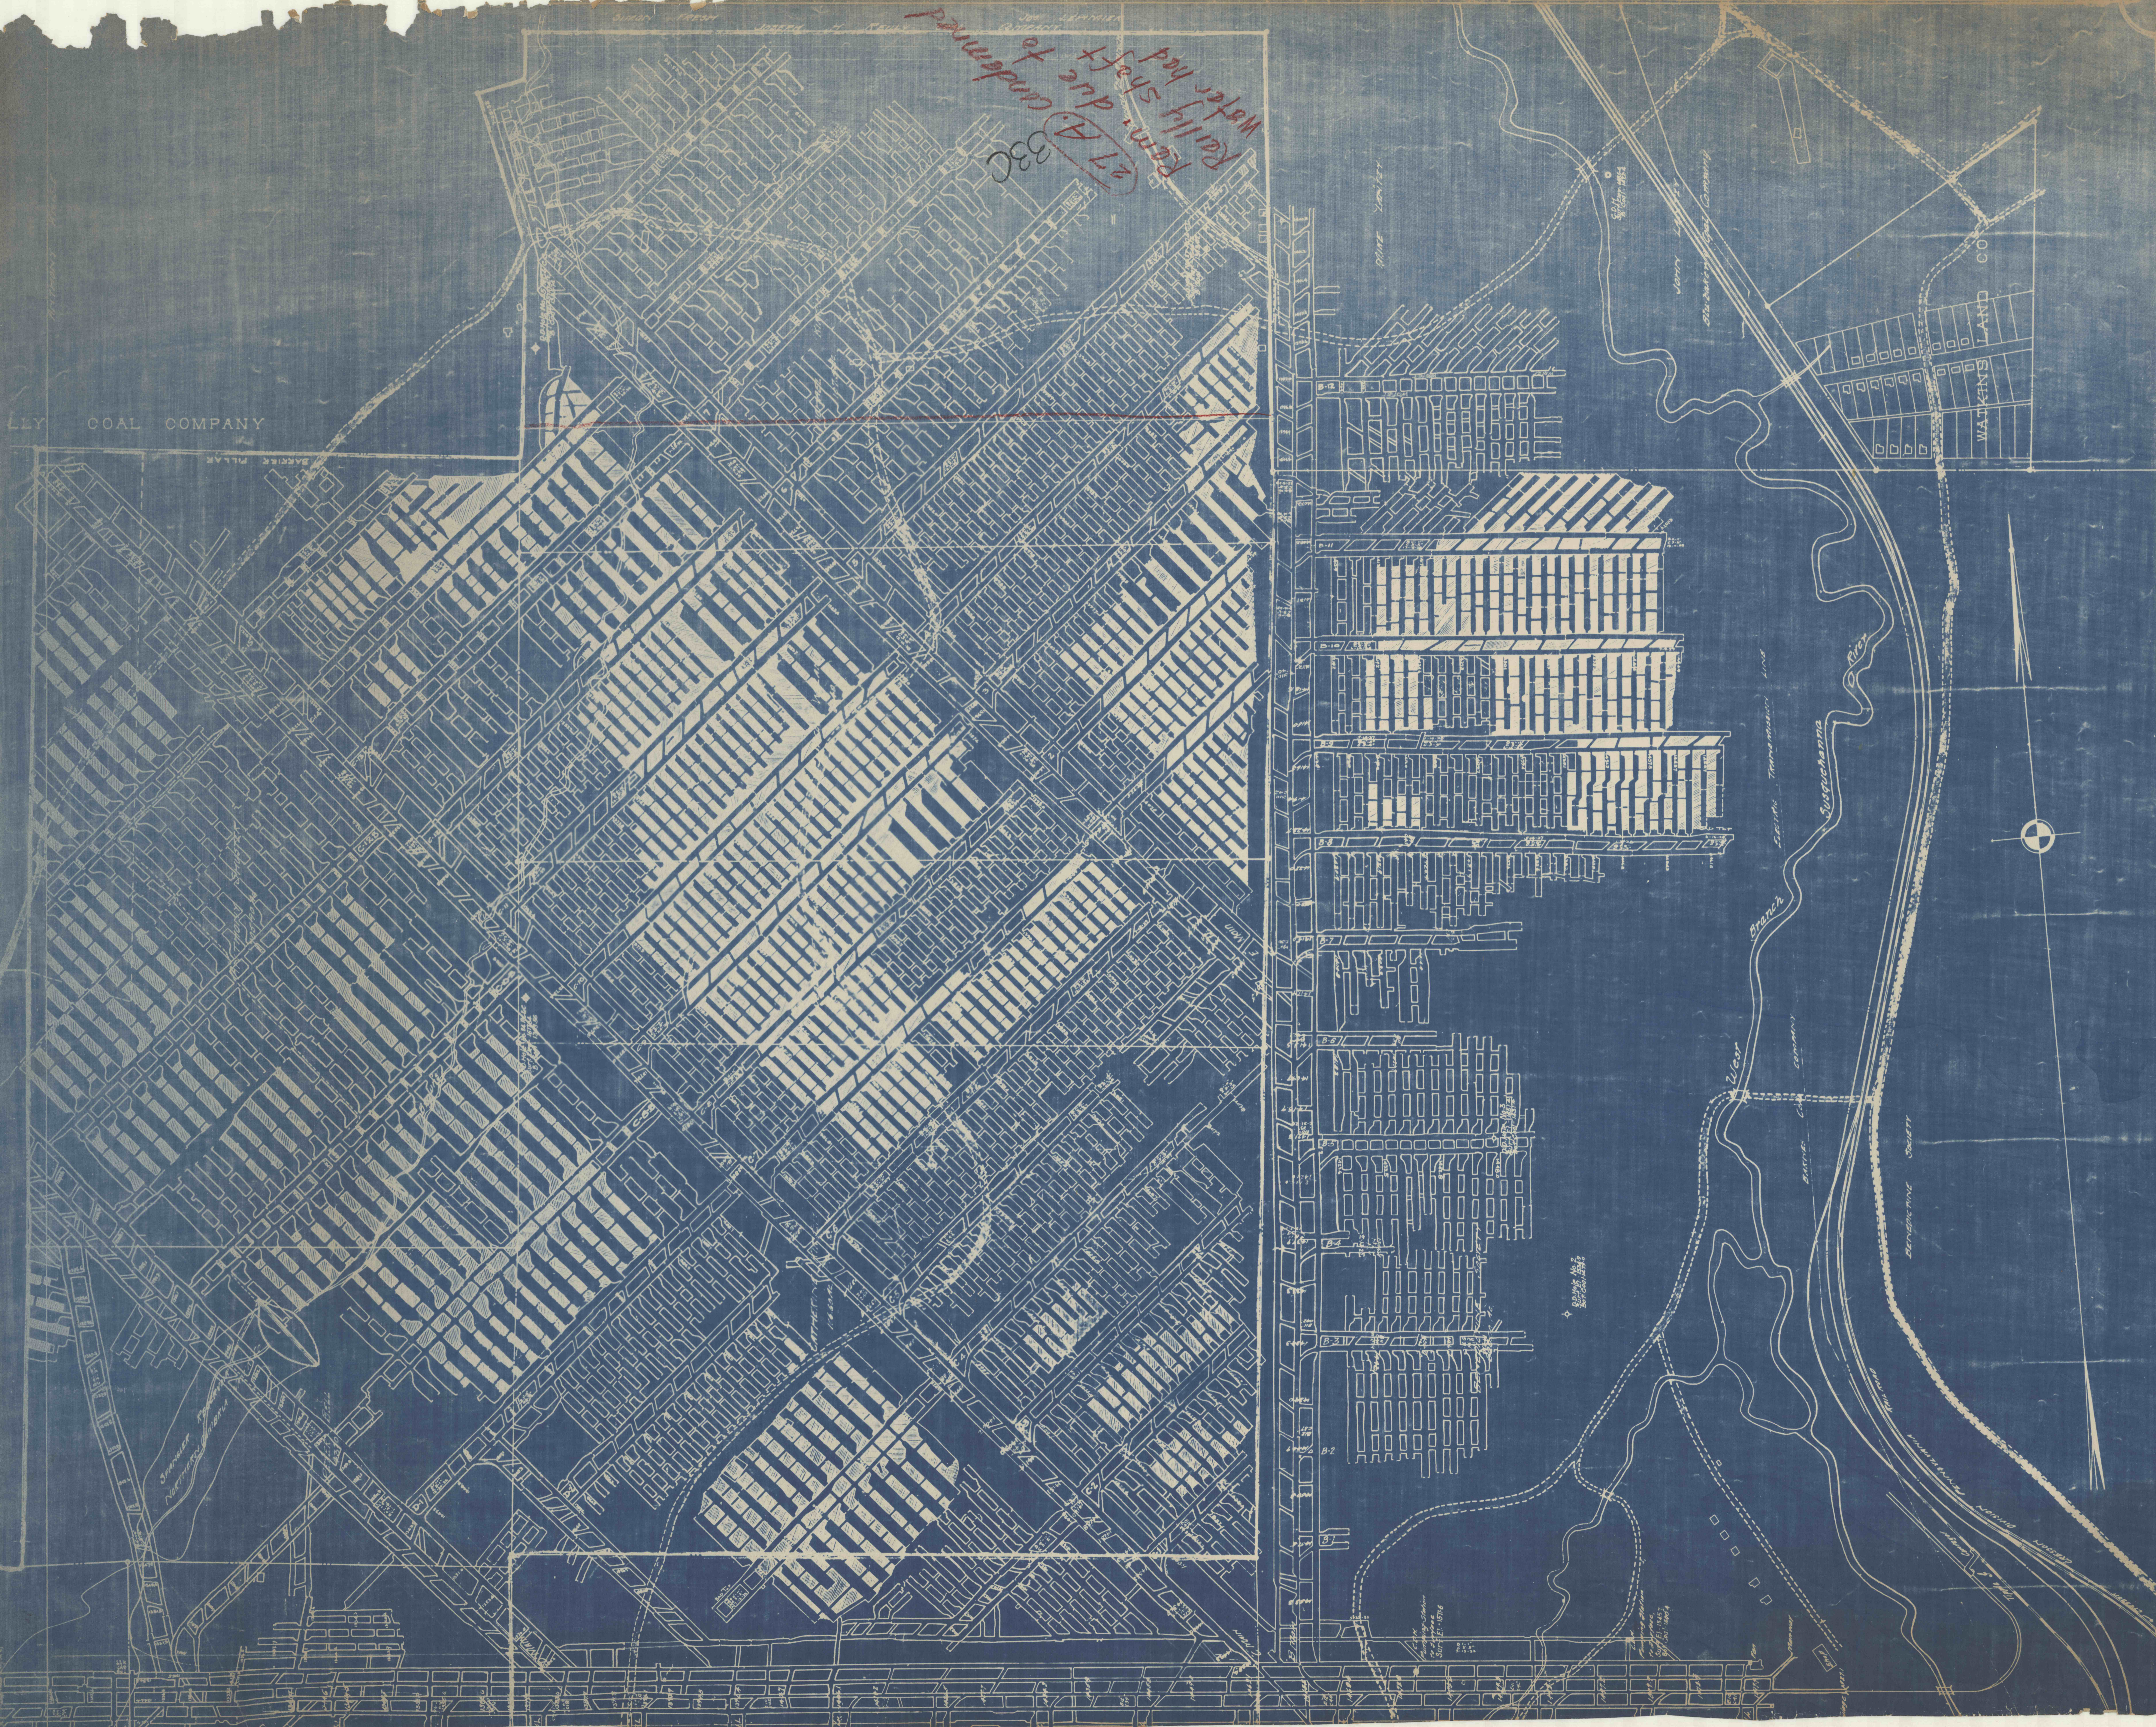




1-11-1918
SUN-11-1918