

Joseph Rhea
Edri Coal Co Leases.

Coal of the Saltsburg Coal Company

MINE MAP OF THE CONEMAUGH COAL CO.


SALTSBURG PA.

Scale-1 Inch=100 Feet

Albert Smith
Engineer.

July 16th 1904
Nov. 2nd 1904
Jan. 27th 1905
Aug. 6th 1905
Dec. 8th 1905

NOTE
ELEVATIONS ON RAIL IN E-3

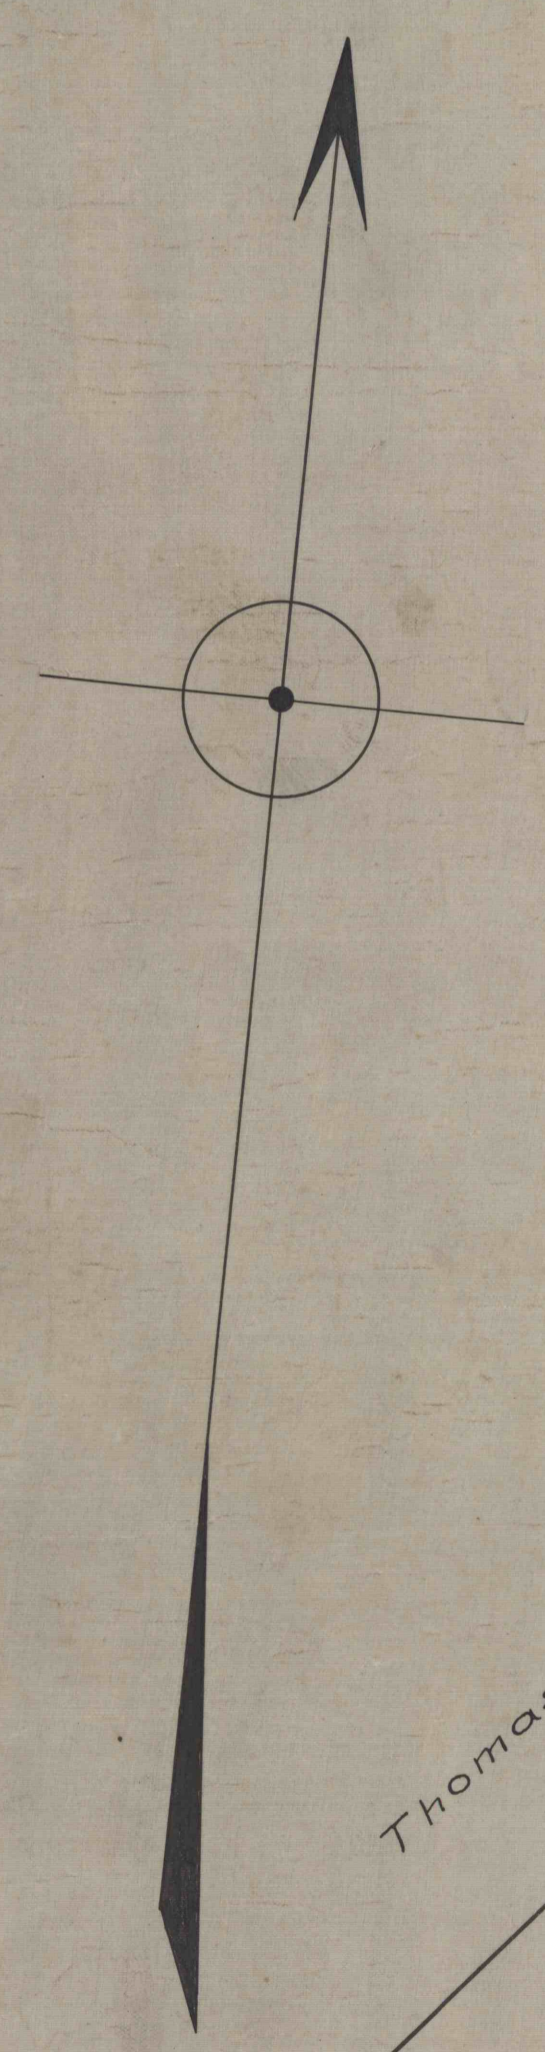

Lands of Conemaugh Coal Co.