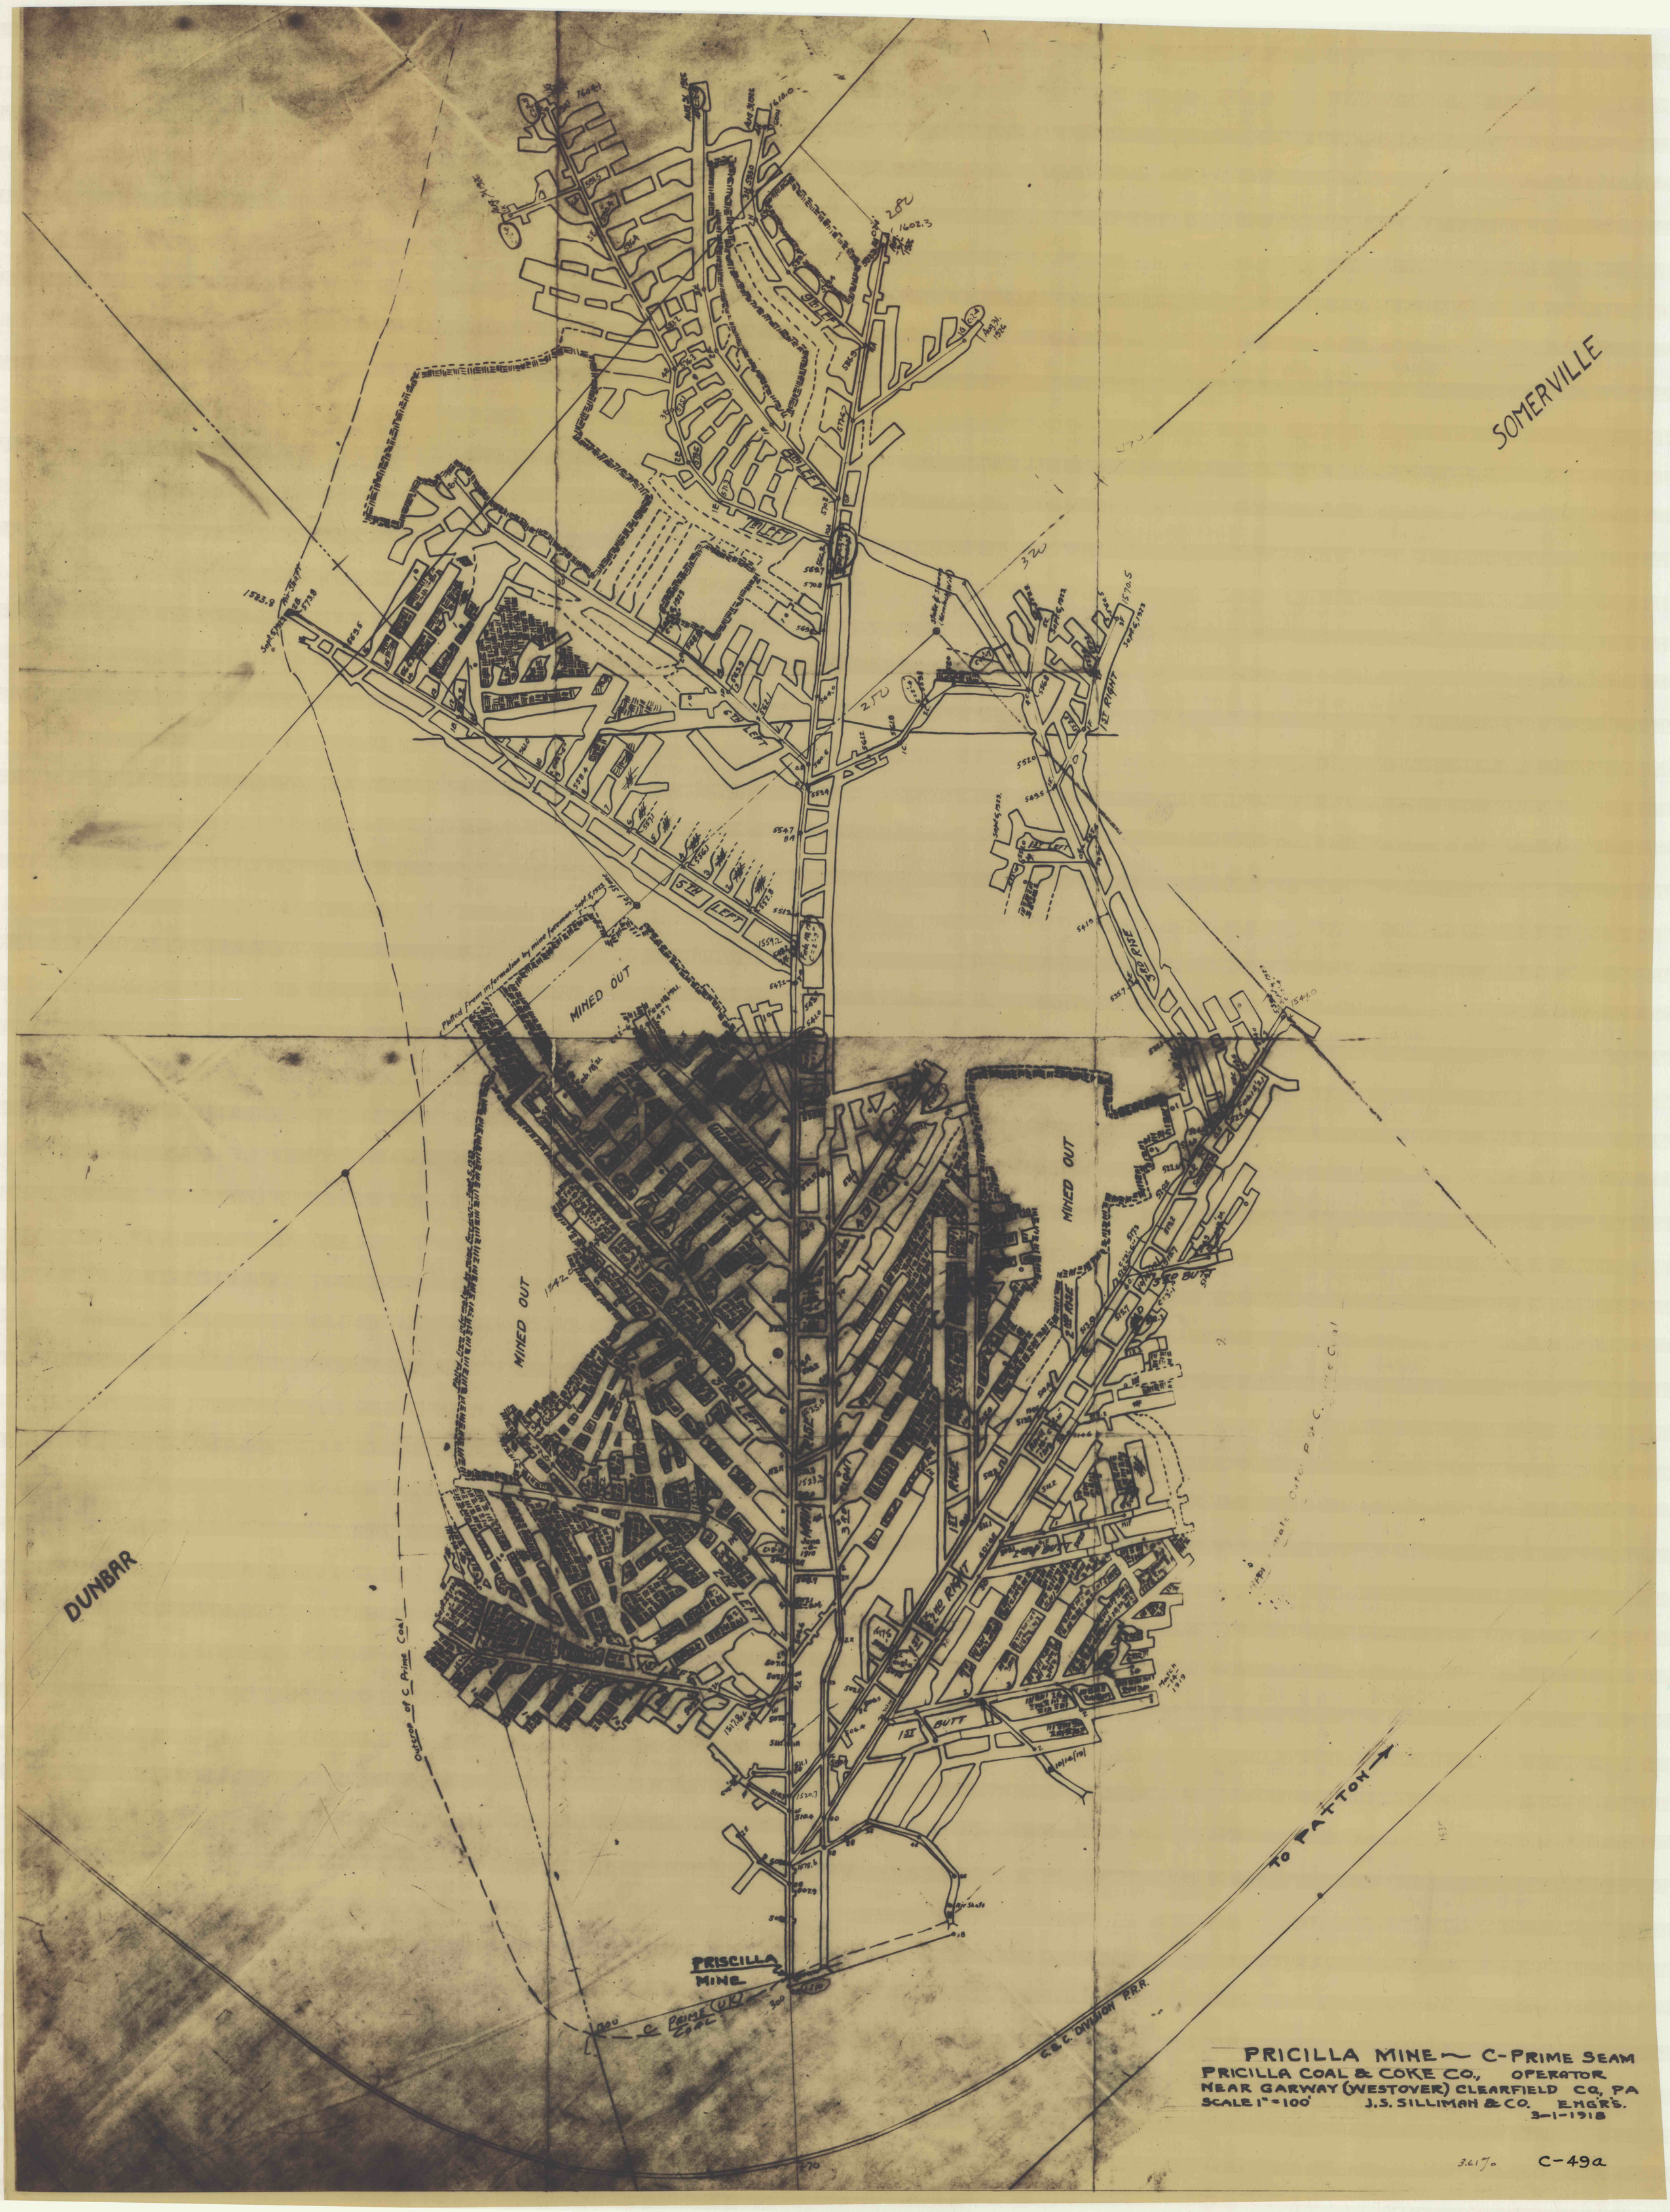
SOMERVILLE
DUNBAR
MINED OUT
MINED OUT
MINED OUT
Plotted from information by mine foreman Sept. 5, 1923
Outcrop of C Prime Coal
PRISCILLA MINE
C PRIME COAL
C. & C. DIVISION P.R.R.
TO PATTON
PRICILLA MINE ~ C-PRIME SEAM
PRICILLA COAL & COKE CO., OPERATOR
NEAR GARWAY (WESTOVER) CLEARFIELD CO., PA
SCALE 1" = 100'
J.S. SILLIMAN & CO. ENG'RS.
3-1-1918
C-49a