


SOMERVILLE

DUNBAR

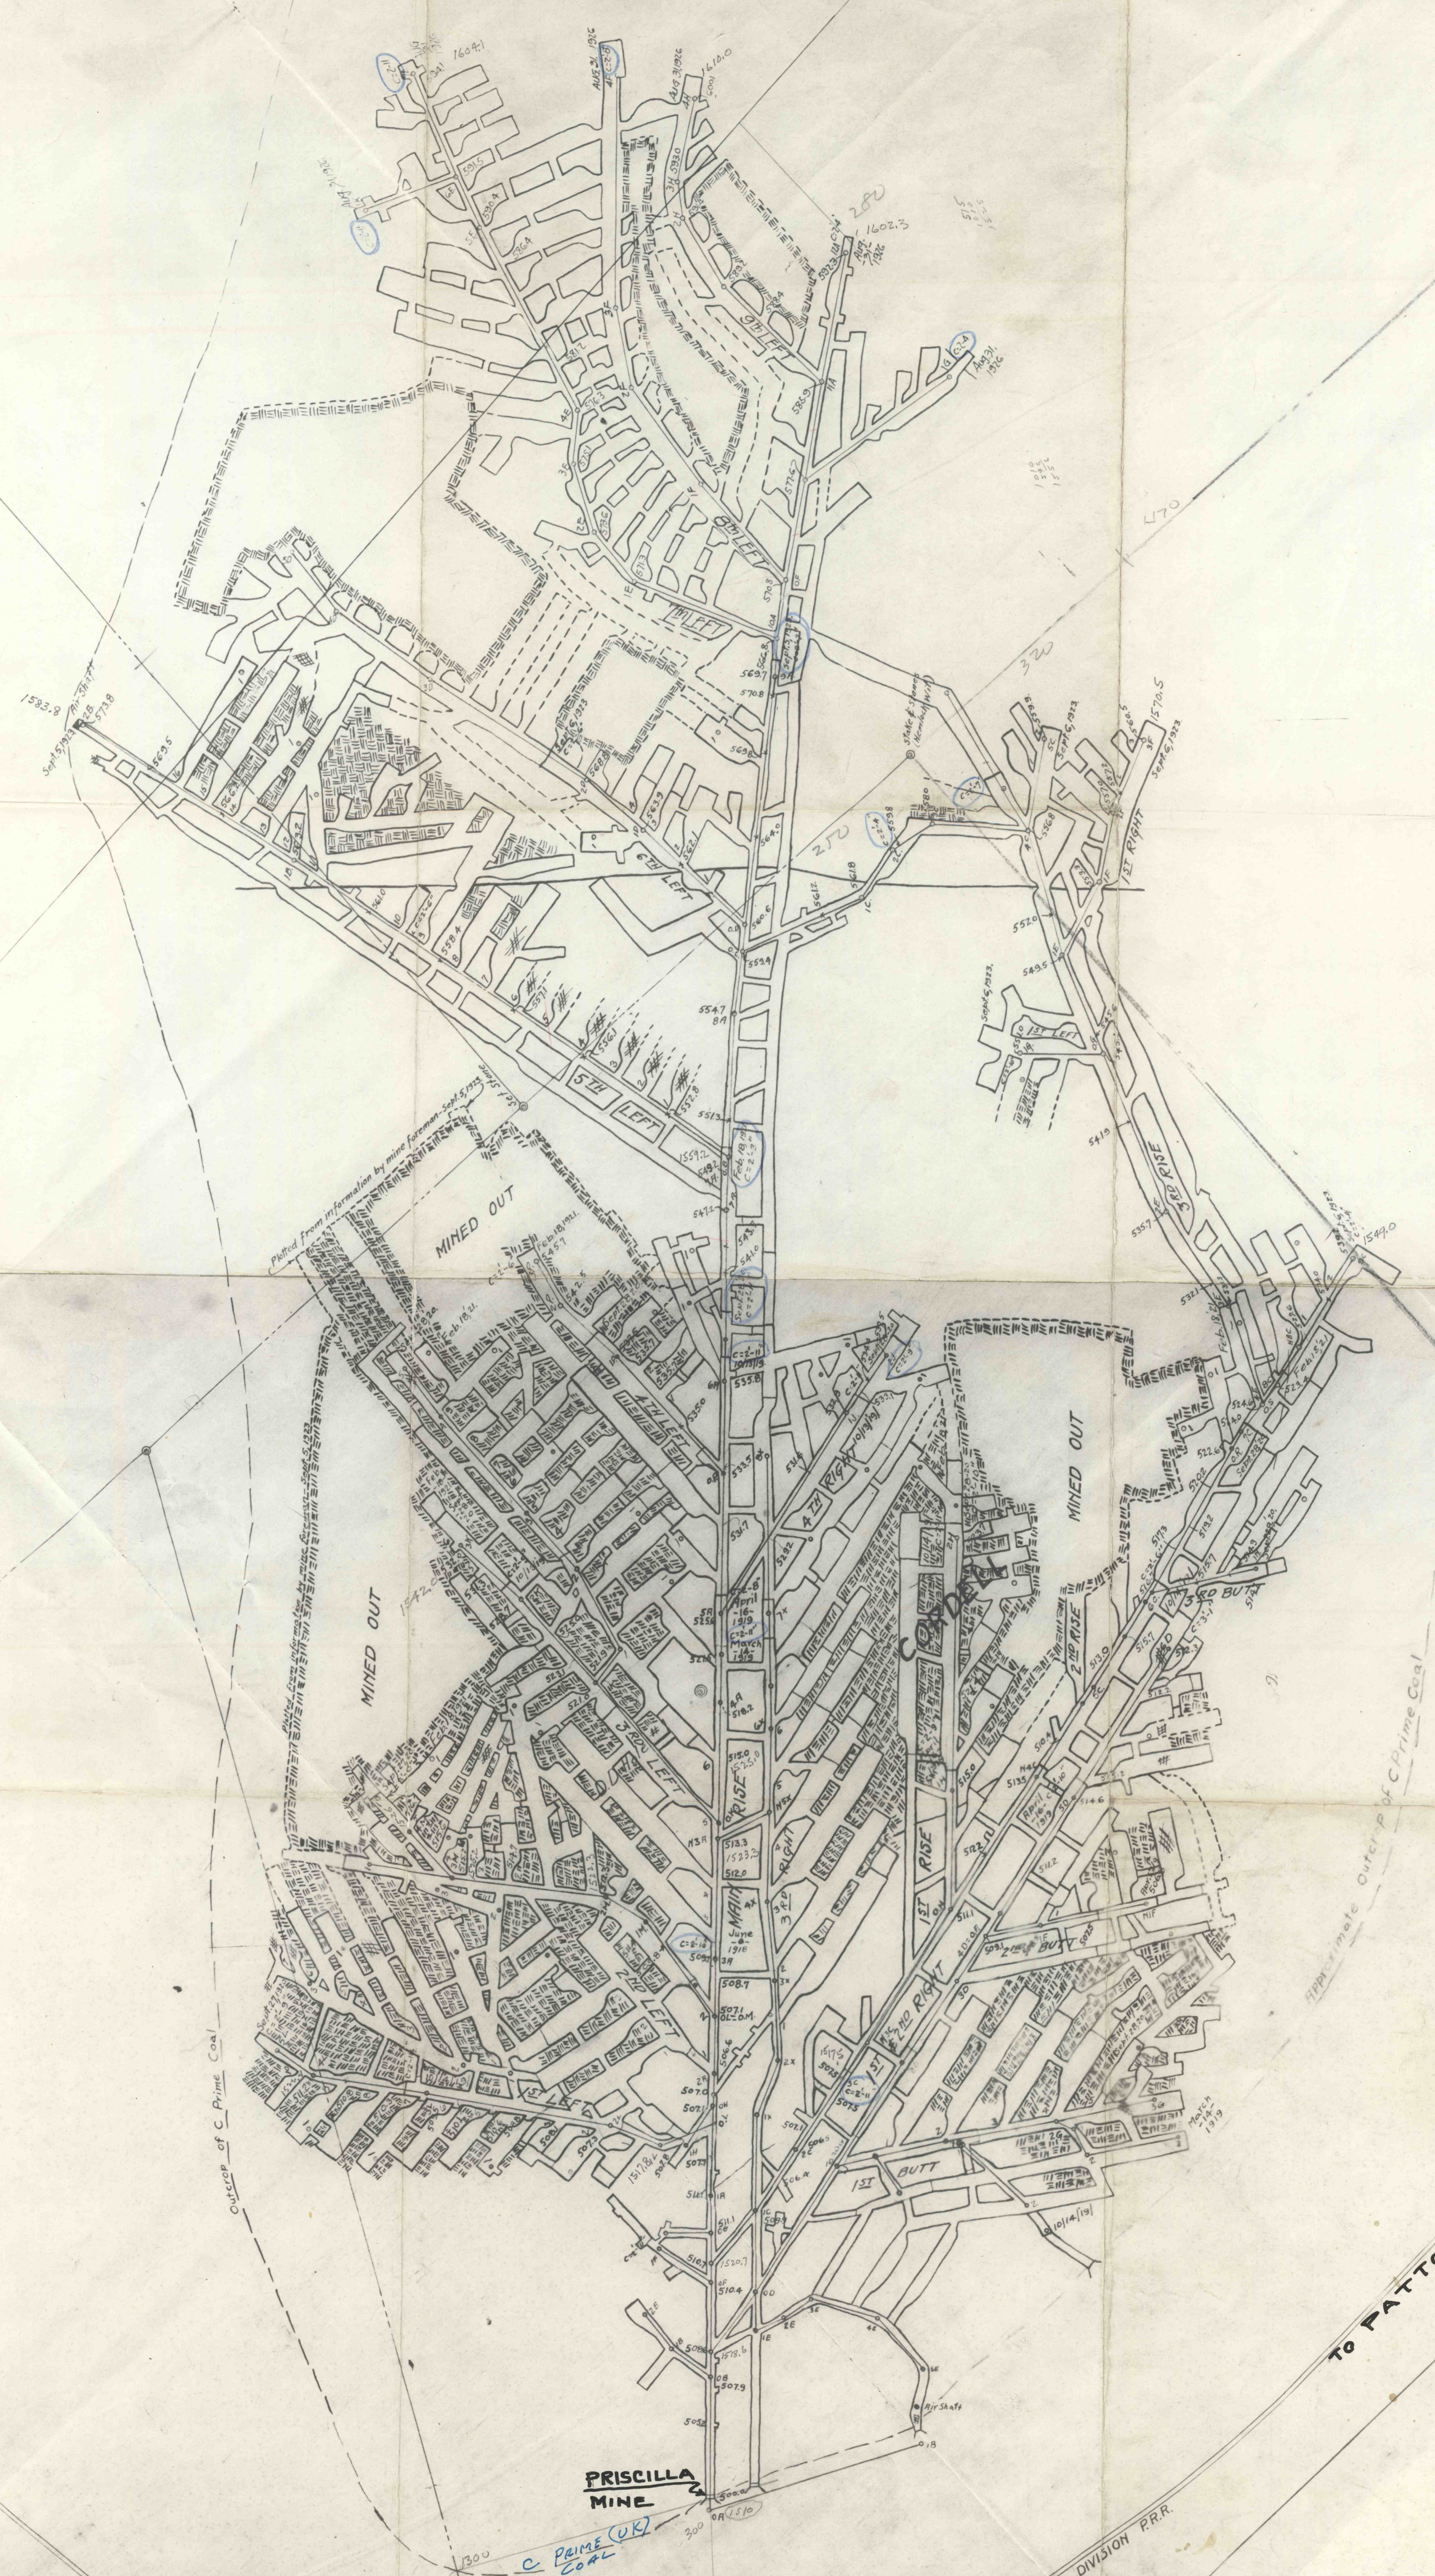

PRISCILLA MINE ~ C-PRIME SEAM  
 PRISCILLA COAL & COKE CO., OPERATOR  
 NEAR GARWAY (WESTOVER) CLEARFIELD CO., PA  
 SCALE 1"=100' J.S. SILLIMAN & CO. ENGRS.  
 3-1-1918

TO PATTON