


D.D. Hole No. 112
 BOT. "B" - 1519.81
 BOT. "A" - 1523.77

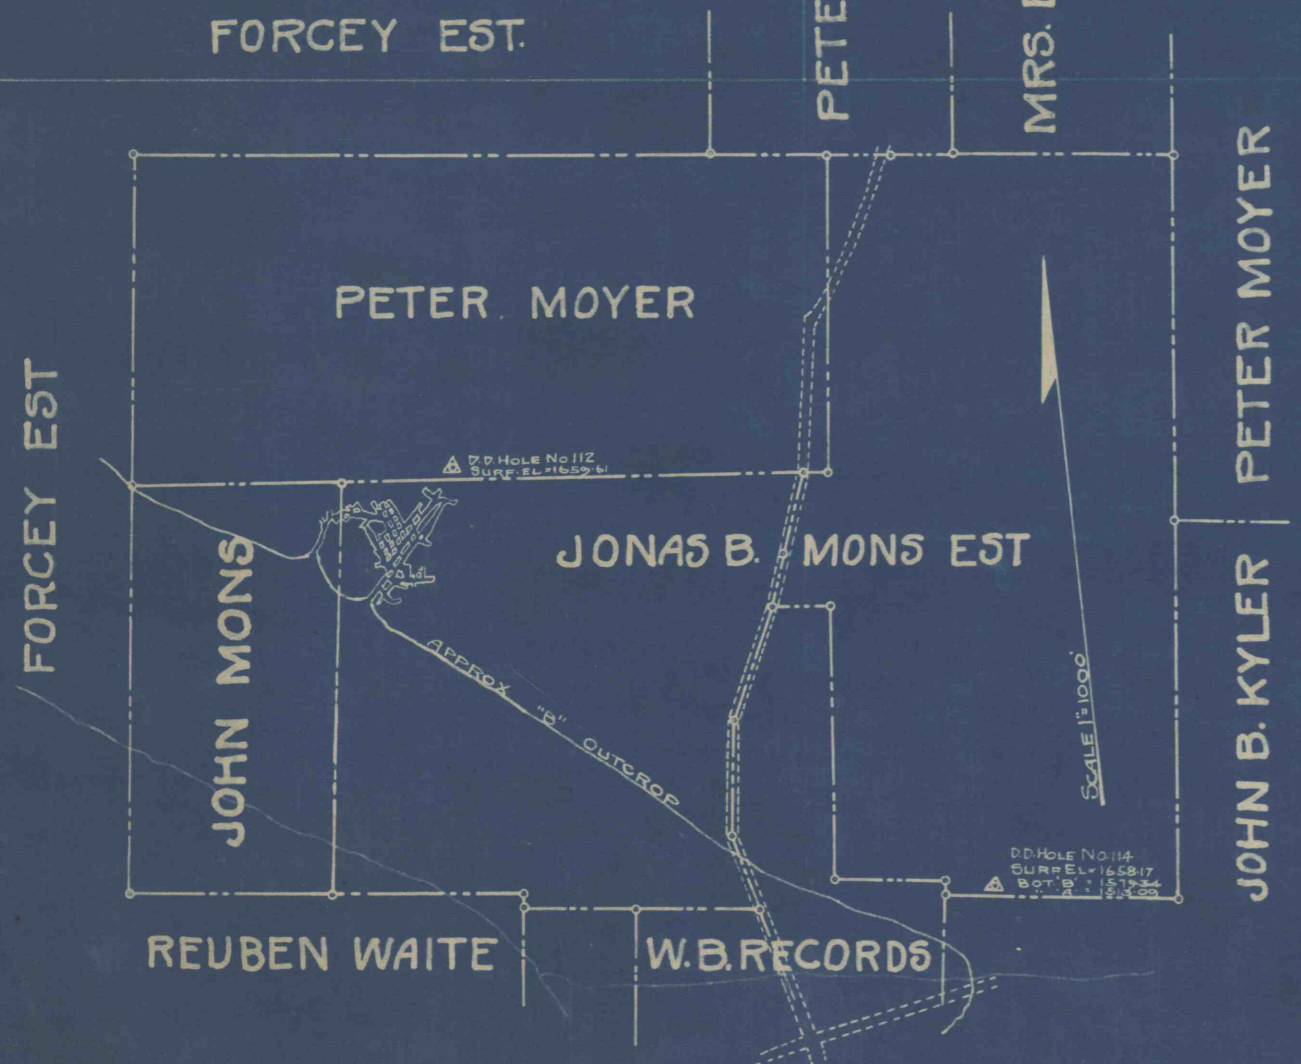

- ENCROACHMENT 6-1-17 - 521 GR. TONS
 - " 2-15-19 - 137 GR. TONS
 - " 4-1-20 - 36 GR. TONS
 - " 11-23-20 - 247 GR. TONS
 - TOTAL 941 GR. TONS**
 - ENCROACHMENT 3-27-22 - 930 GR. TONS
 - Pillars Affected by Encroachment.
- Peter B. Mons*
- Harry Conway*

PENNSYLVANIA COAL & COKE CORPORATION
 PETER B MONS
 COUNTRY MINE ENCROACHMENT
 IN THE "B" SEAM
 COOPER TWP. CLEARFIELD CO., PA.

ENGR DEPT PATTON PA. DATE 1-20-21
 DRAWN BY HLG SCALE 1"=100'
 TRACED BY JCM REVISED _____
 CHECKED BY _____
 APPROVED _____

SHEET _____
 SHEET NO. DRAWING NO. **P 632**