

E  
W

JOHN GATES TR.

TO ST. LAWRENCE

TO PATTON  
PUBLIC HIGHWAY  
(These Lines along the Road are put on from Deed Descriptions)

buildings  
(to be down)

(put on from Deed)

DAN WARNER TR.

DAN WARNER TR.


(put on from Deed)

stone cor.  
(located by us)

stone cor.  
(located by us)

HENRY SMOPE TR.  
(put on from Deed)

"C" PRIME OUTCROP

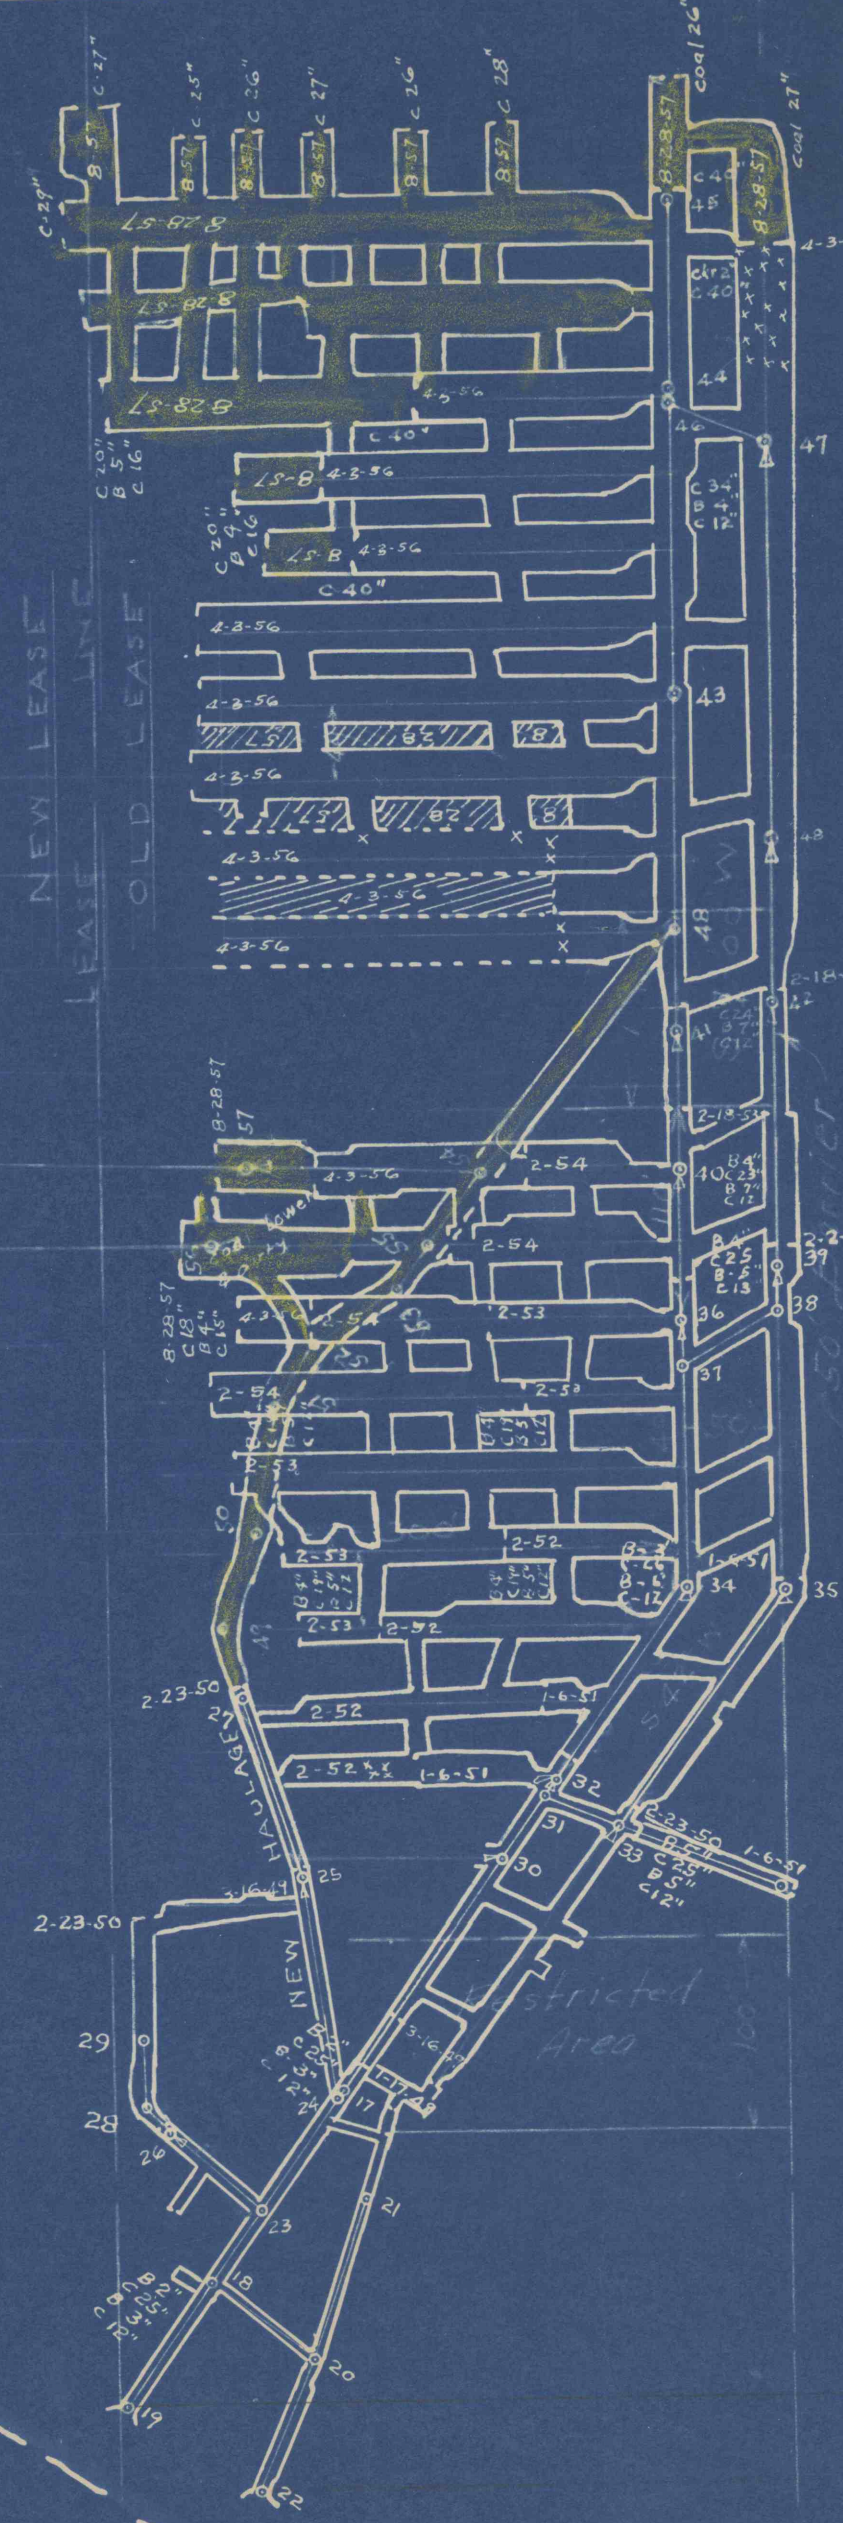

**DISCLAIMER:** This map is provided as a courtesy to the Pennsylvania Bureau of Deep Mine Safety by American Premier Underwriters, Inc. (fka The Penn Central Corporation) and its subsidiary United Railroad Corp., which own or owned, but do not operate, the coal assets depicted herein.  
American Premier Underwriters, Inc. and United Railroad Corp. disclaim any representation or duty to any person as to the accuracy or completeness of this map or its fitness for any particular mining, safety or real estate related purpose. Any person who uses this map for any reason undertakes an independent duty to verify its accuracy and completeness. American Premier Underwriters, Inc., United Railroad Corp. and their respective affiliates, shareholders, directors, officers and employees harmless from damage or liability arising from its use.

MAP OF  
WILLIAM WARNER TRACT  
CHEST TWP CAMBRIA CO. PA.  
SHOWING  
"C" PRIME MINE  
OPERATED BY - R. J. BECKER  
JAMES LYNN & JOSEPH PLOUCHA  
JAN. 1949  
SCALE 1"=100'

J. Heister, Engr.  
Martin C. Kirsch, Engr.

Revised 9/17/57

JOHN WARNER TR.

SCHWAM

C-202

stone cor.  
(located by us)

stone cor.  
(located by us)