


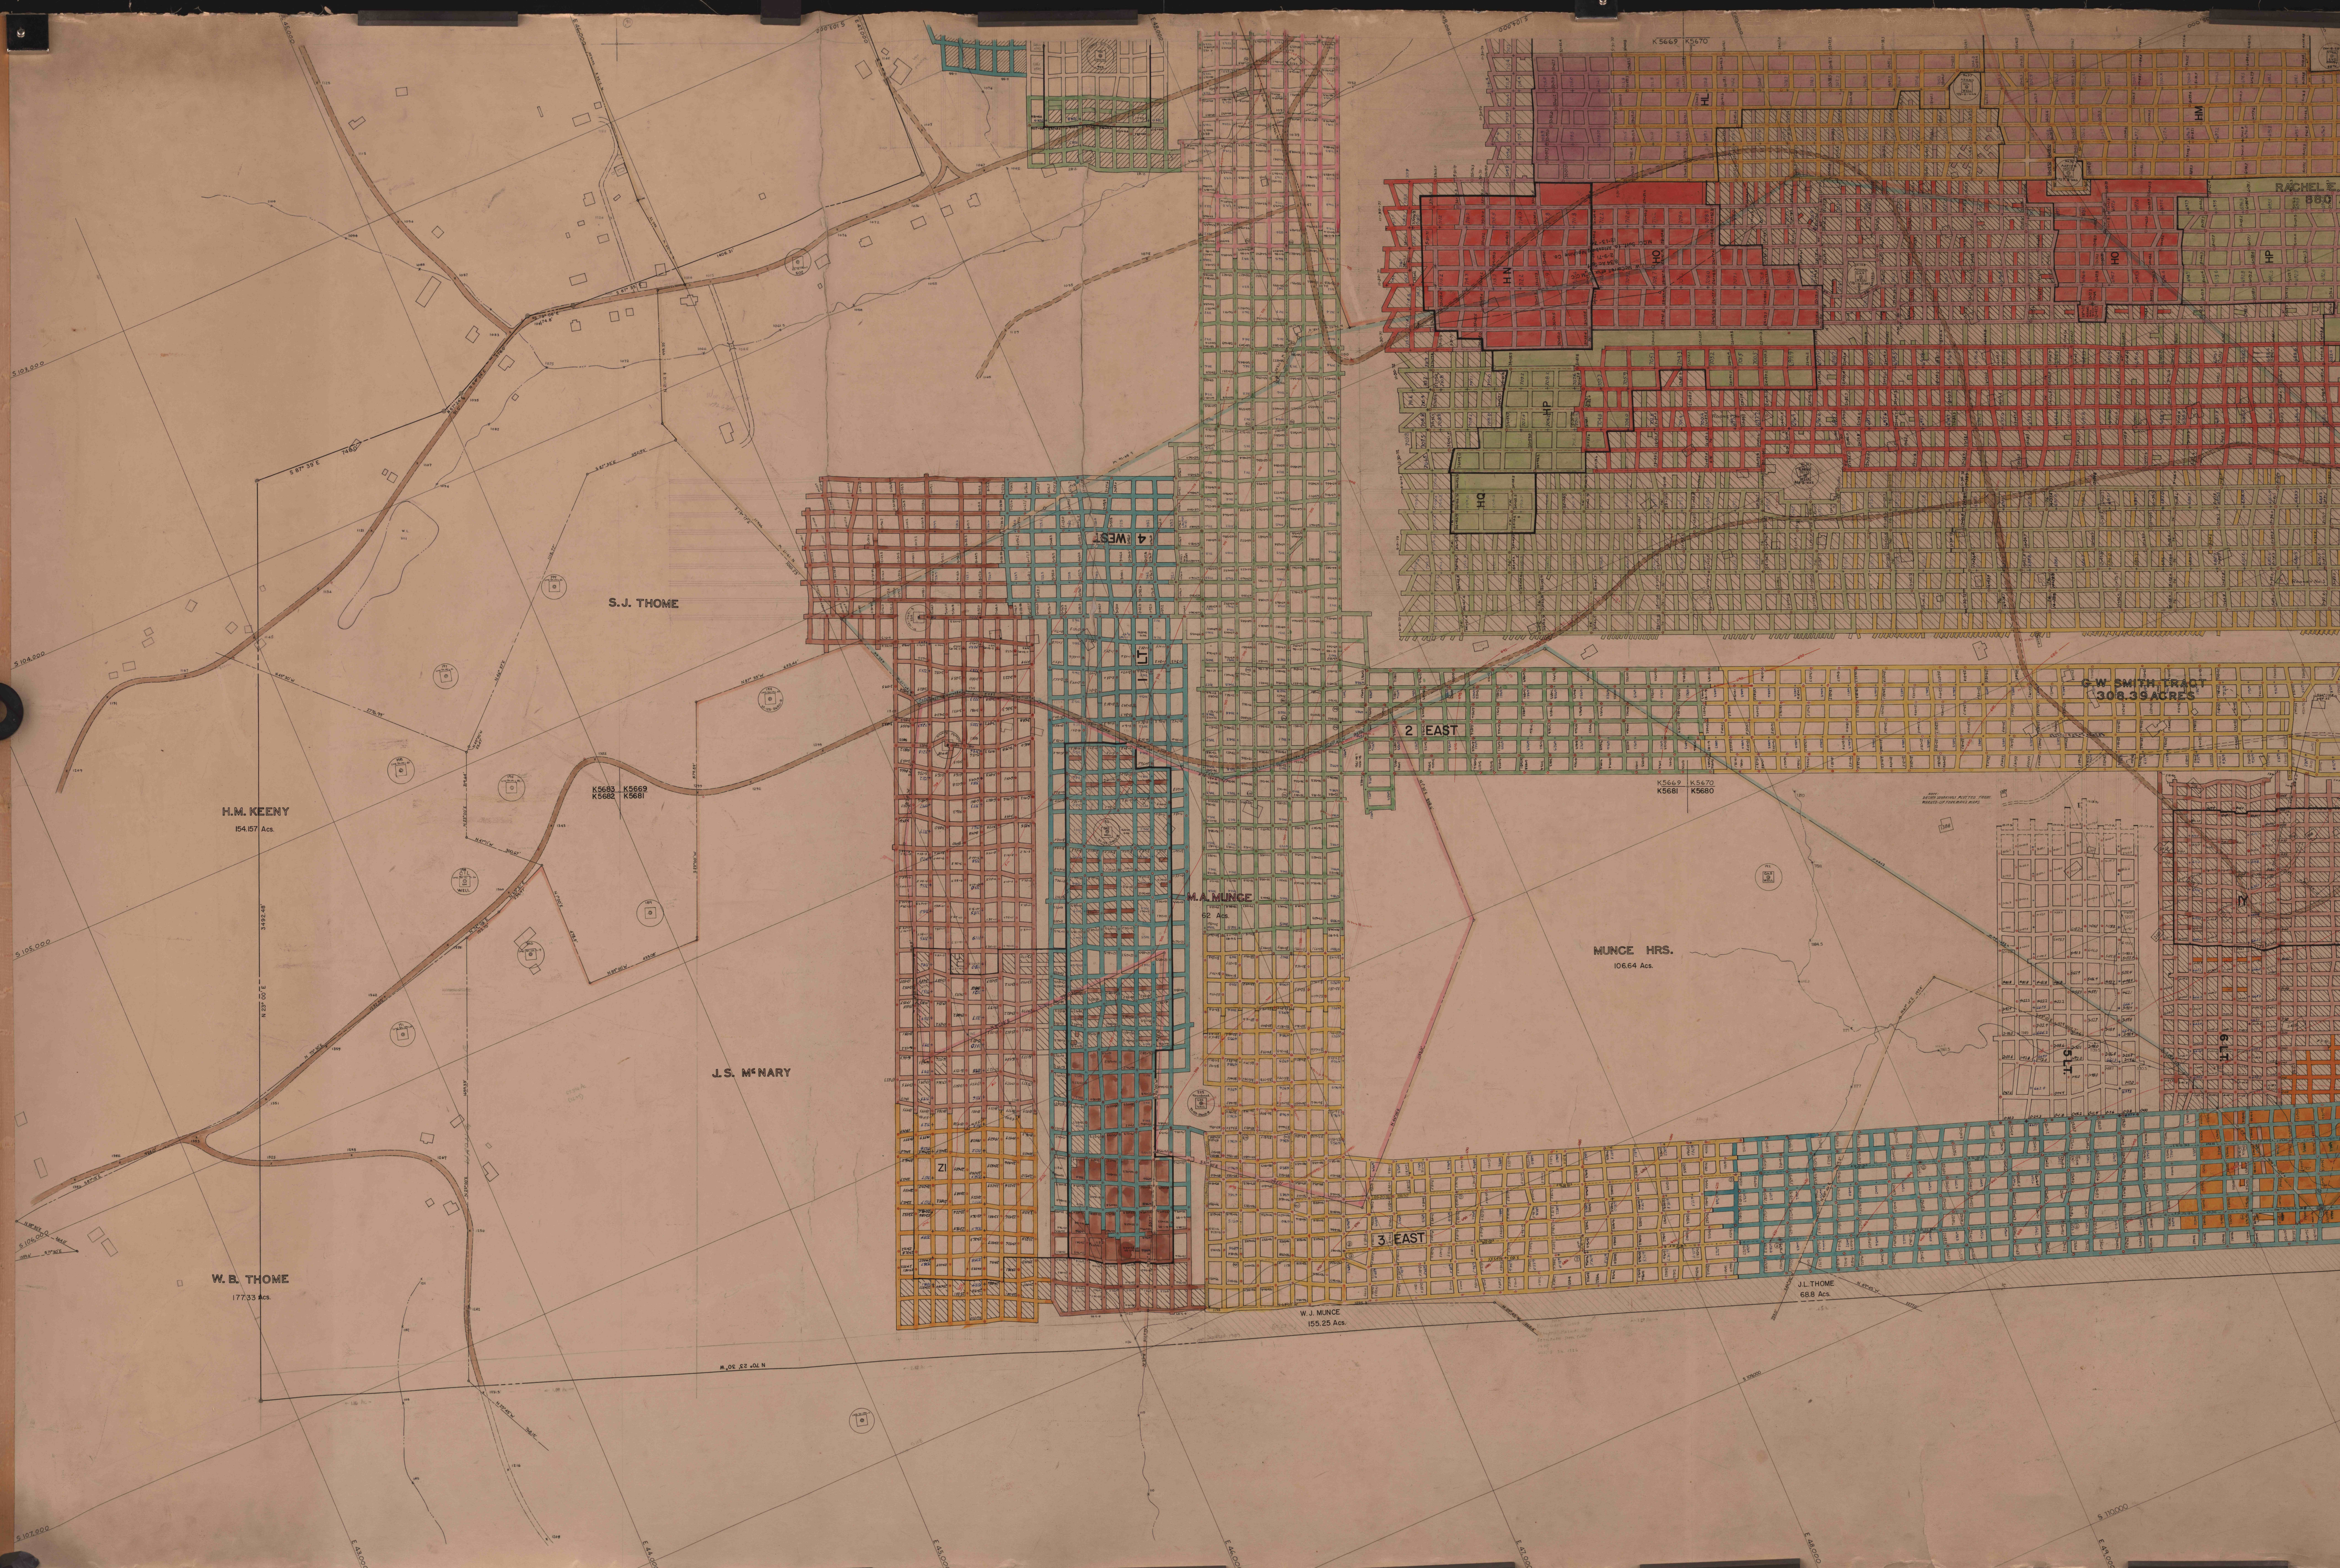

H.M. KEENEY
154.157 Acs.

S.J. THOME

K5683
K5682

K5669
K5681

J.S. McNARY

W.B. THOME
177.33 Acs.

M.A. MUNCE
52 Acs.

MUNCE HRS.
106.64 Acs.

W.J. MUNCE
155.25 Acs.

J.L. THOME
688 Acs.

G.W. SMITH TRACT
308.39 ACRES

RACHEL E.
880