


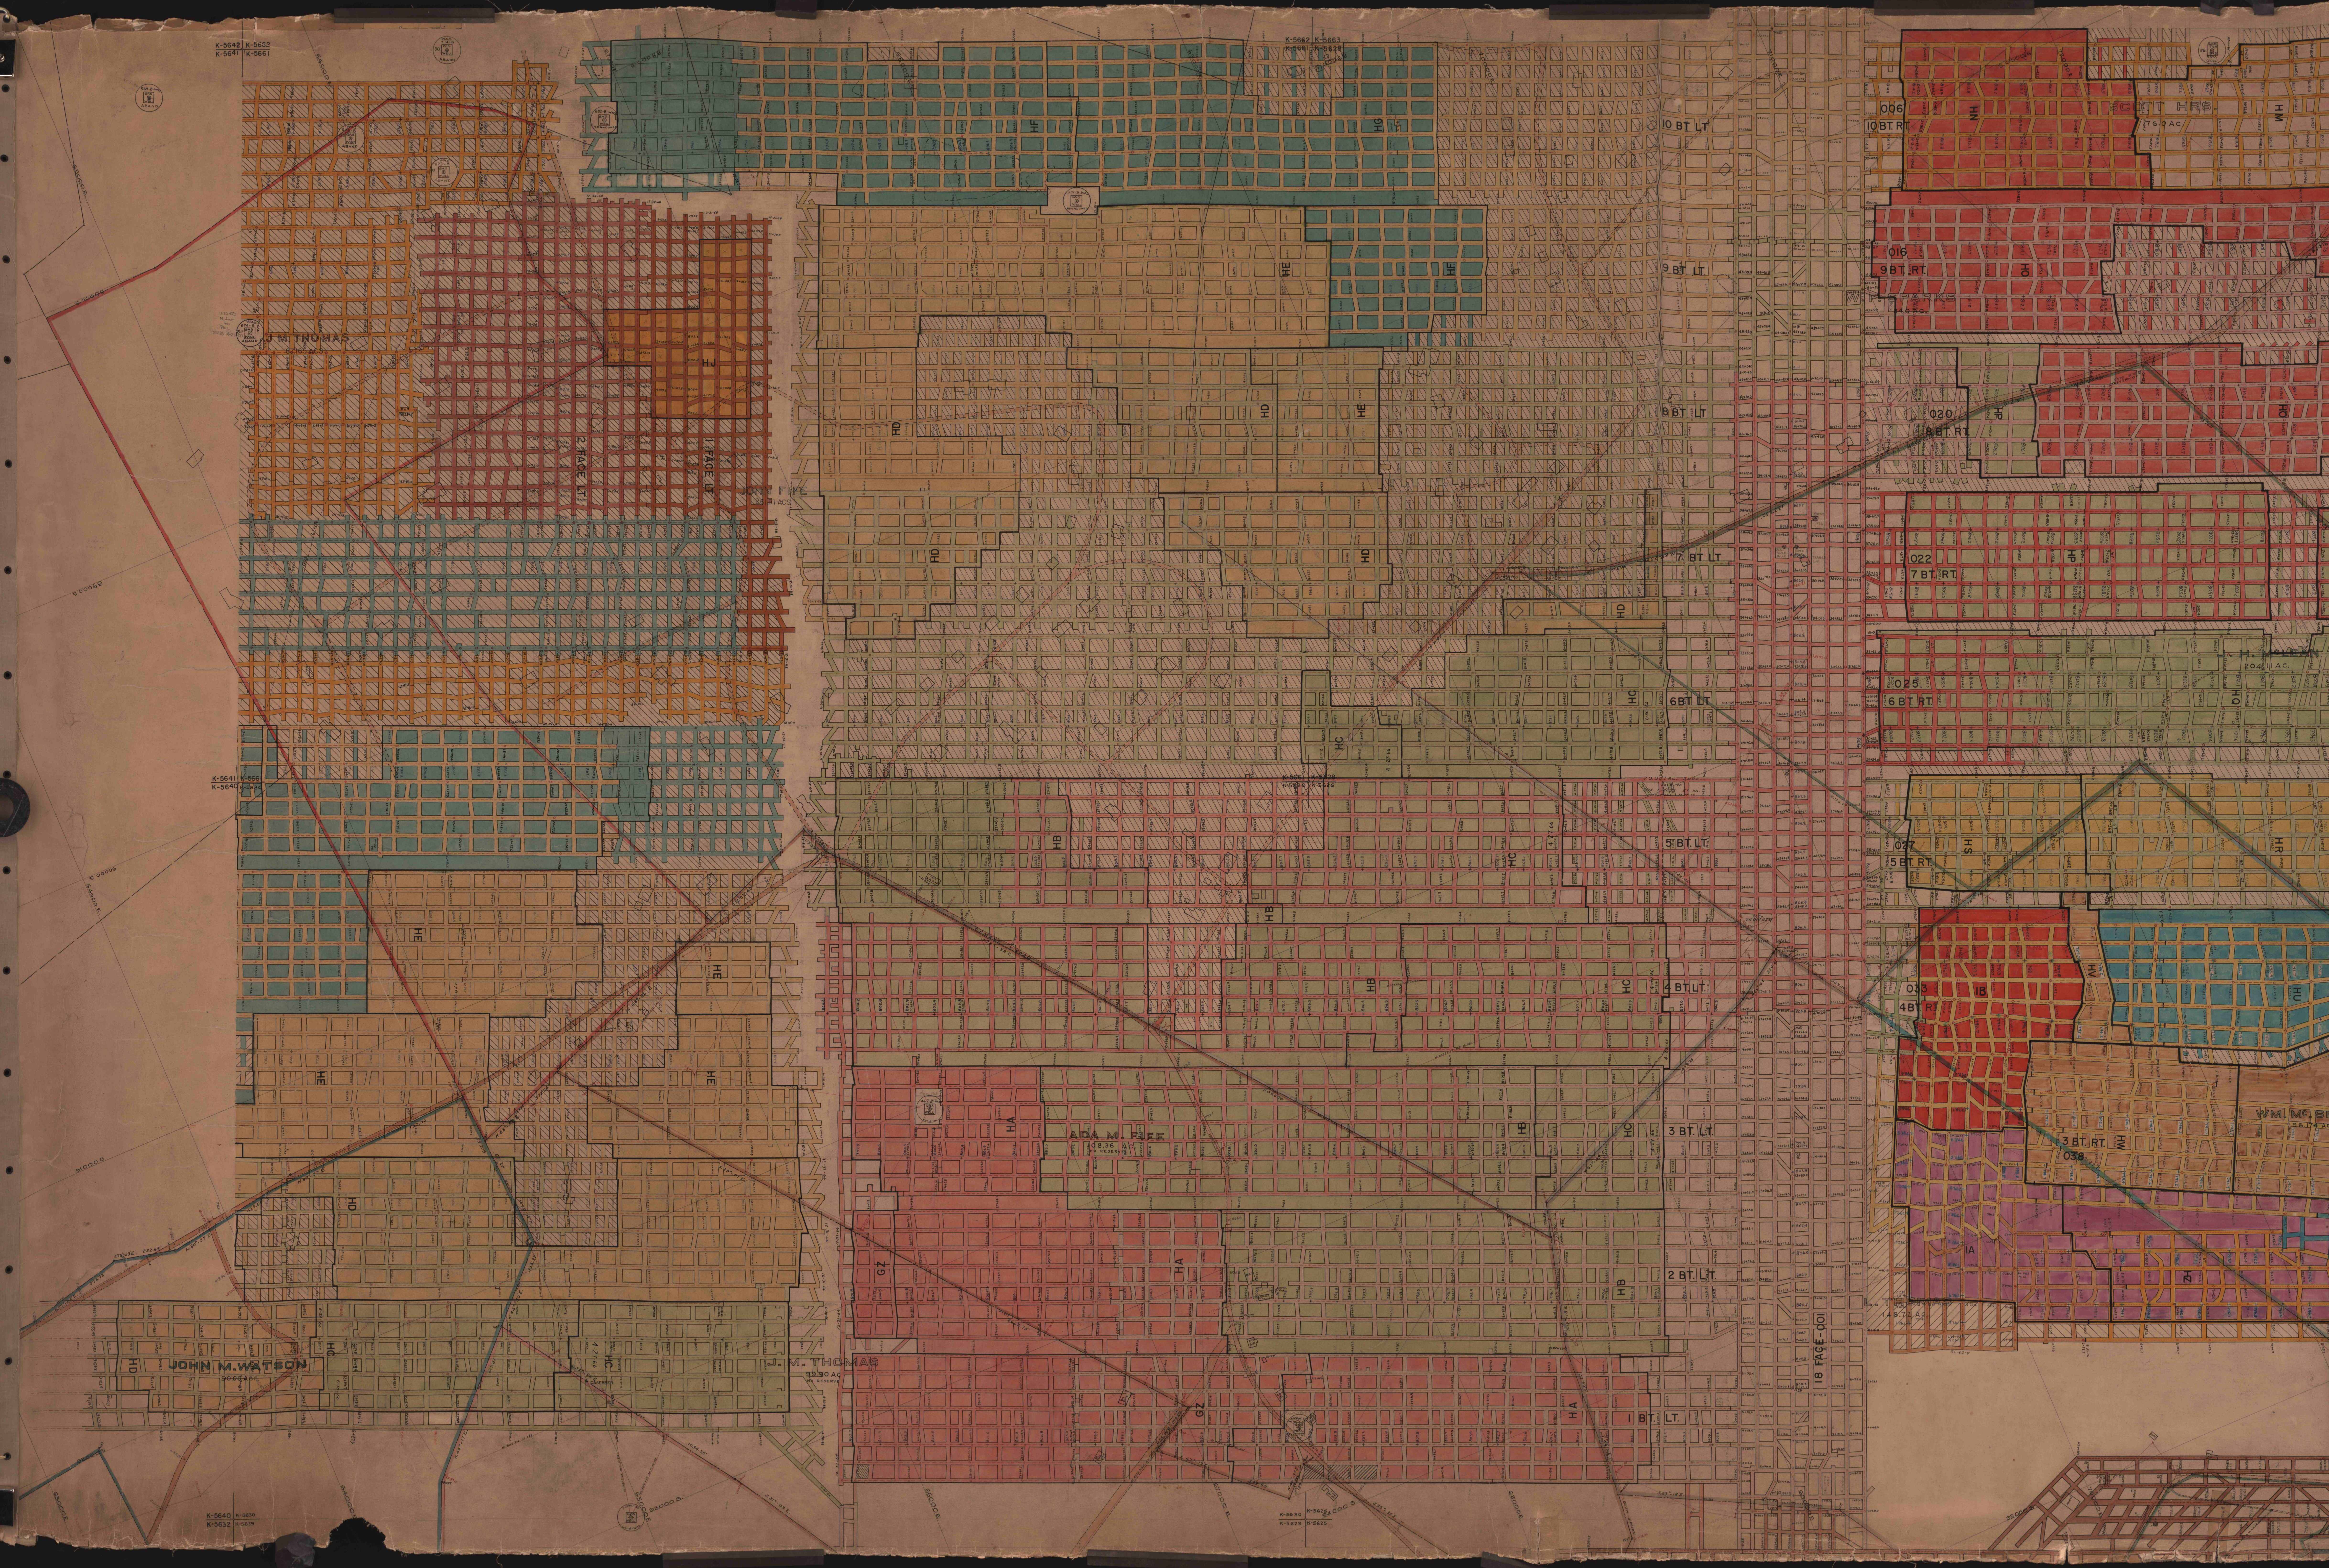

K-5642 K-5652
K-5641 K-5661

K-5652 K-5653
K-5651 K-5654

K-5641 K-5666
K-5640 K-5640

K-5640 K-5650
K-5632 K-5639

K-5630 K-5630
K-5629 K-5629

J. M. THOMAS

JOHN M. WATSON

J. M. THOMAS

ADA M. H...

WM. M. F...



10 BT LT

9 BT LT

8 BT LT

7 BT LT

6 BT LT

5 BT LT

4 BT LT

3 BT LT

2 BT LT

1 BT LT

10 BT RT

9 BT RT

8 BT RT

7 BT RT

6 BT RT

5 BT RT

4 BT RT

3 BT RT

2 BT RT

1 BT RT










