


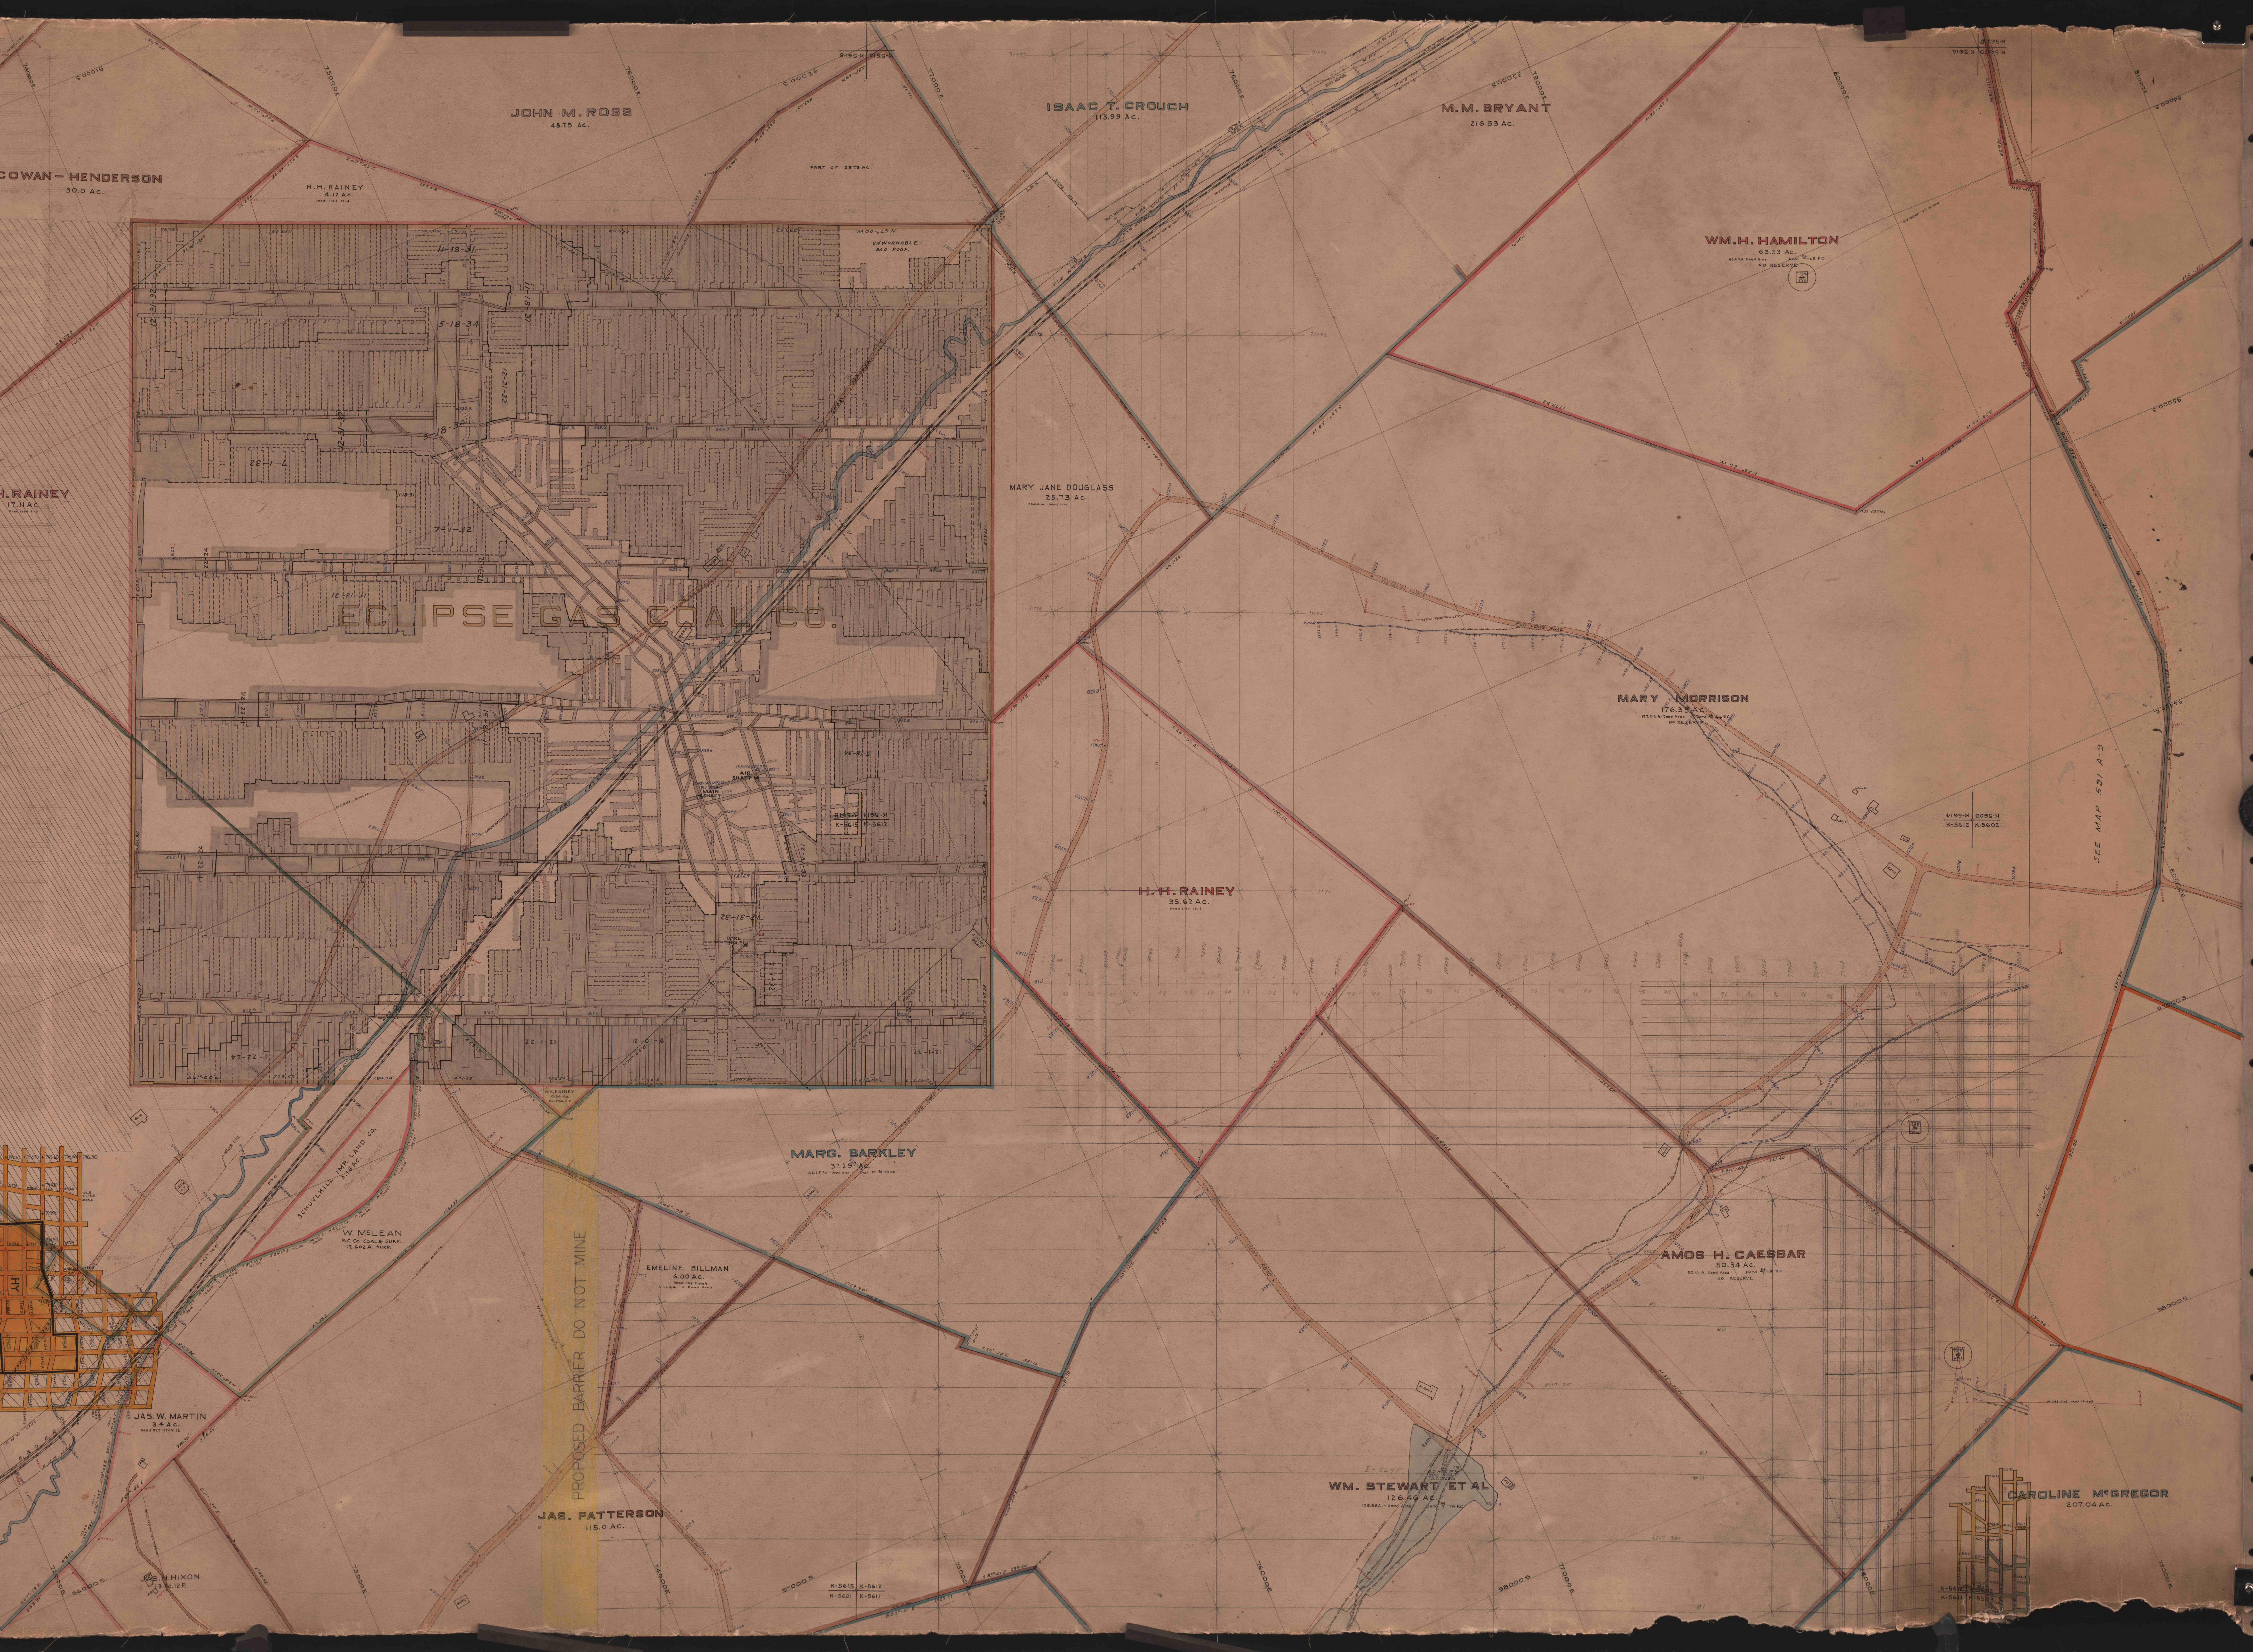

COWAN - HENDERSON
30.0 AC.

JOHN M. ROSS
48.75 AC.

ISAAC T. CROUCH
113.99 AC.

M.M. BRYANT
216.53 AC.

WM.H. HAMILTON
63.33 AC.
MADE THIS MINE
NO RESERVE

H. RAINEY
17.1 AC.

H.H. RAINEY
4.12 AC.

MARY JANE DOUGLASS
25.73 AC.

MARY MORRISON
176.33 AC.
MADE THIS MINE
NO RESERVE

H.H. RAINEY
35.62 AC.

MARG. BARKLEY
37.29 AC.

AMOS H. CAESBAR
50.34 AC.
MADE THIS MINE
NO RESERVE

WM. STEWART ET AL
126.46 AC.

CAROLINE MCGREGOR
207.04 AC.

JAS. PATTERSON
115.0 AC.

JAS. W. MARTIN
3.4 AC.

W. McLEAN
P.C. CO. COAL & SURF.
13,502 A. SURF.

EMELINE BILLMAN
6.00 AC.

PROPOSED BARRIER DO NOT MINE

SEE MAP 531 A-9