


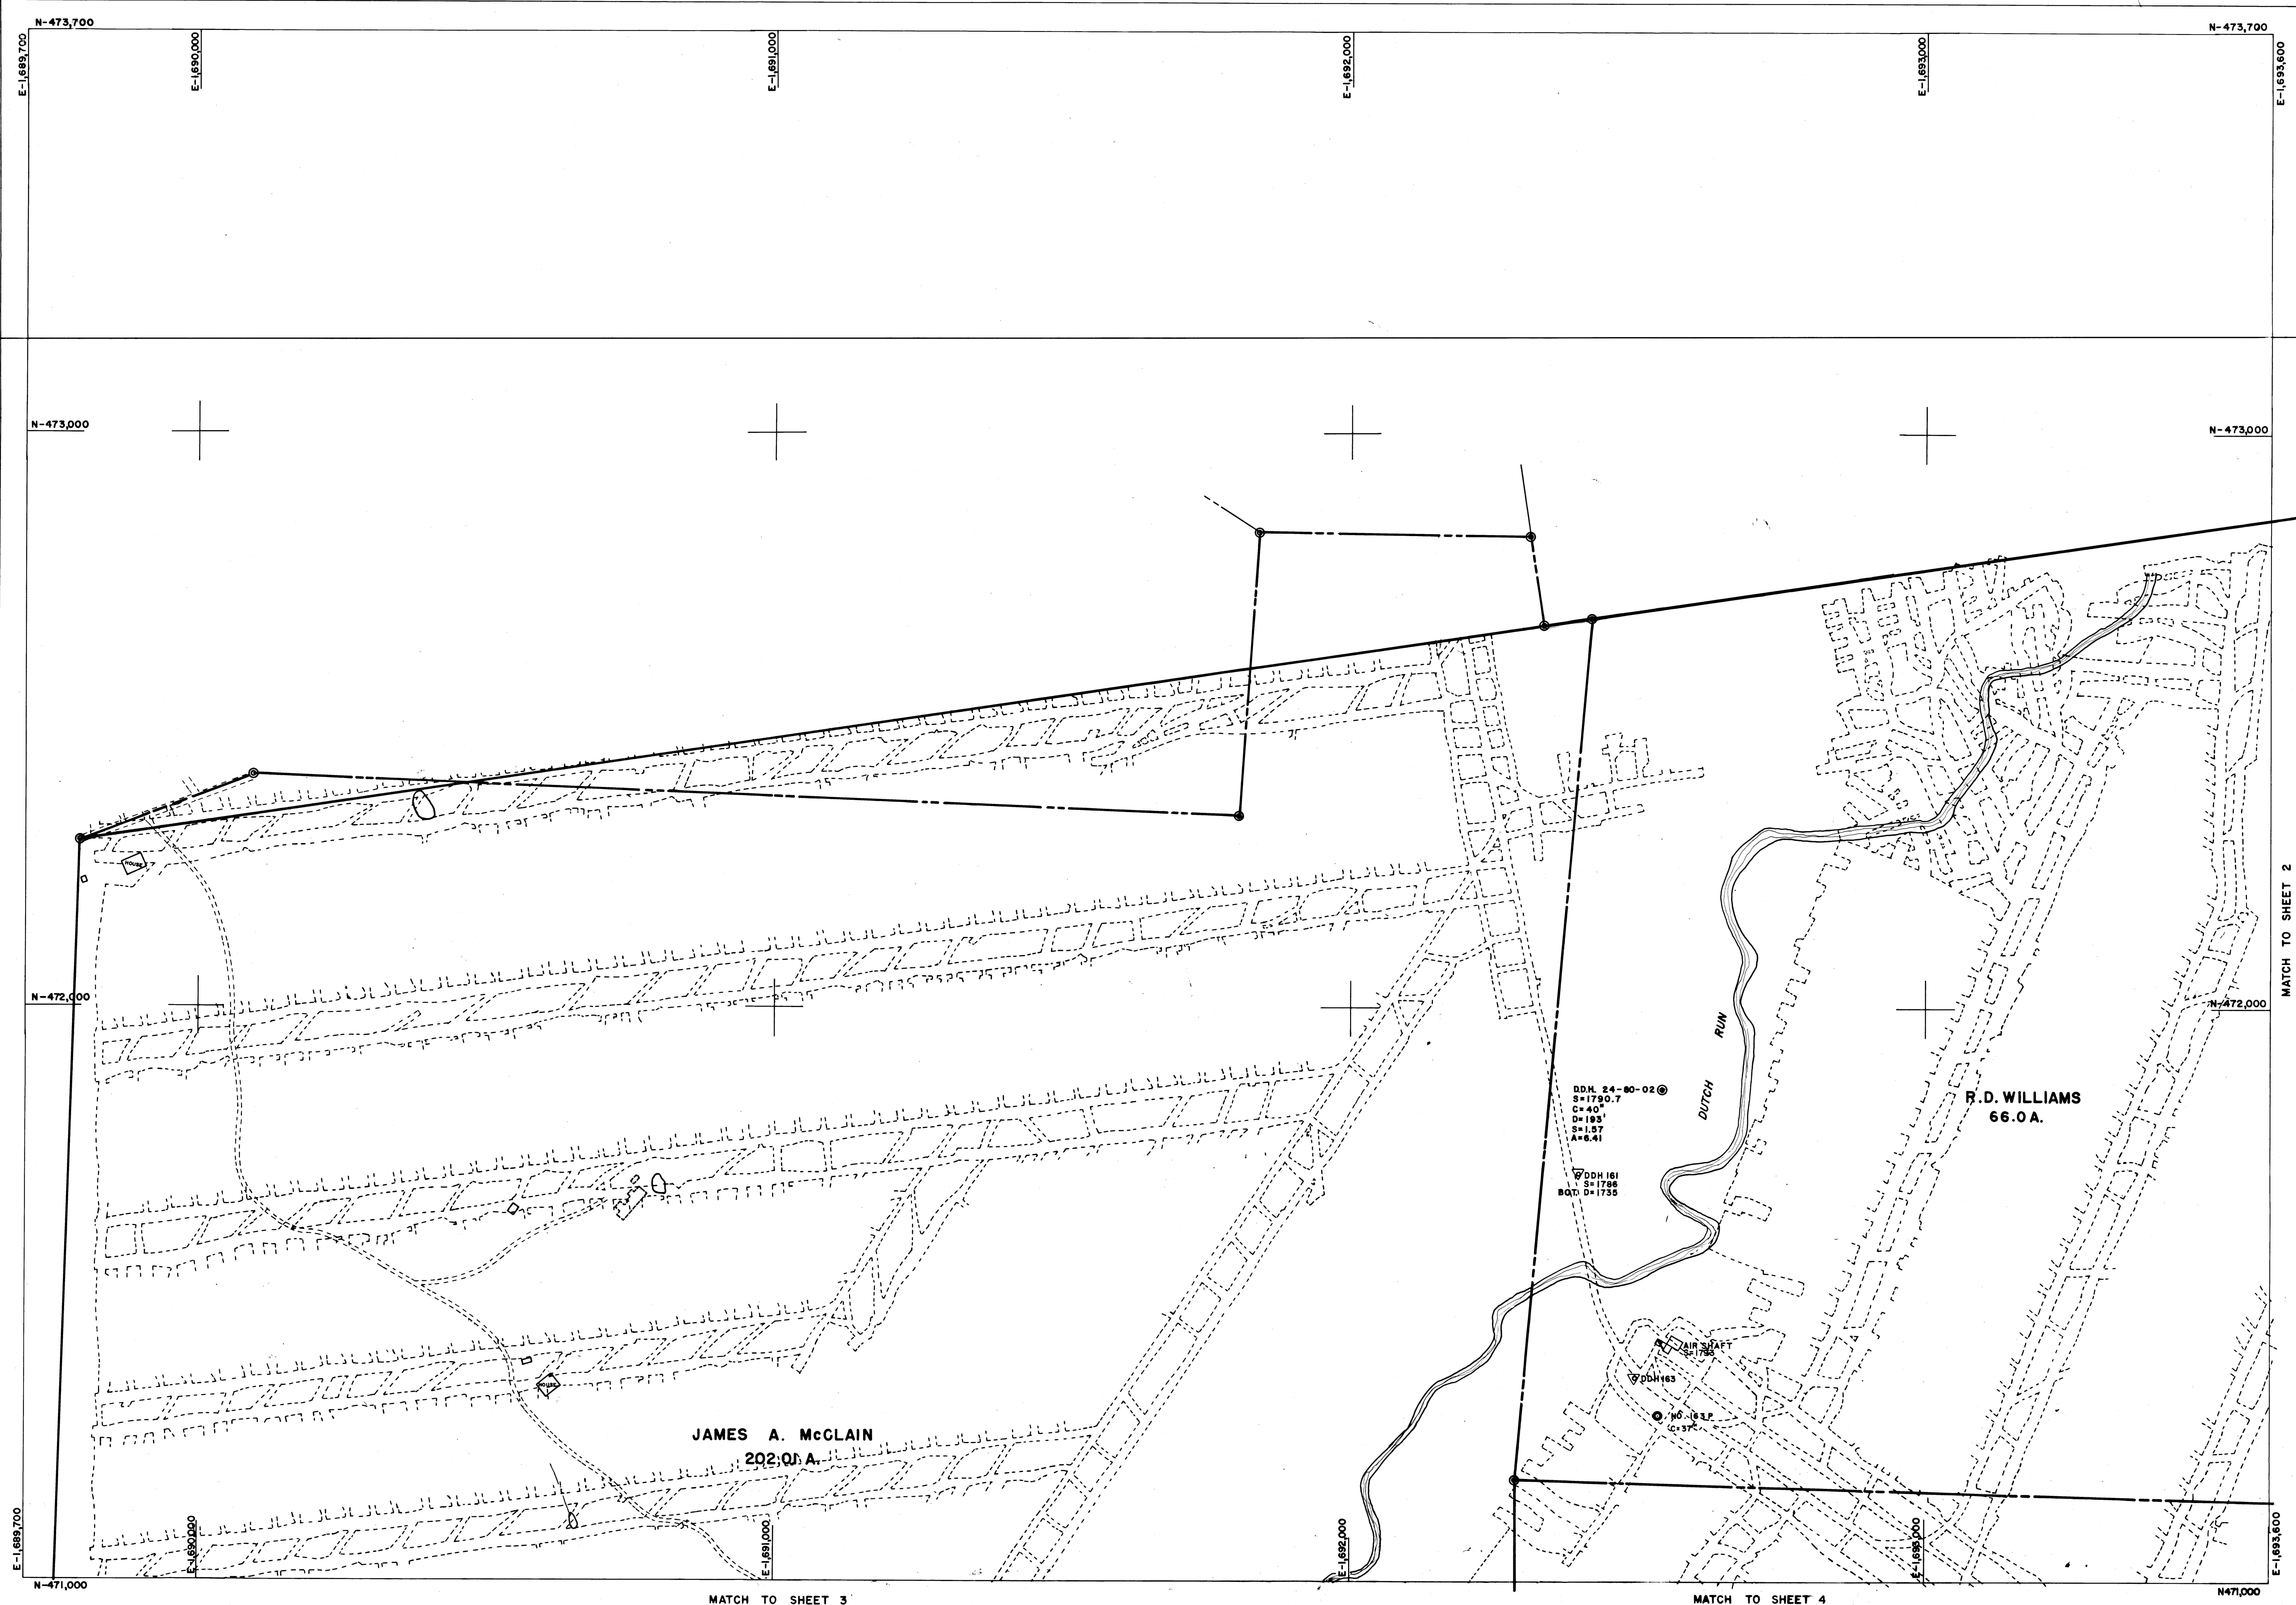

NO. 24 "B" SEAM
FINAL MAPPING DATE: 4-11-86