FIT TO 1-9-4-7

1-9-4-8

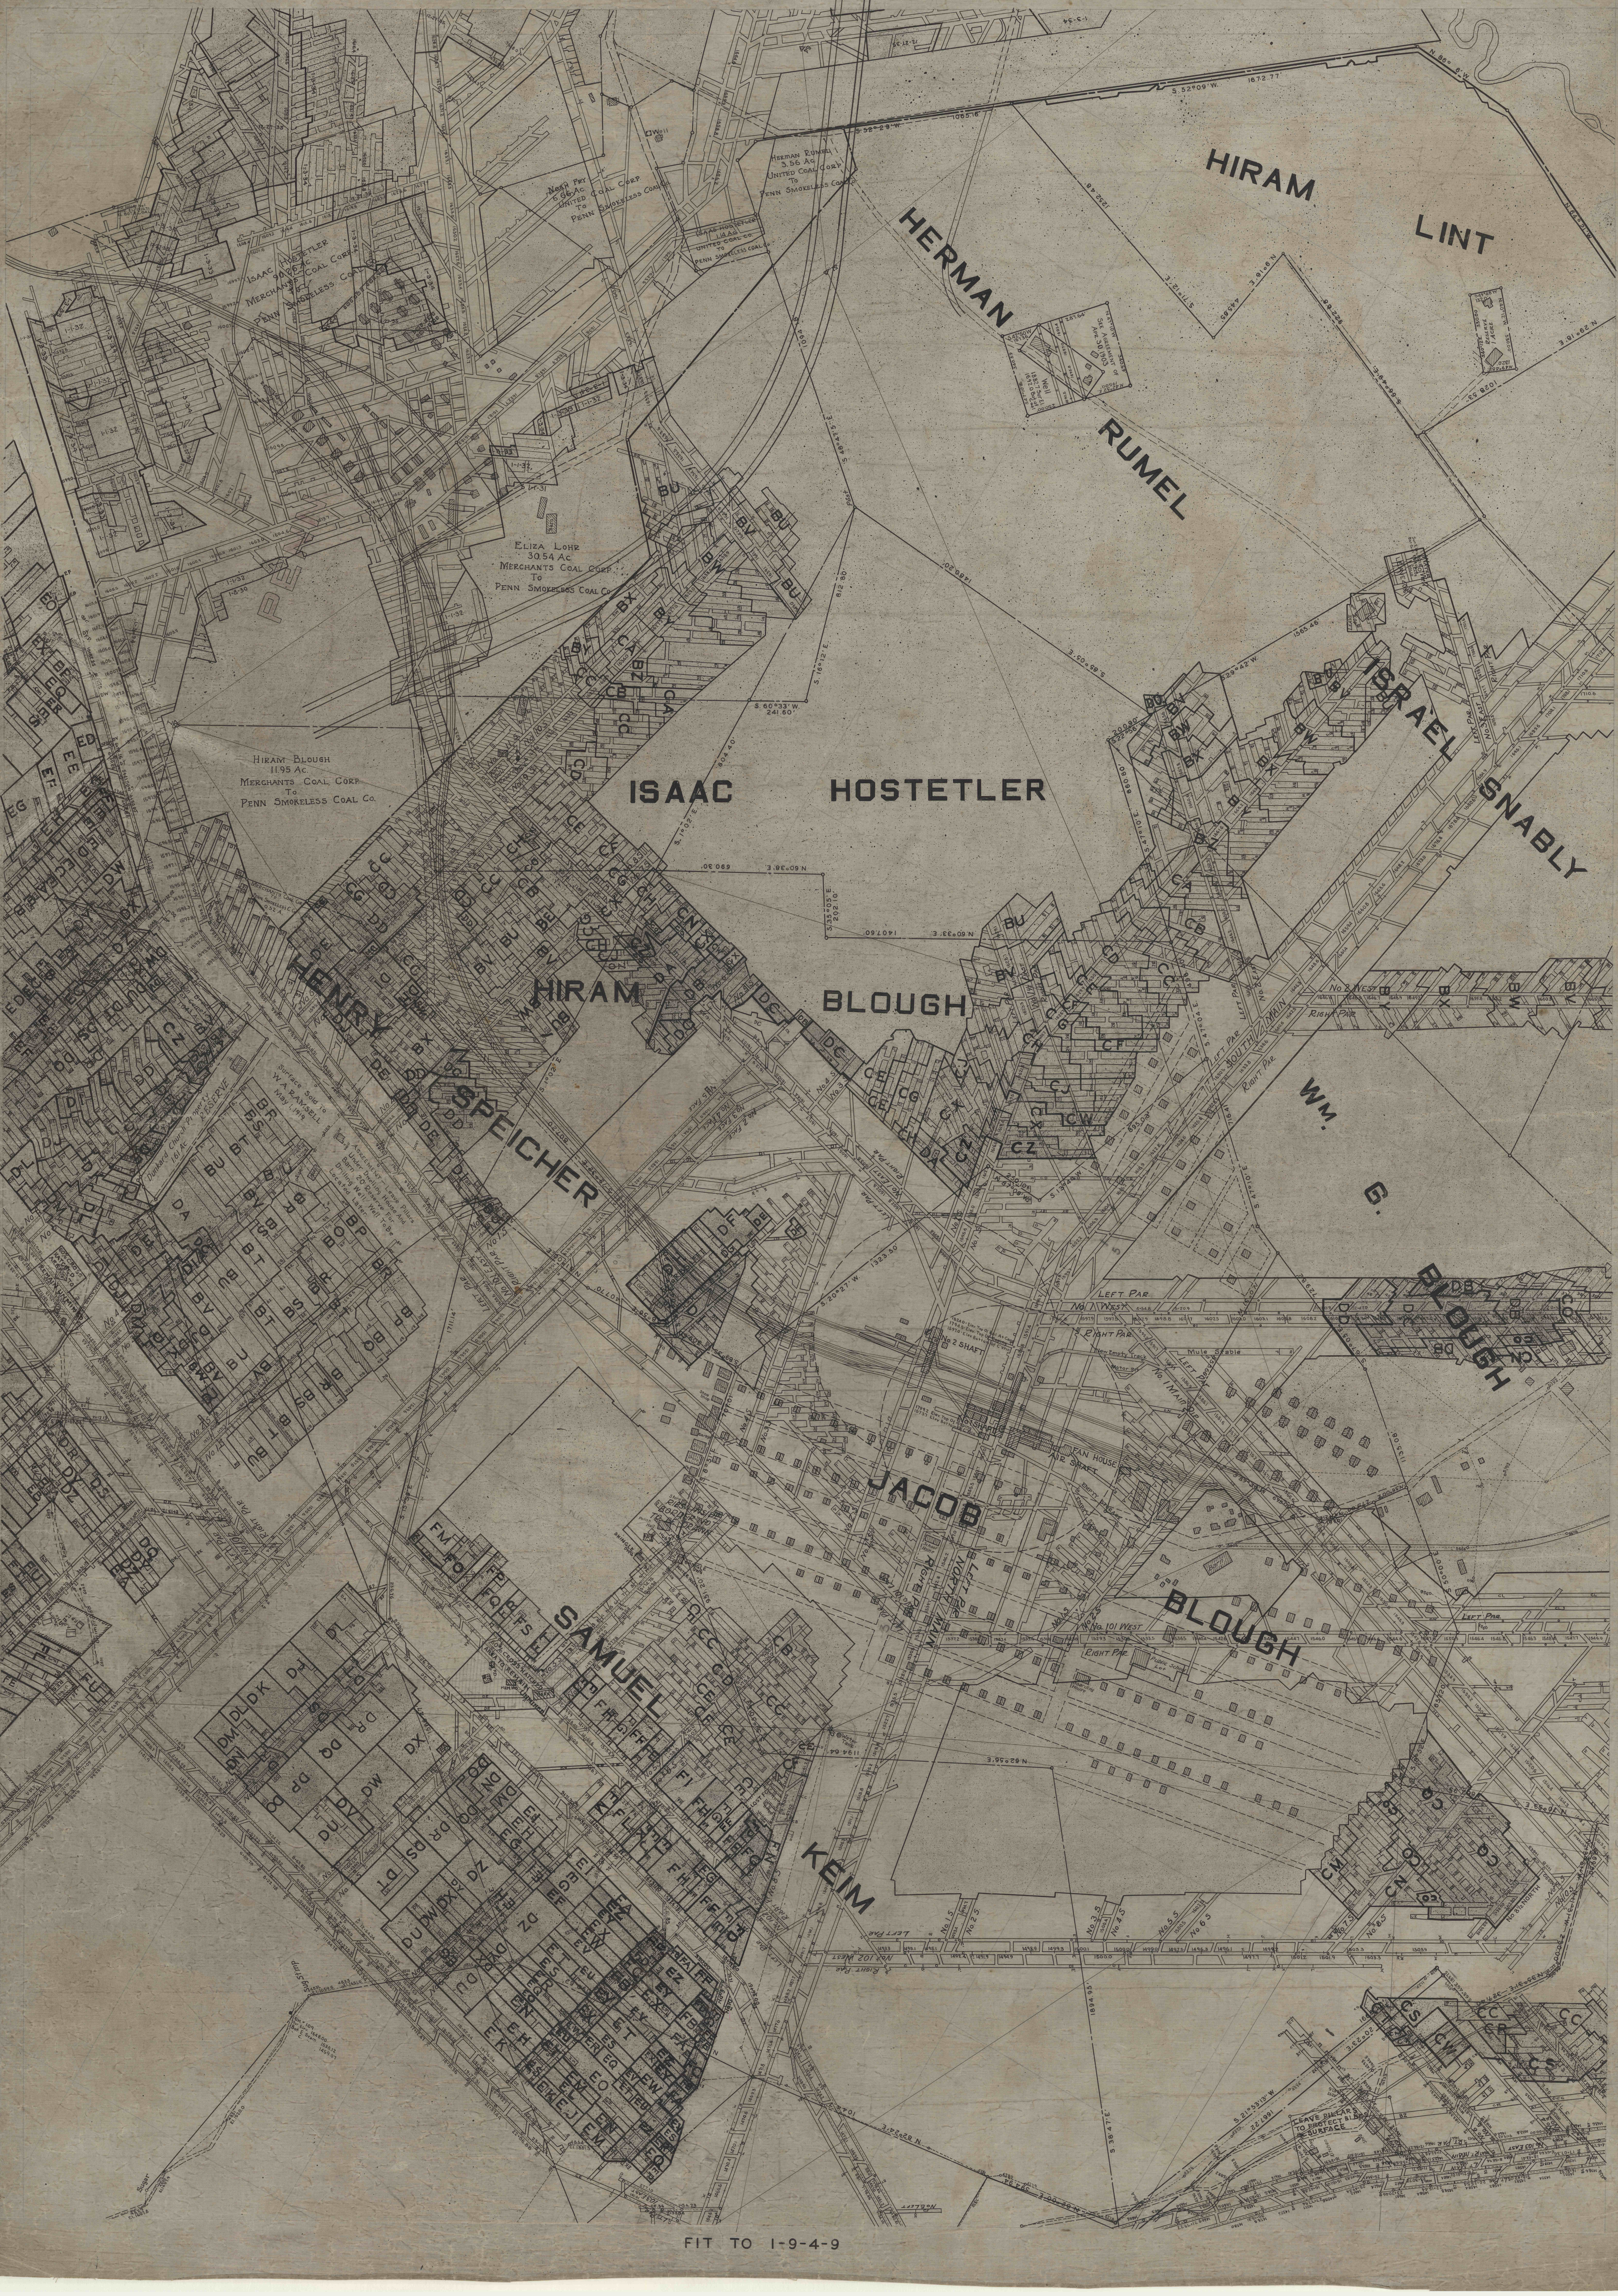
HIRAM LINT
HERMAN RUMEL
ISAAC HOSTETLER
ISRAEL SNABLY
HENRY SPEICHER
HIRAM BLOUGH
WM. G. BLOUGH
JACOB BLOUGH
SAMUEL KEIM
Herman Rumel 3.56 Ac. United Coal Corp. To Penn Smokeless Coal Co.
Noah Fry 6.66 Ac. United Coal Corp. To Penn Smokeless Coal Co.
Isaac Hostetler 90.26 Ac. Merchants Coal Corp. To Penn Smokeless Coal Co.
Isaac Hostetler 1.14 Ac. United Coal Co. To Penn Smokeless Coal Co.
Eliza Lohr 30.54 Ac. Merchants Coal Corp. To Penn Smokeless Coal Co.
Hiram Blough 11.95 Ac. Merchants Coal Corp. To Penn Smokeless Coal Co.
Merchants Coal Corp. To Penn Smokeless Co. 0.52 A.
See Agreement of Apr. 30, 1903
Well
Reserve 1 Acre
Surface Sold to W. A. Ramsell May 1, 1919
Dunkard Church Property 1.61 Ac. Reserve
Agreement - Leave Pillars Under Dwelling House And Barn 20' Reserve For Drilling Well. Well To Be Located Later.
No. 2 Shaft
No. 1 Shaft
Fan House
Air Shaft
Mule Stable
New Empty Track
Public School Lot
Boarding House
Barn
Water Tank
Leave Pillars To Protect Bldg. Surface
No. 1 West
No. 2 West
No. 101 West
No. 102 West
No. 103 East
South Main
North Main
No. 1 Main Dip
Left Par.
Right Par.
S. 52°09' W. 1672.77'
S. 52°29' W. 1065.16'
N. 86° 6' W.
N. 64° 21' W.
S. 60°33' W. 241.60'
N. 60°33' E. 1407.60
N. 60°38' E. 690.30
S. 35°05' E. 202.10
S. 85°05' E. 1565.46'
S. 29°42' W.
S. 22°56' W. 200.90'
S. 47°10' E. 860.80'
S. 47°04' E. 895.08'
S. 16°12' E. 812.80
S. 48°47' 5" E. 1094.18
1480.20'
S. 69°49' E. 1226.66
N. 29°18' E. 1028.53
S. 71°12' E. 445.65
N. 9°16' E.
1252.48
S. 20°27' W. 1323.50'
N. 62°56' E. 1194.64
S. 38°47' E. 1894.95'
N. 82°24' E.
N. 39°31' E.
S. 21°53'13" W. 1667.22
1135.08
S. 50°00' E.
Sugar
Camp

FIT TO 1-9-4-5

FIT TO 1-9-4-11

SHEET NO. 1-9-4-8

FIT TO 1-9-4-9