

MEXI

SU

GIBBONS

MISSISSIPPI

OHIO

ALLEGHENY

MAIN

CENTER

STONYCREEK

QUEMAHONING

AVENUE

JUNIATA


AVENUE

AVENUE

MORGAN


SOMERSET

INDEX	
LETTER	DATE OF SURVEY
X	June 23, 1903
Y	Aug. 25, 1903
Z	Jan. 4, 1911
A	March 30, 1910
B	June 30, 1910
C	Oct. 12, 1910
D	Dec. 31, 1910
E	Apr. 12, 1911
F	Aug. 25, 1911
G	Nov. 30, 1911
H	Dec. 31, 1911
I	March 30, 1912
J	July 10, 1912
K	Sept. 25, 1912
L	Dec. 31, 1912
M	April 1, 1913
N	July 9, 1913
O	Oct. 1, 1913
P	Dec. 31, 1913

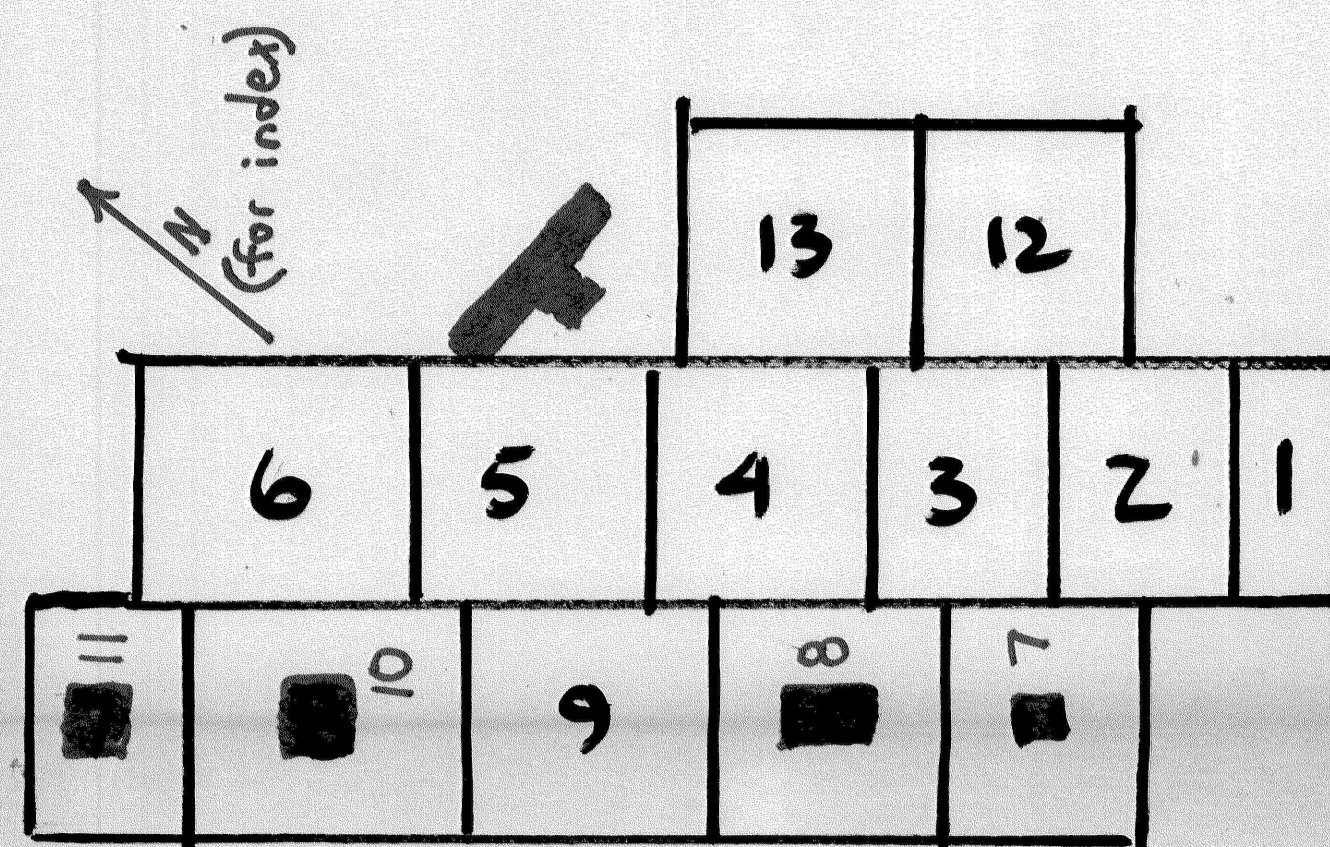

1

795

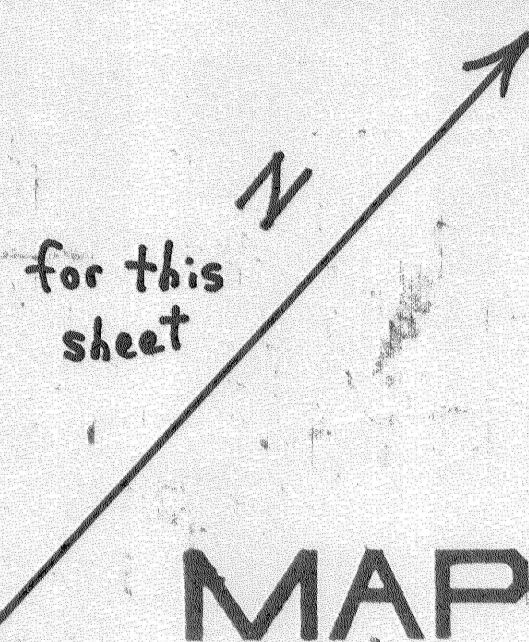

MAP OF
ORENDA No. 2 MINE

SITUATE IN

JENNER TWP. SOMERSET

PA. STATE DEPT. UNITED STATES