


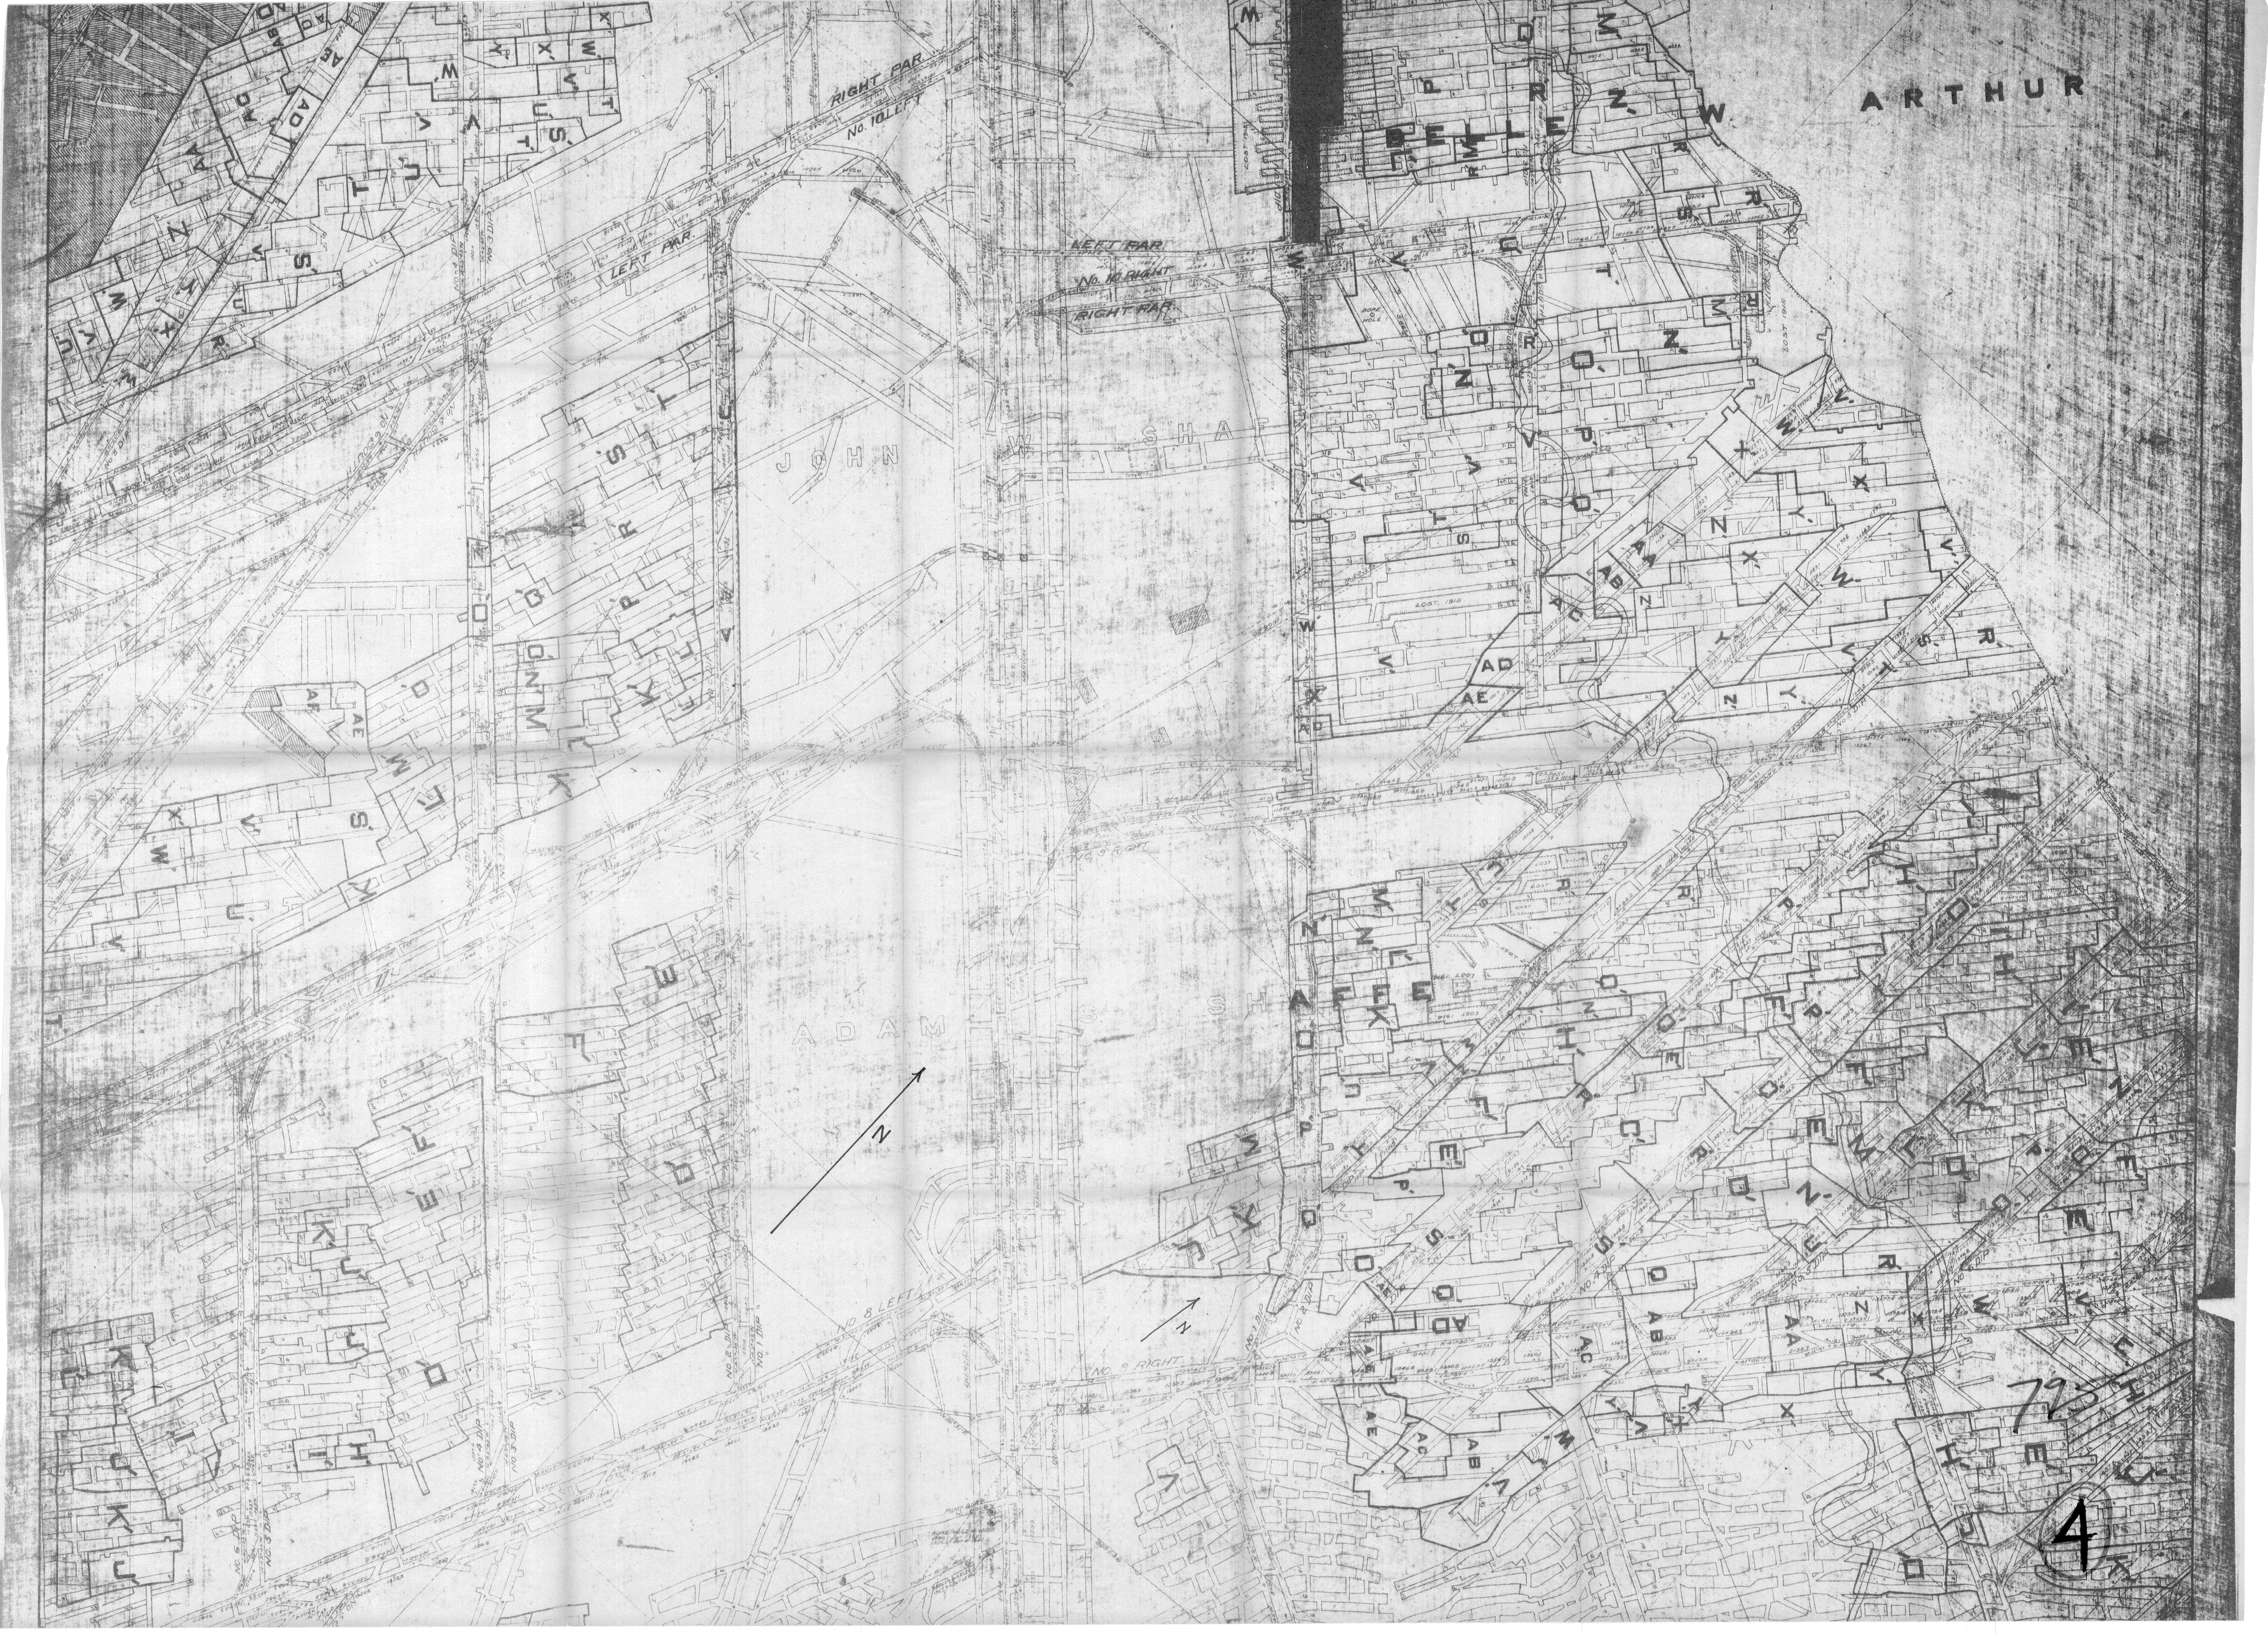

ARTHUR

2

1

725

4