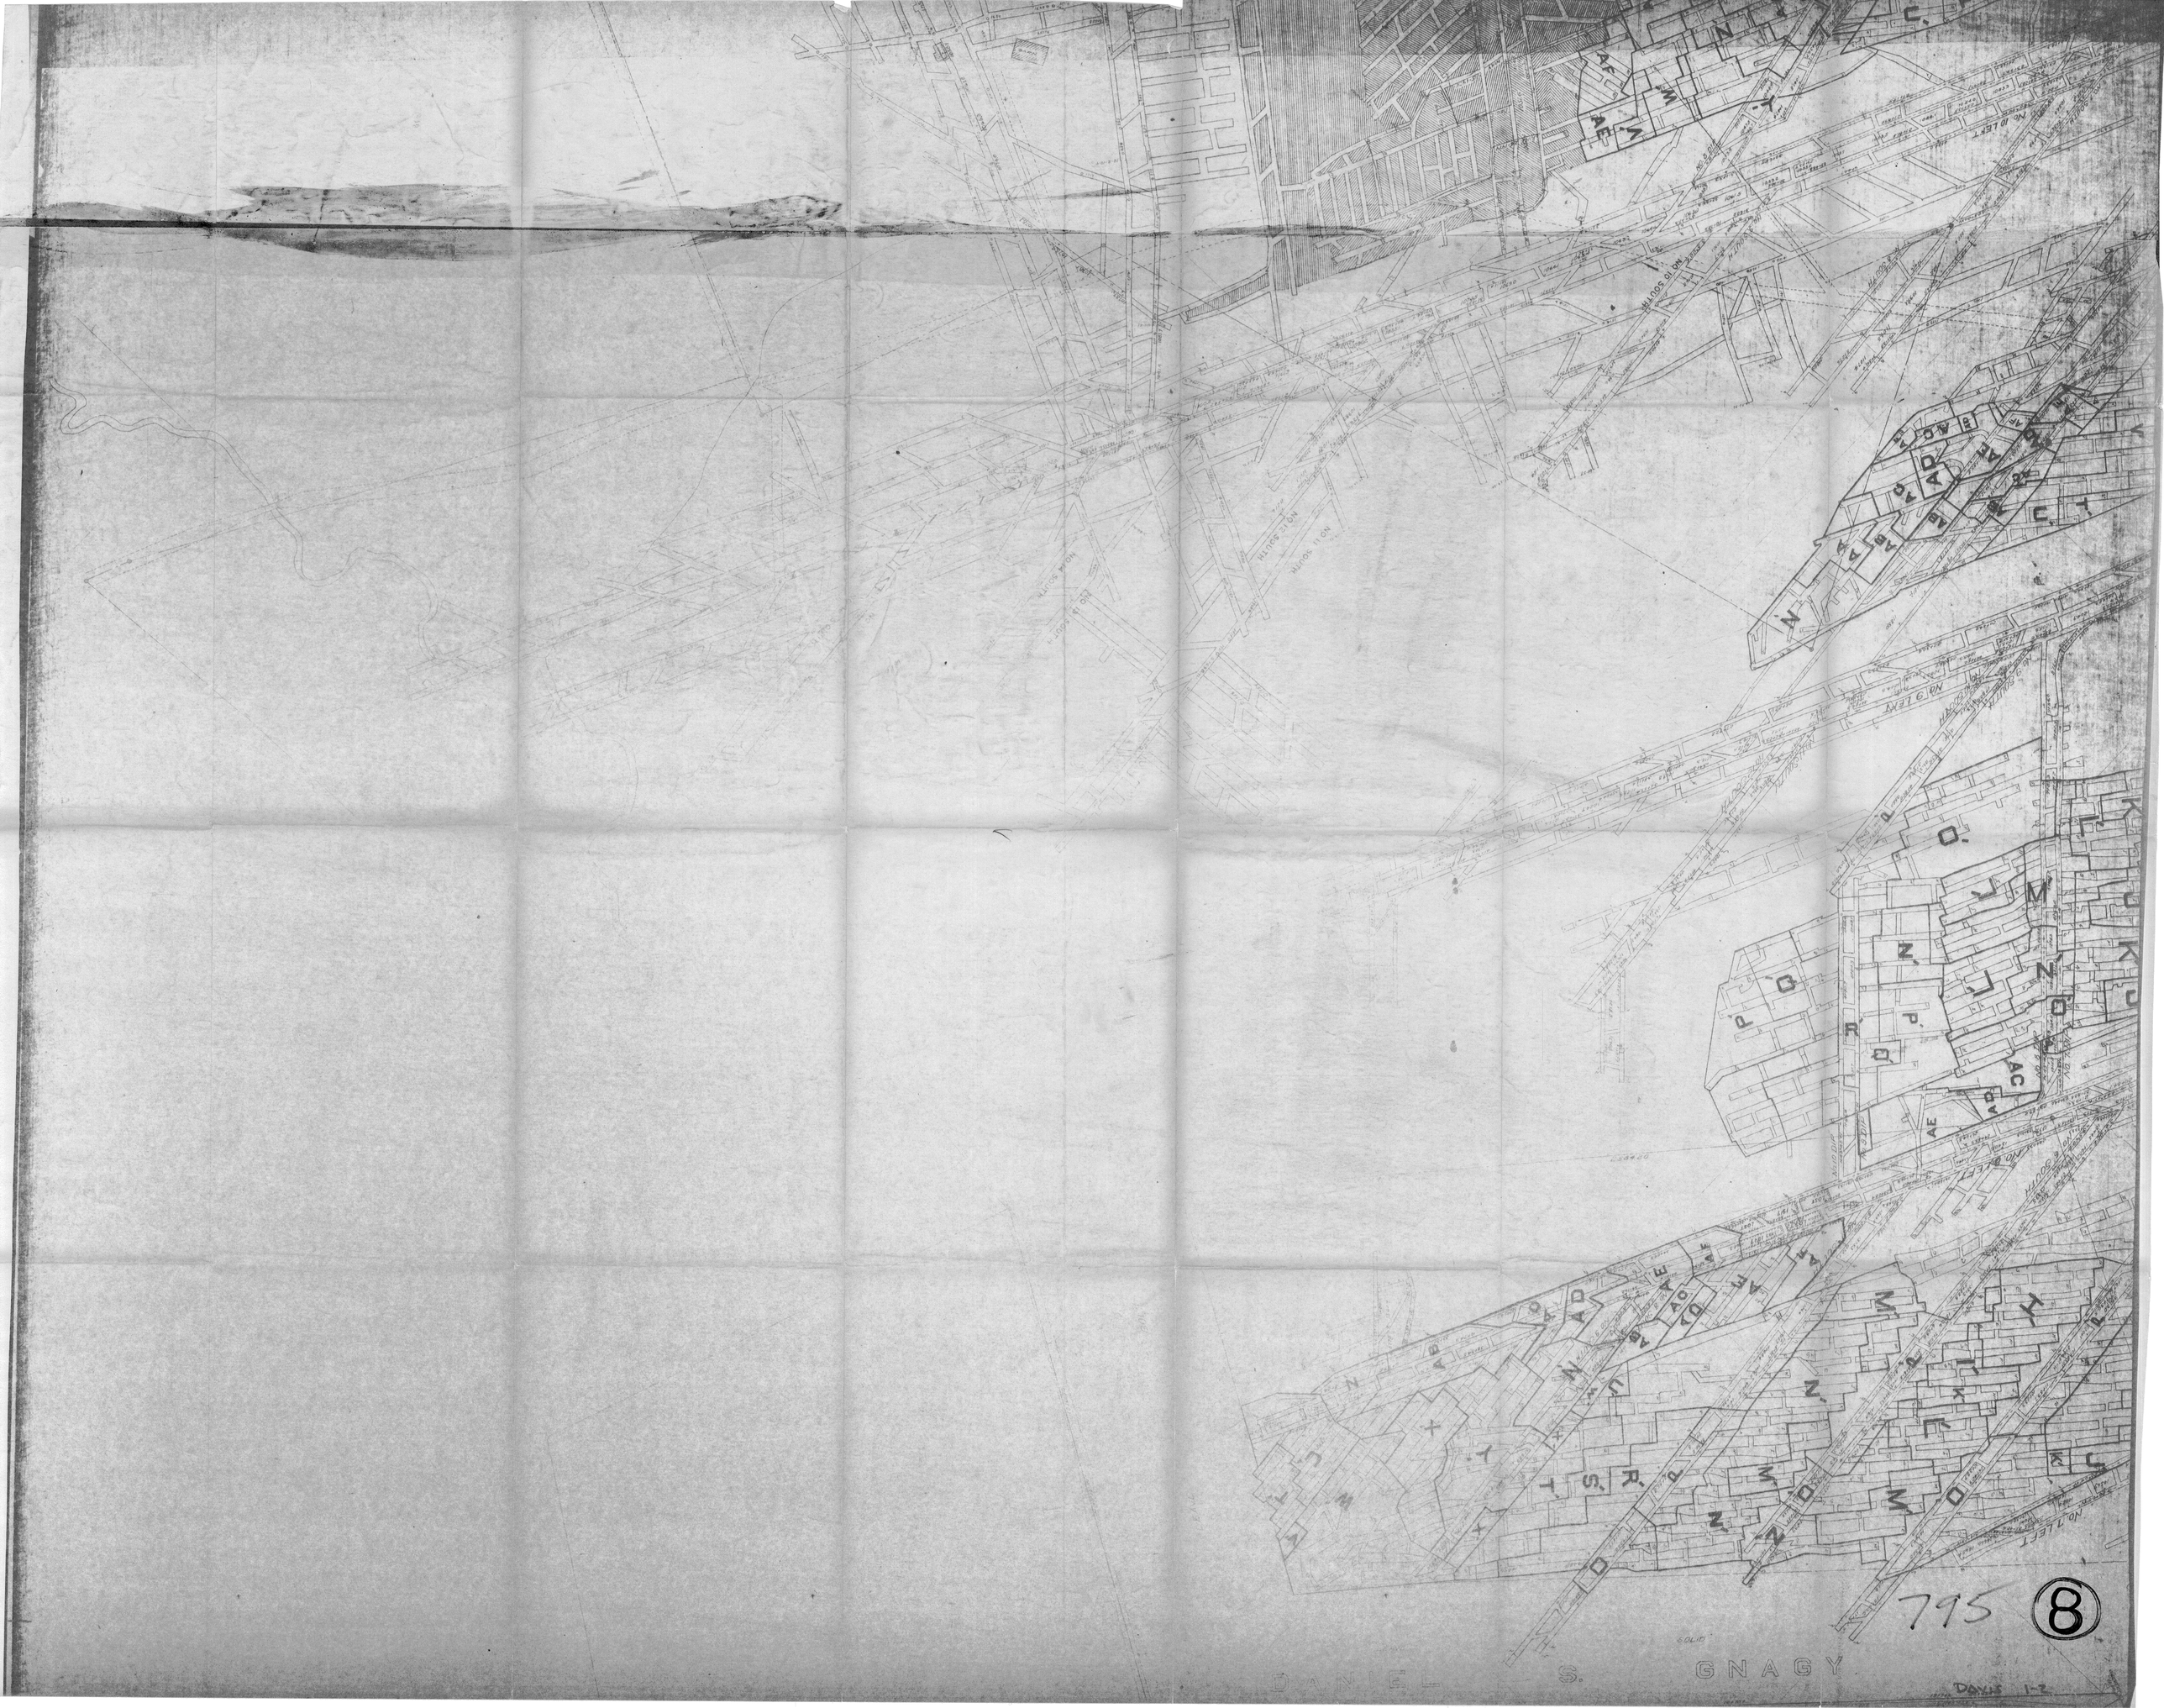

NO 10 LEFT
NO 10 SOUTH
NO 9 LEFT
NO 8 SOUTH
NO 7 LEFT
DANIEL S. GNAGY
DAVIS 1-2

795

8