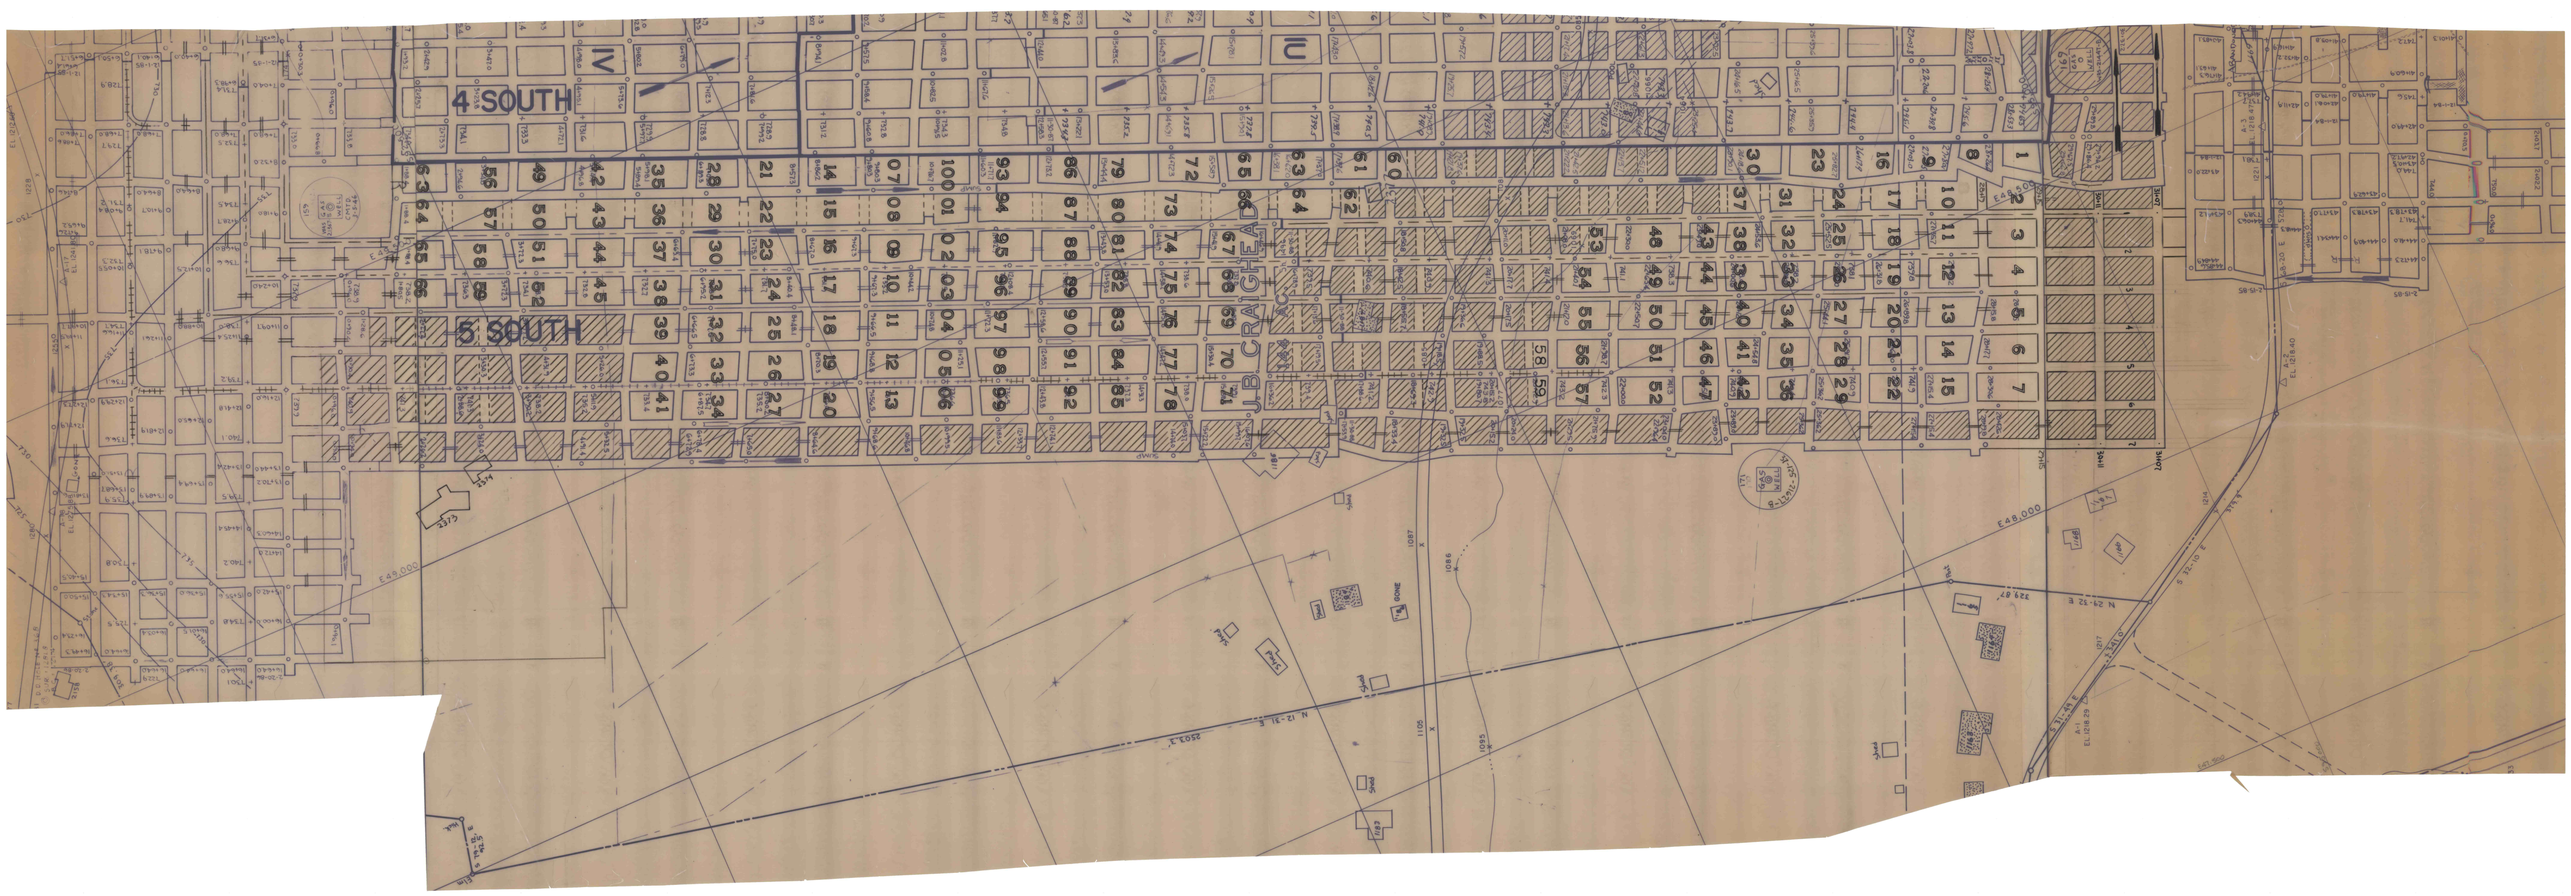
4 SOUTH
5 SOUTH
J.B. CRAIGHEAD
E48,000
E49,000