NATIONAL NO 4—SHEET 1154

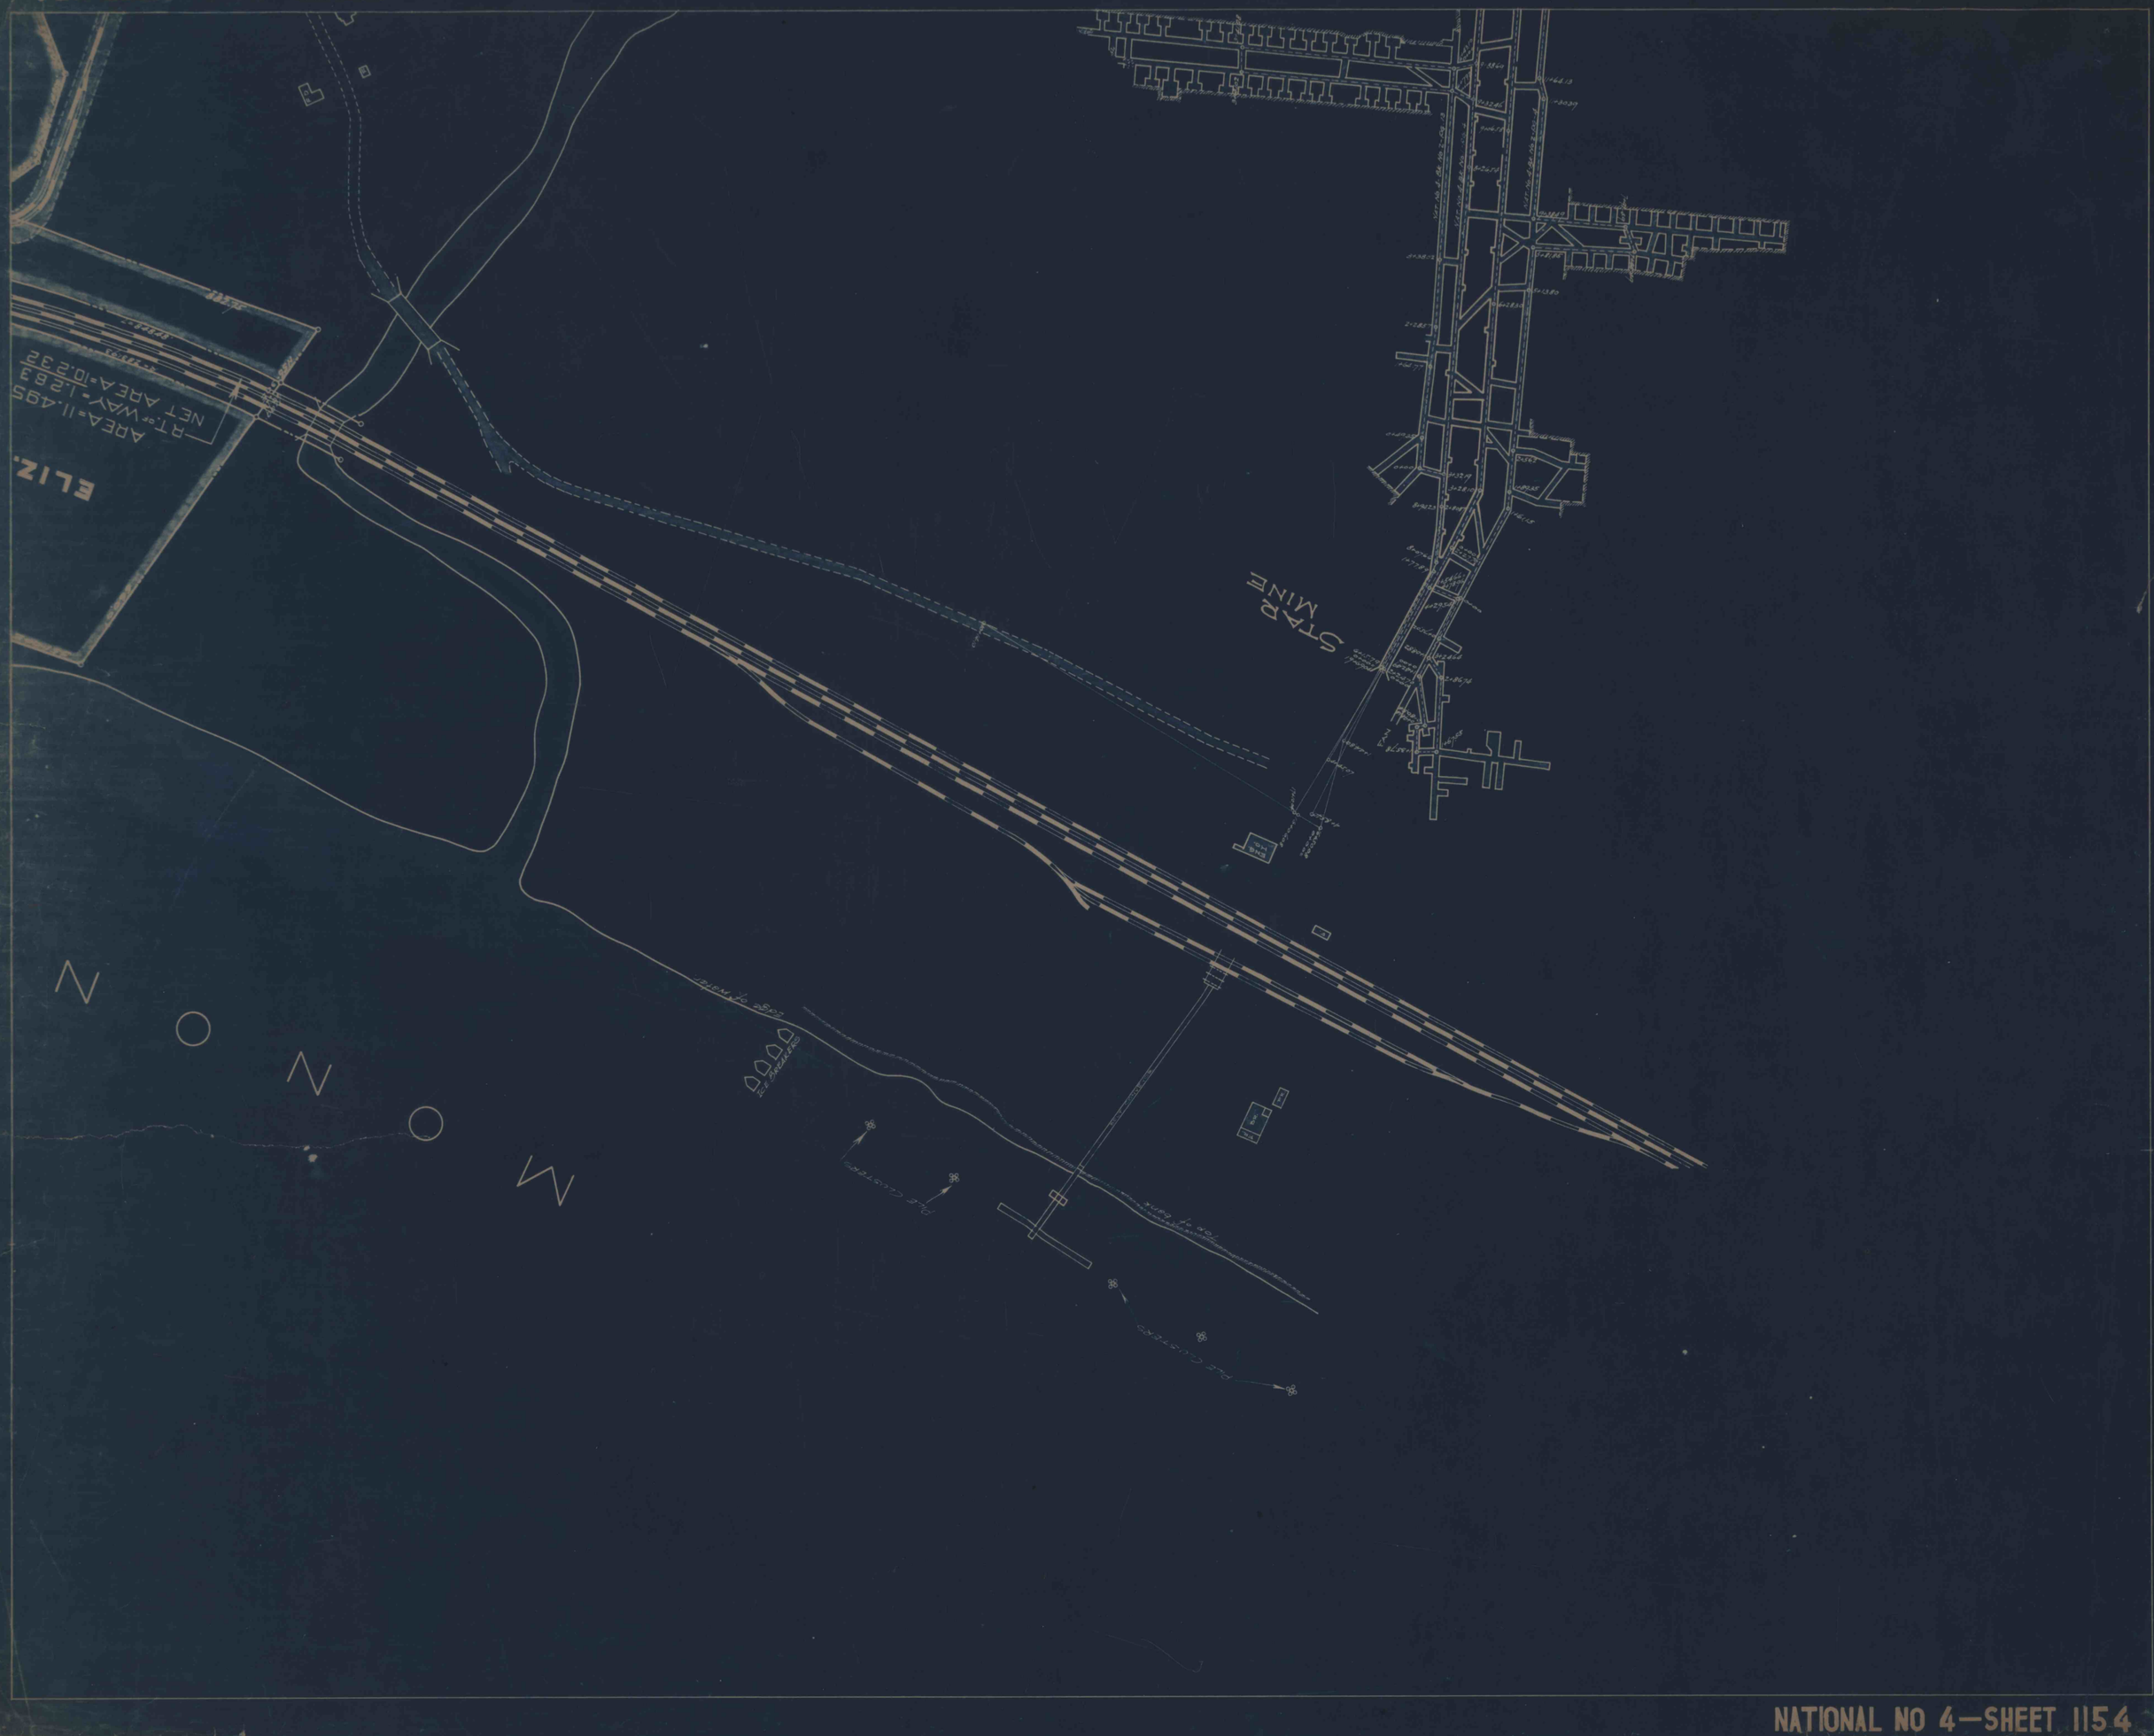

NATIONAL NO 4—SHEET 1154