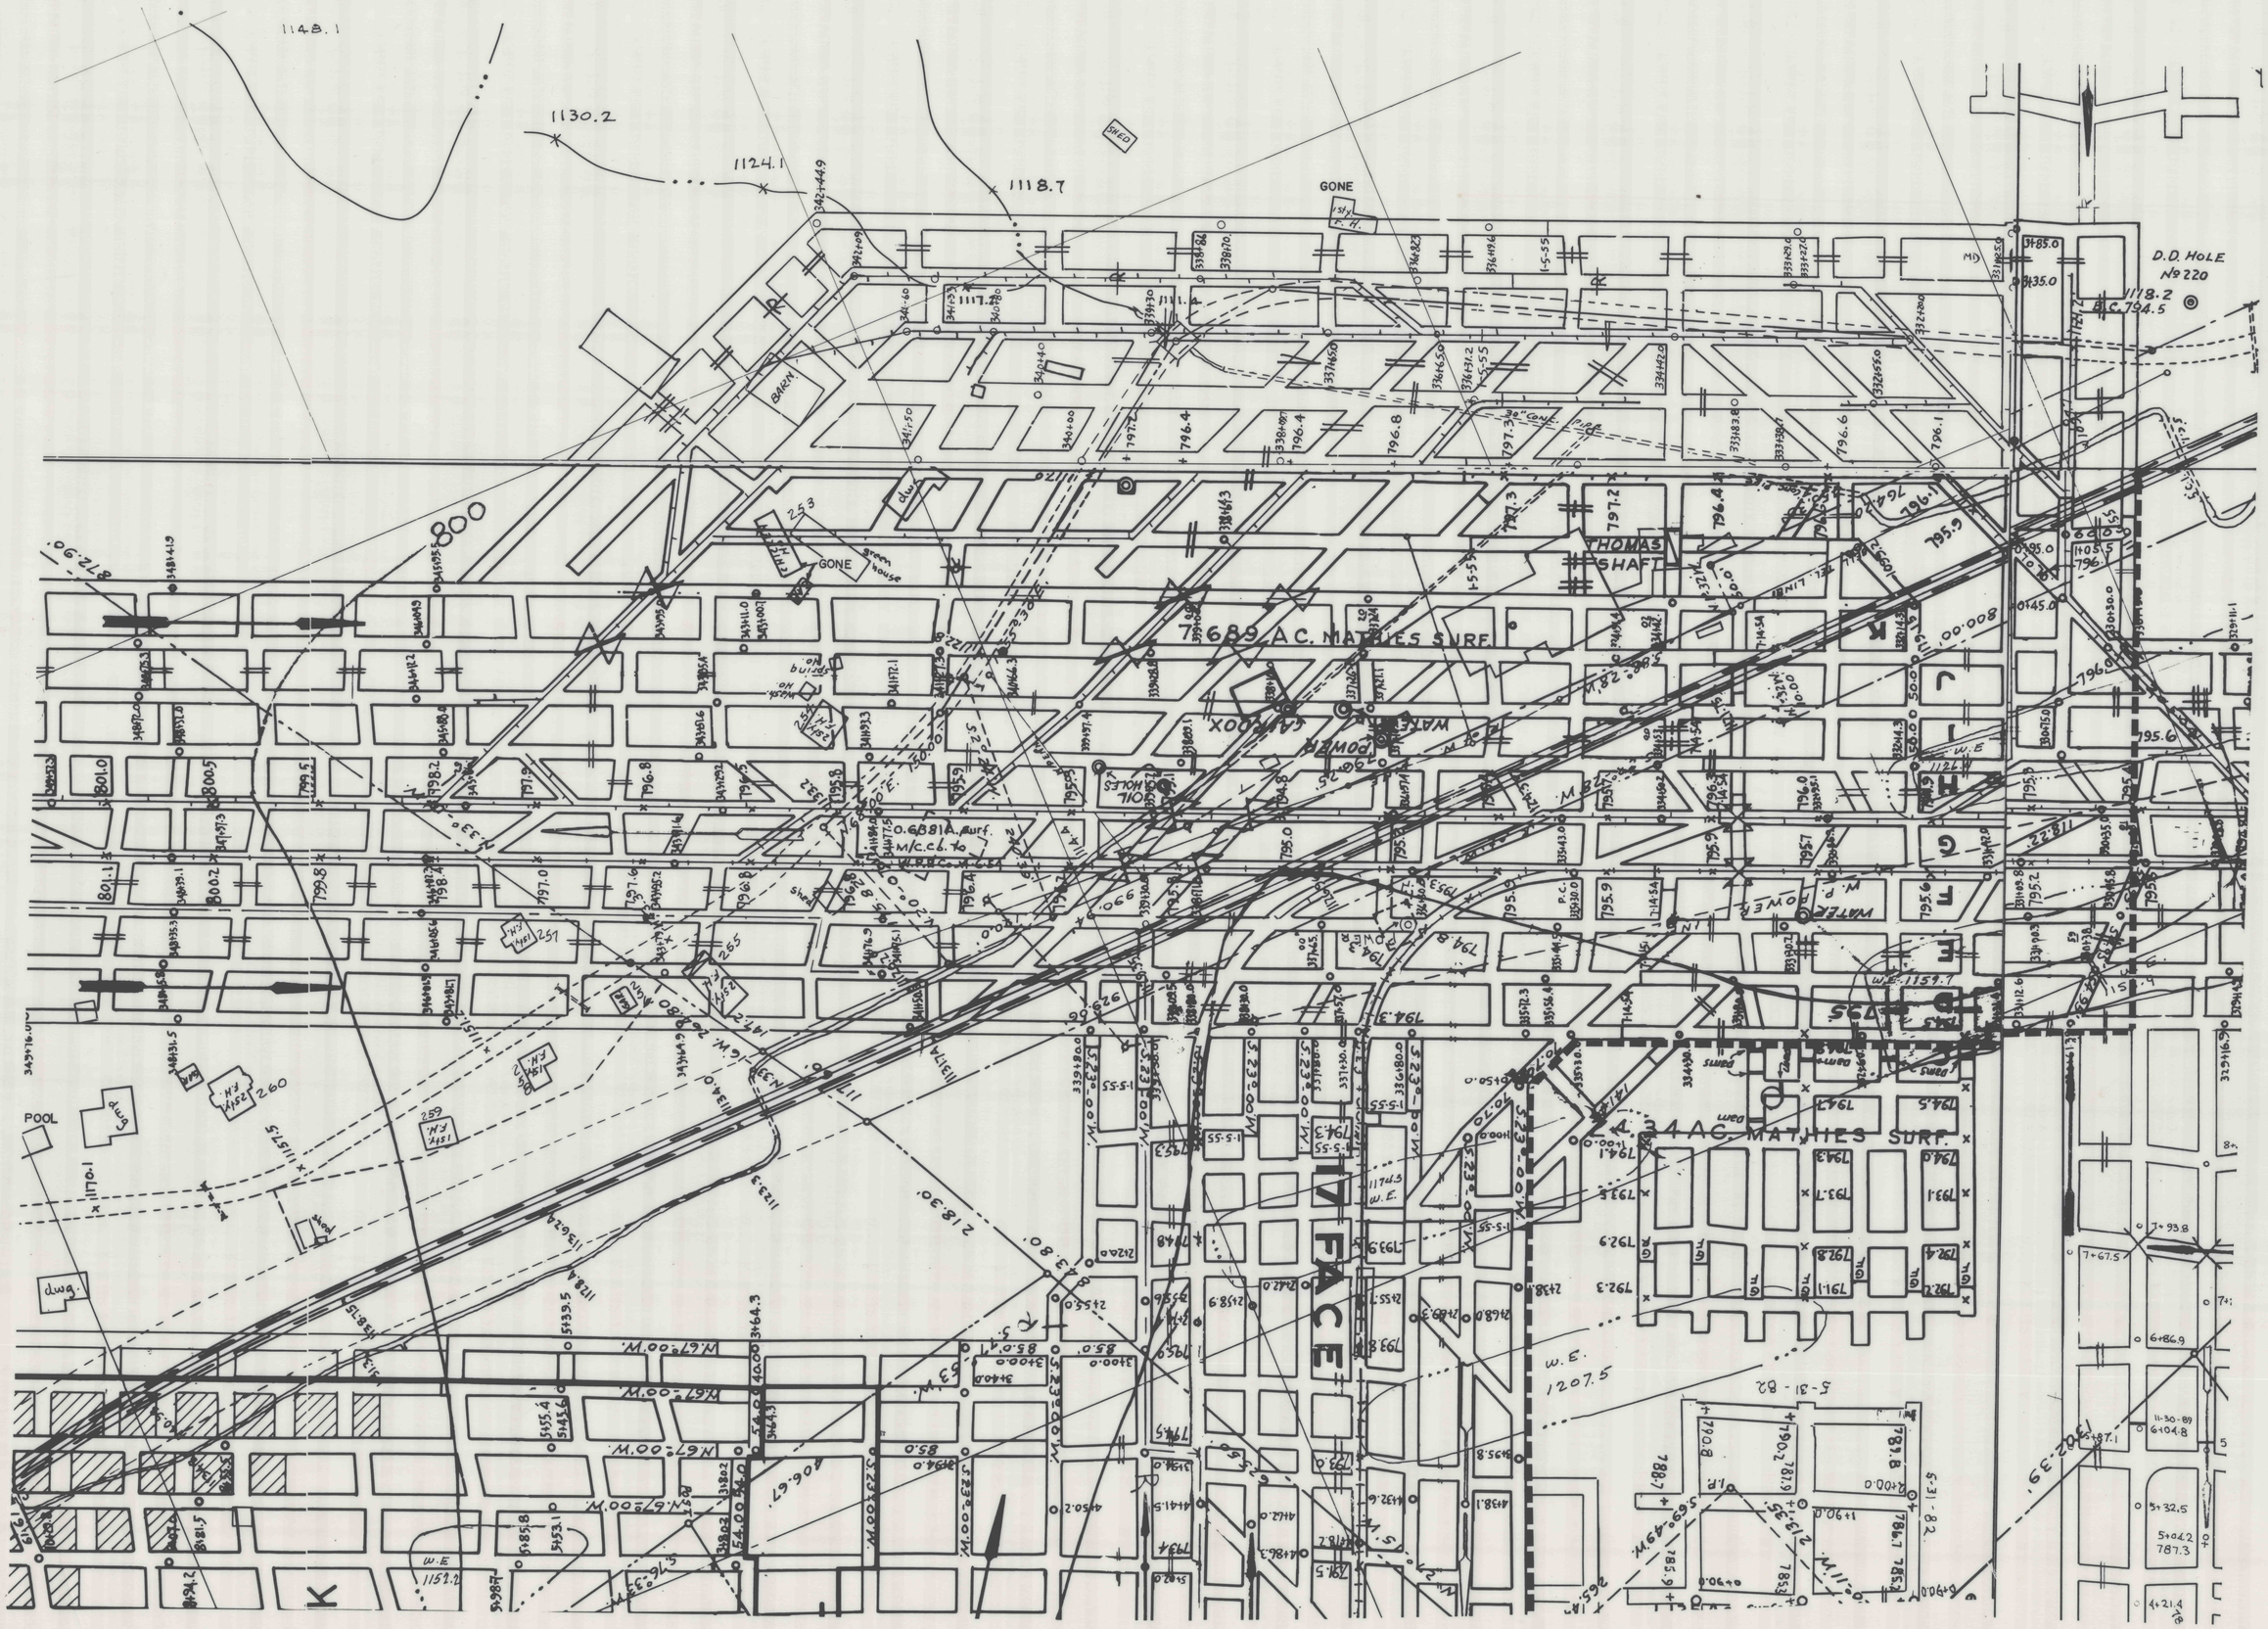
1148.1
1130.2
1124.1
1118.7
GONE
SHED
D.D. HOLE
№ 220
1118.2
B.C. 794.5
BARN
GONE
green house
POOL
THOMAS SHAFT
7689 A.C. MATHIES SURF.
CAMBOX
POWER
WATER
POWER
0.6881A. surf.
m/c.c.l. to
7434 AC. MATHIES SURF.
17 FACE
w.e. 1207.5
w.e. 1159.7
w.e. 1152.2
w.e.
K
J
H
G
F
E
D
C
800
N.67°-00'W.
S.23°-00'W.
N.23°-00'W.
S.67°-00'W.
N.67°-00'W.
S.16°-33'W.
N.33°-00'E.
N.67°-00'E.
S.59°-49'W.
N.31°-00'W.
S.31°-00'E.
S.23°-00'W.
N.23°-00'E.
S.23°-00'W.
N.23°-00'E.
S.23°-00'W.
N.23