


FROM PITTSBURGH COAL CO  
42.73 ACRES  
HM RTR Co DEED 390  
COAL AND RR RIGHT OF WAY RESERVED

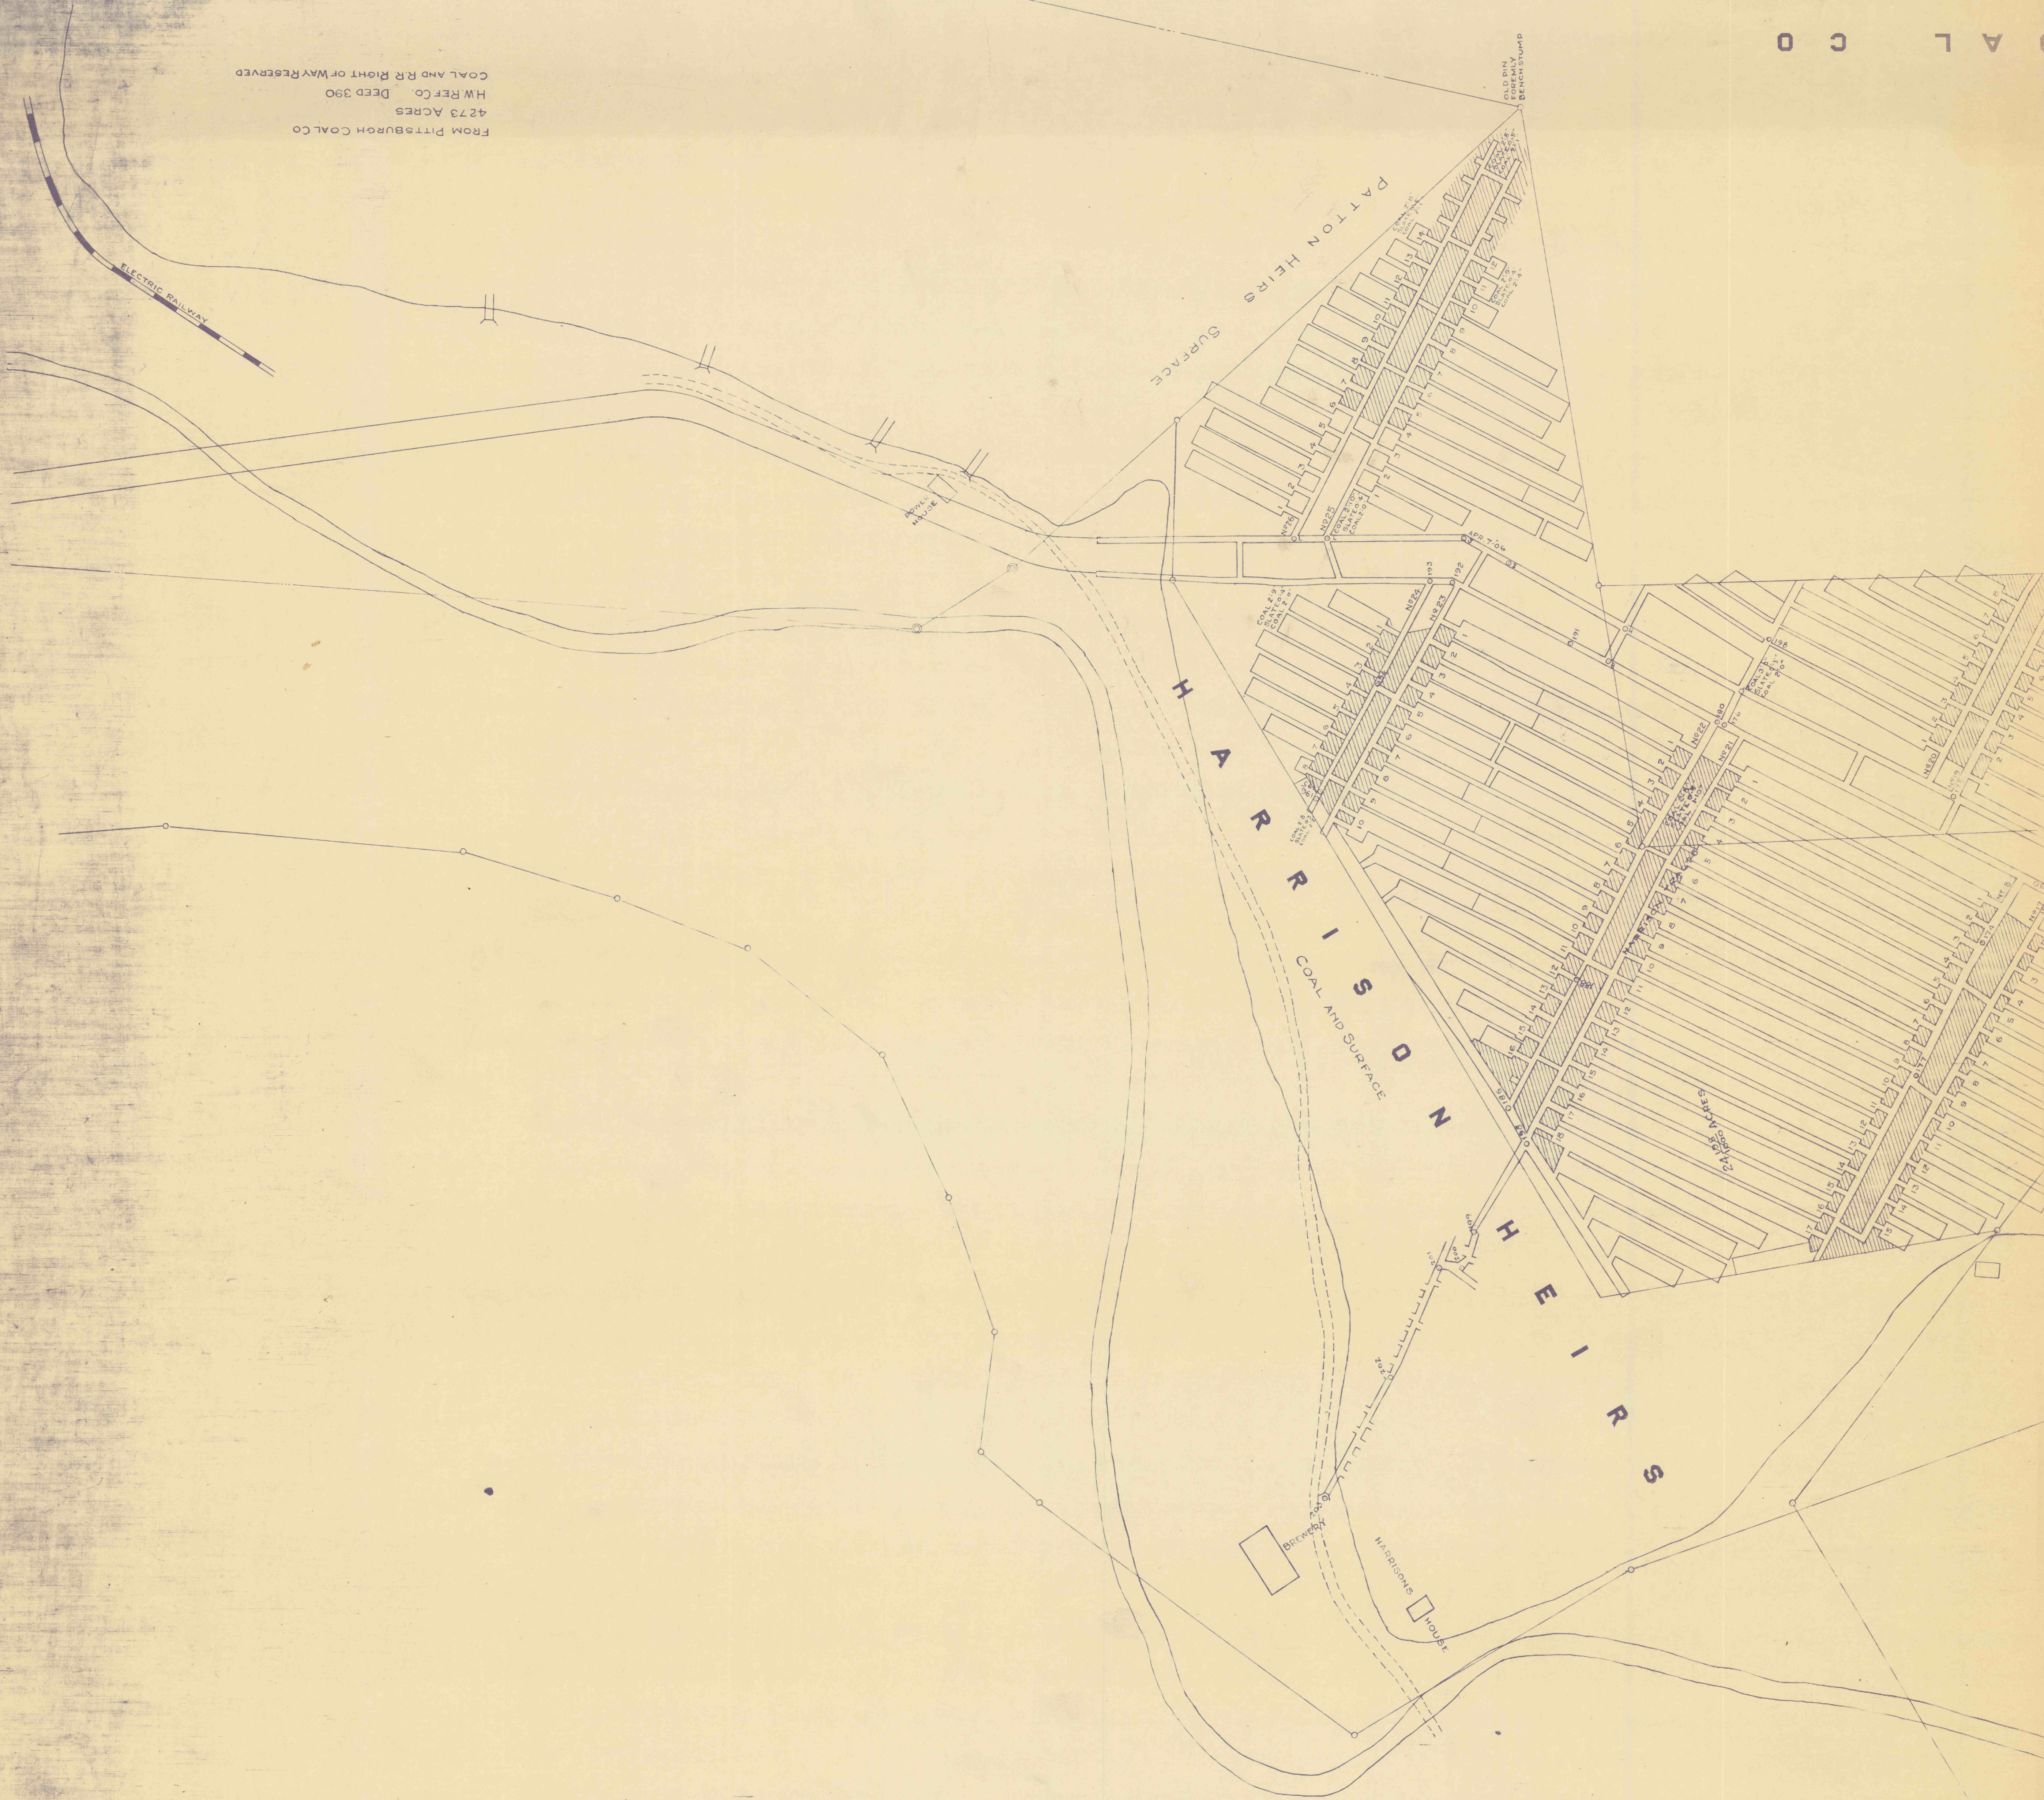

MAP  
 OF THE  
 STAR MINE  
 SITUATED IN  
 UNION TOWNSHIP WASHINGTON CO. PA.  
 FOR  
 HARBISON AND WALKER CO.  
 SCALE 1"=100'  
 TRACED FROM BLUE PRINT JAN. 24, 1919

J. S. M. A