


100 feet

FIT TO K-5673

MATHIES MINE K-5672

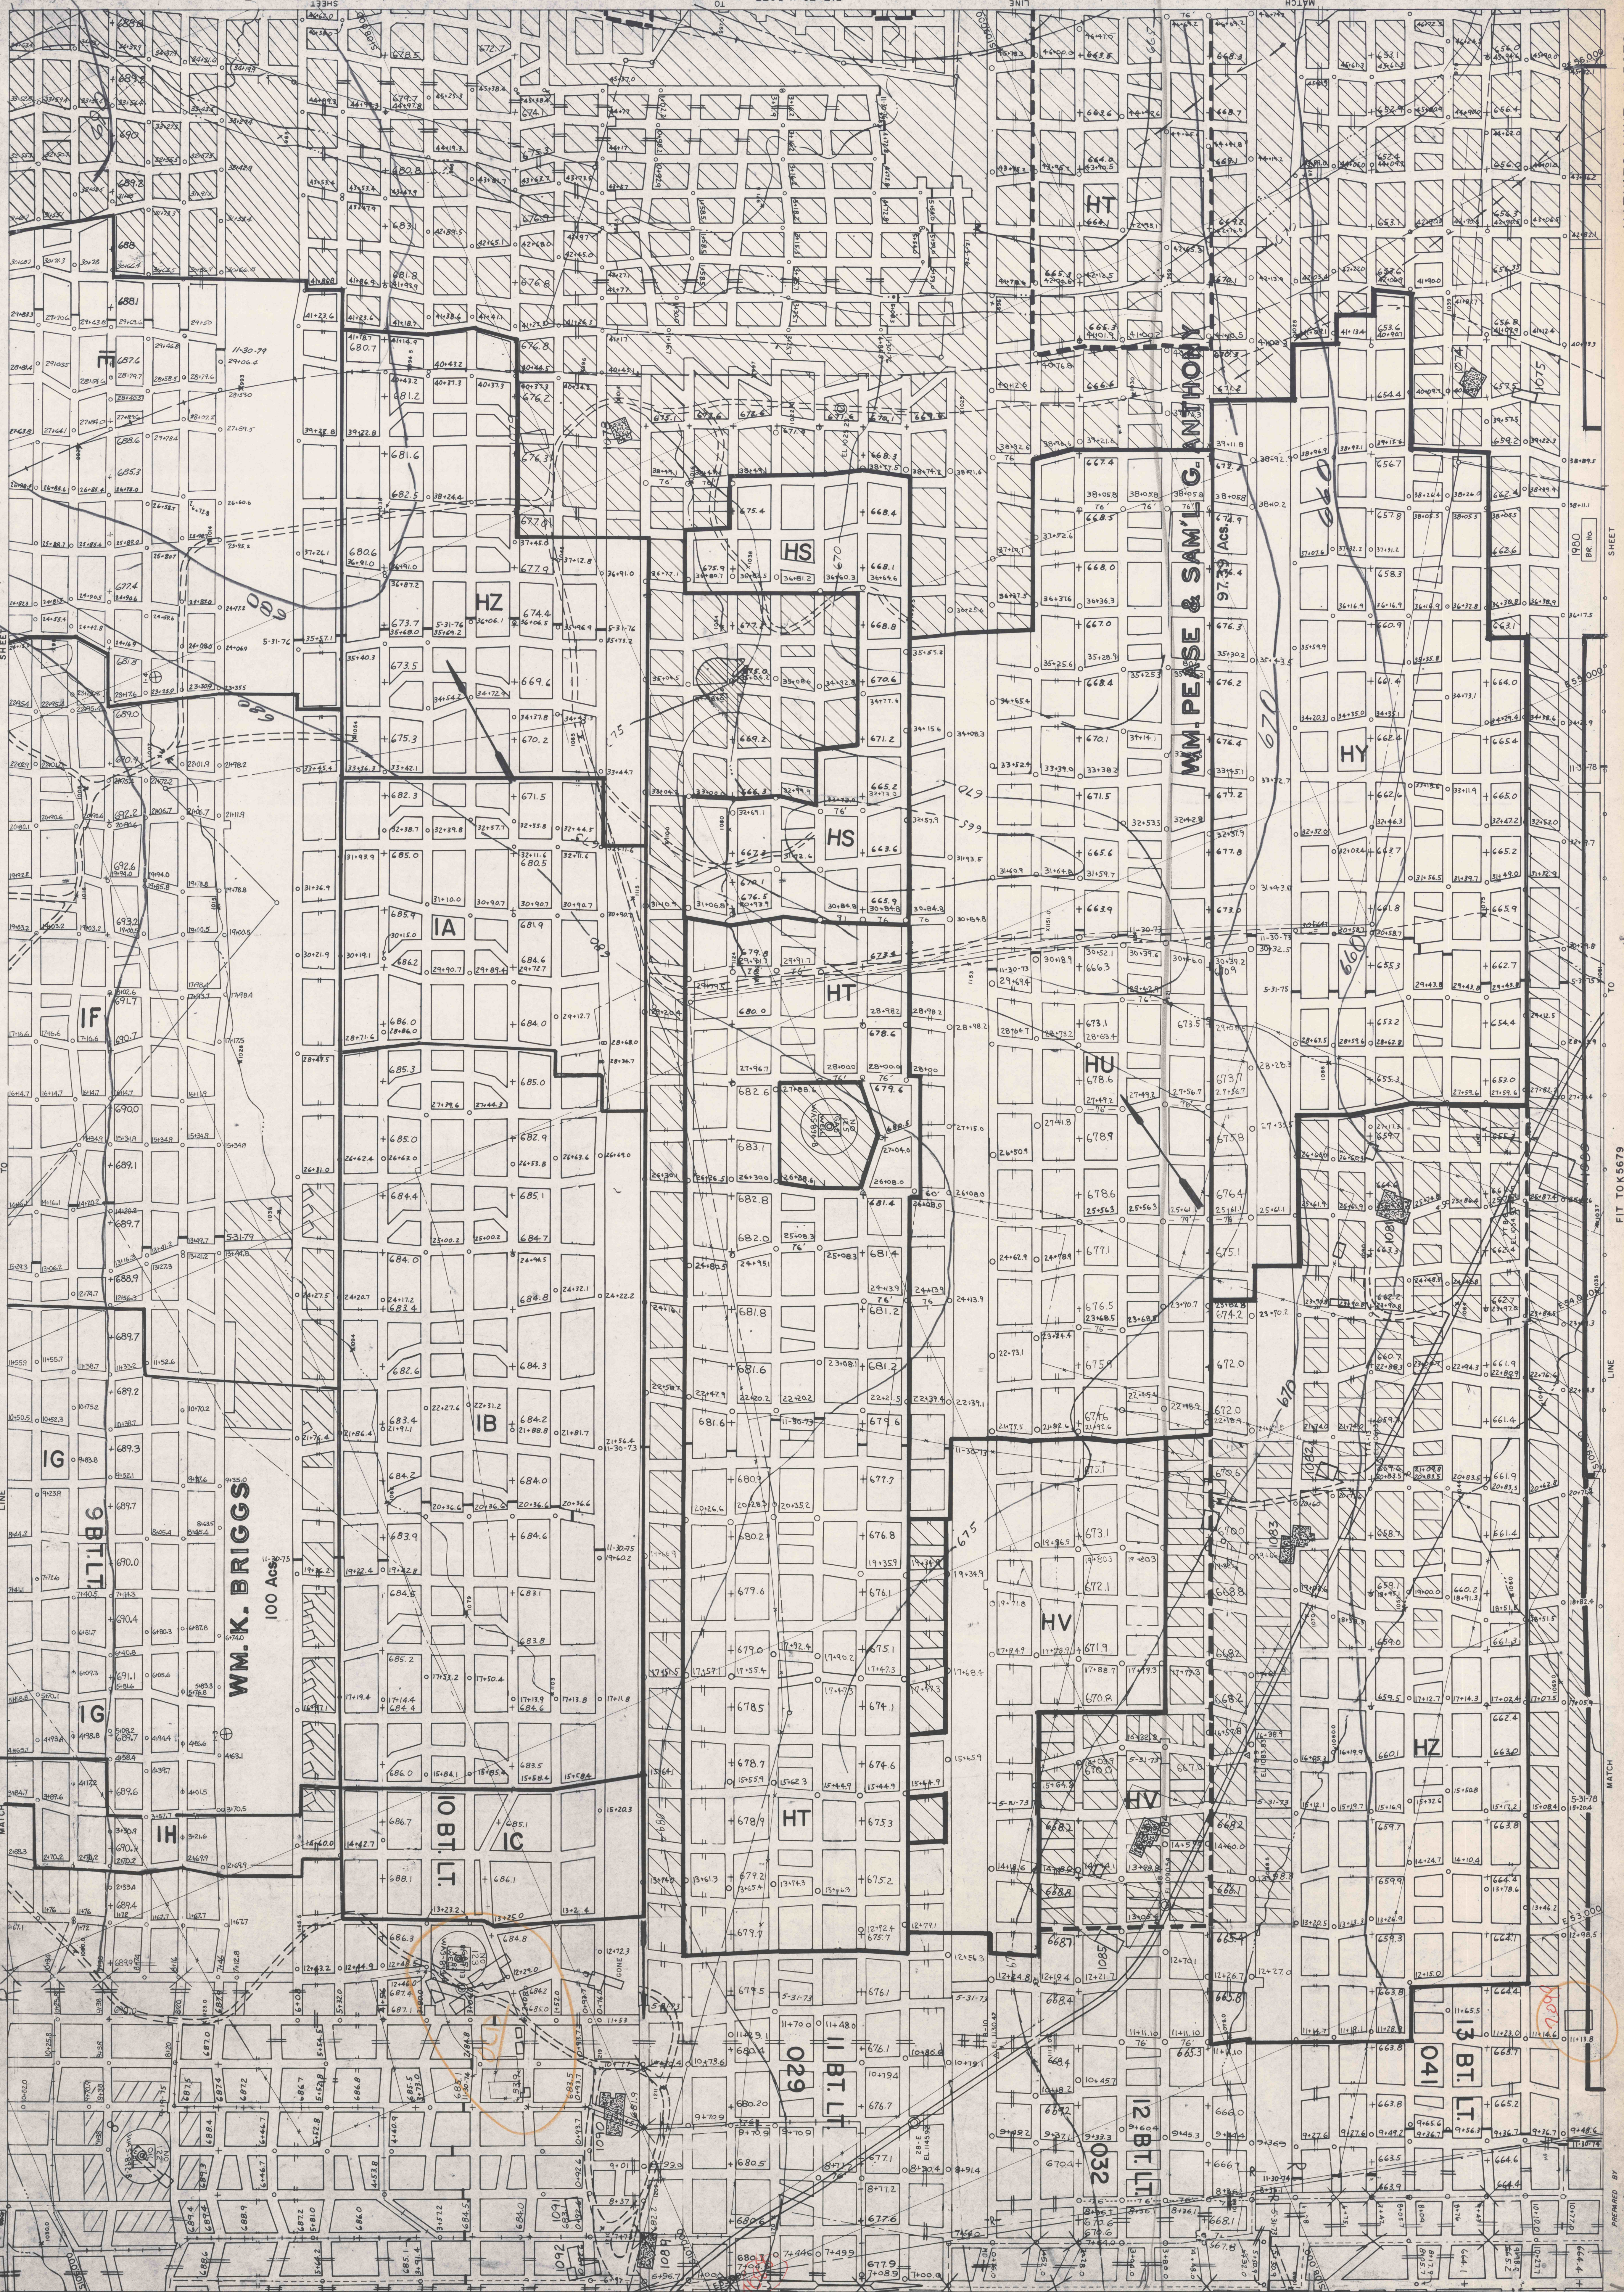

FIT TO K-5668

FIT TO K-5679

SCALE 1" = 100'

K5672

FIT TO K-5670

PREPARED BY  
AERIAL MAP SERVICE CO.  
PITTSBURGH, PENNA.