

HARRISON MINE K 5192

AMELIA M. DRAKE
S 28 A.

FIT TO K-5201



OFFICE

COVERDALE OR NO. 8 MINE
P.T.C. CORP.

MINED OUT

BOUNDARY LINE

LINE

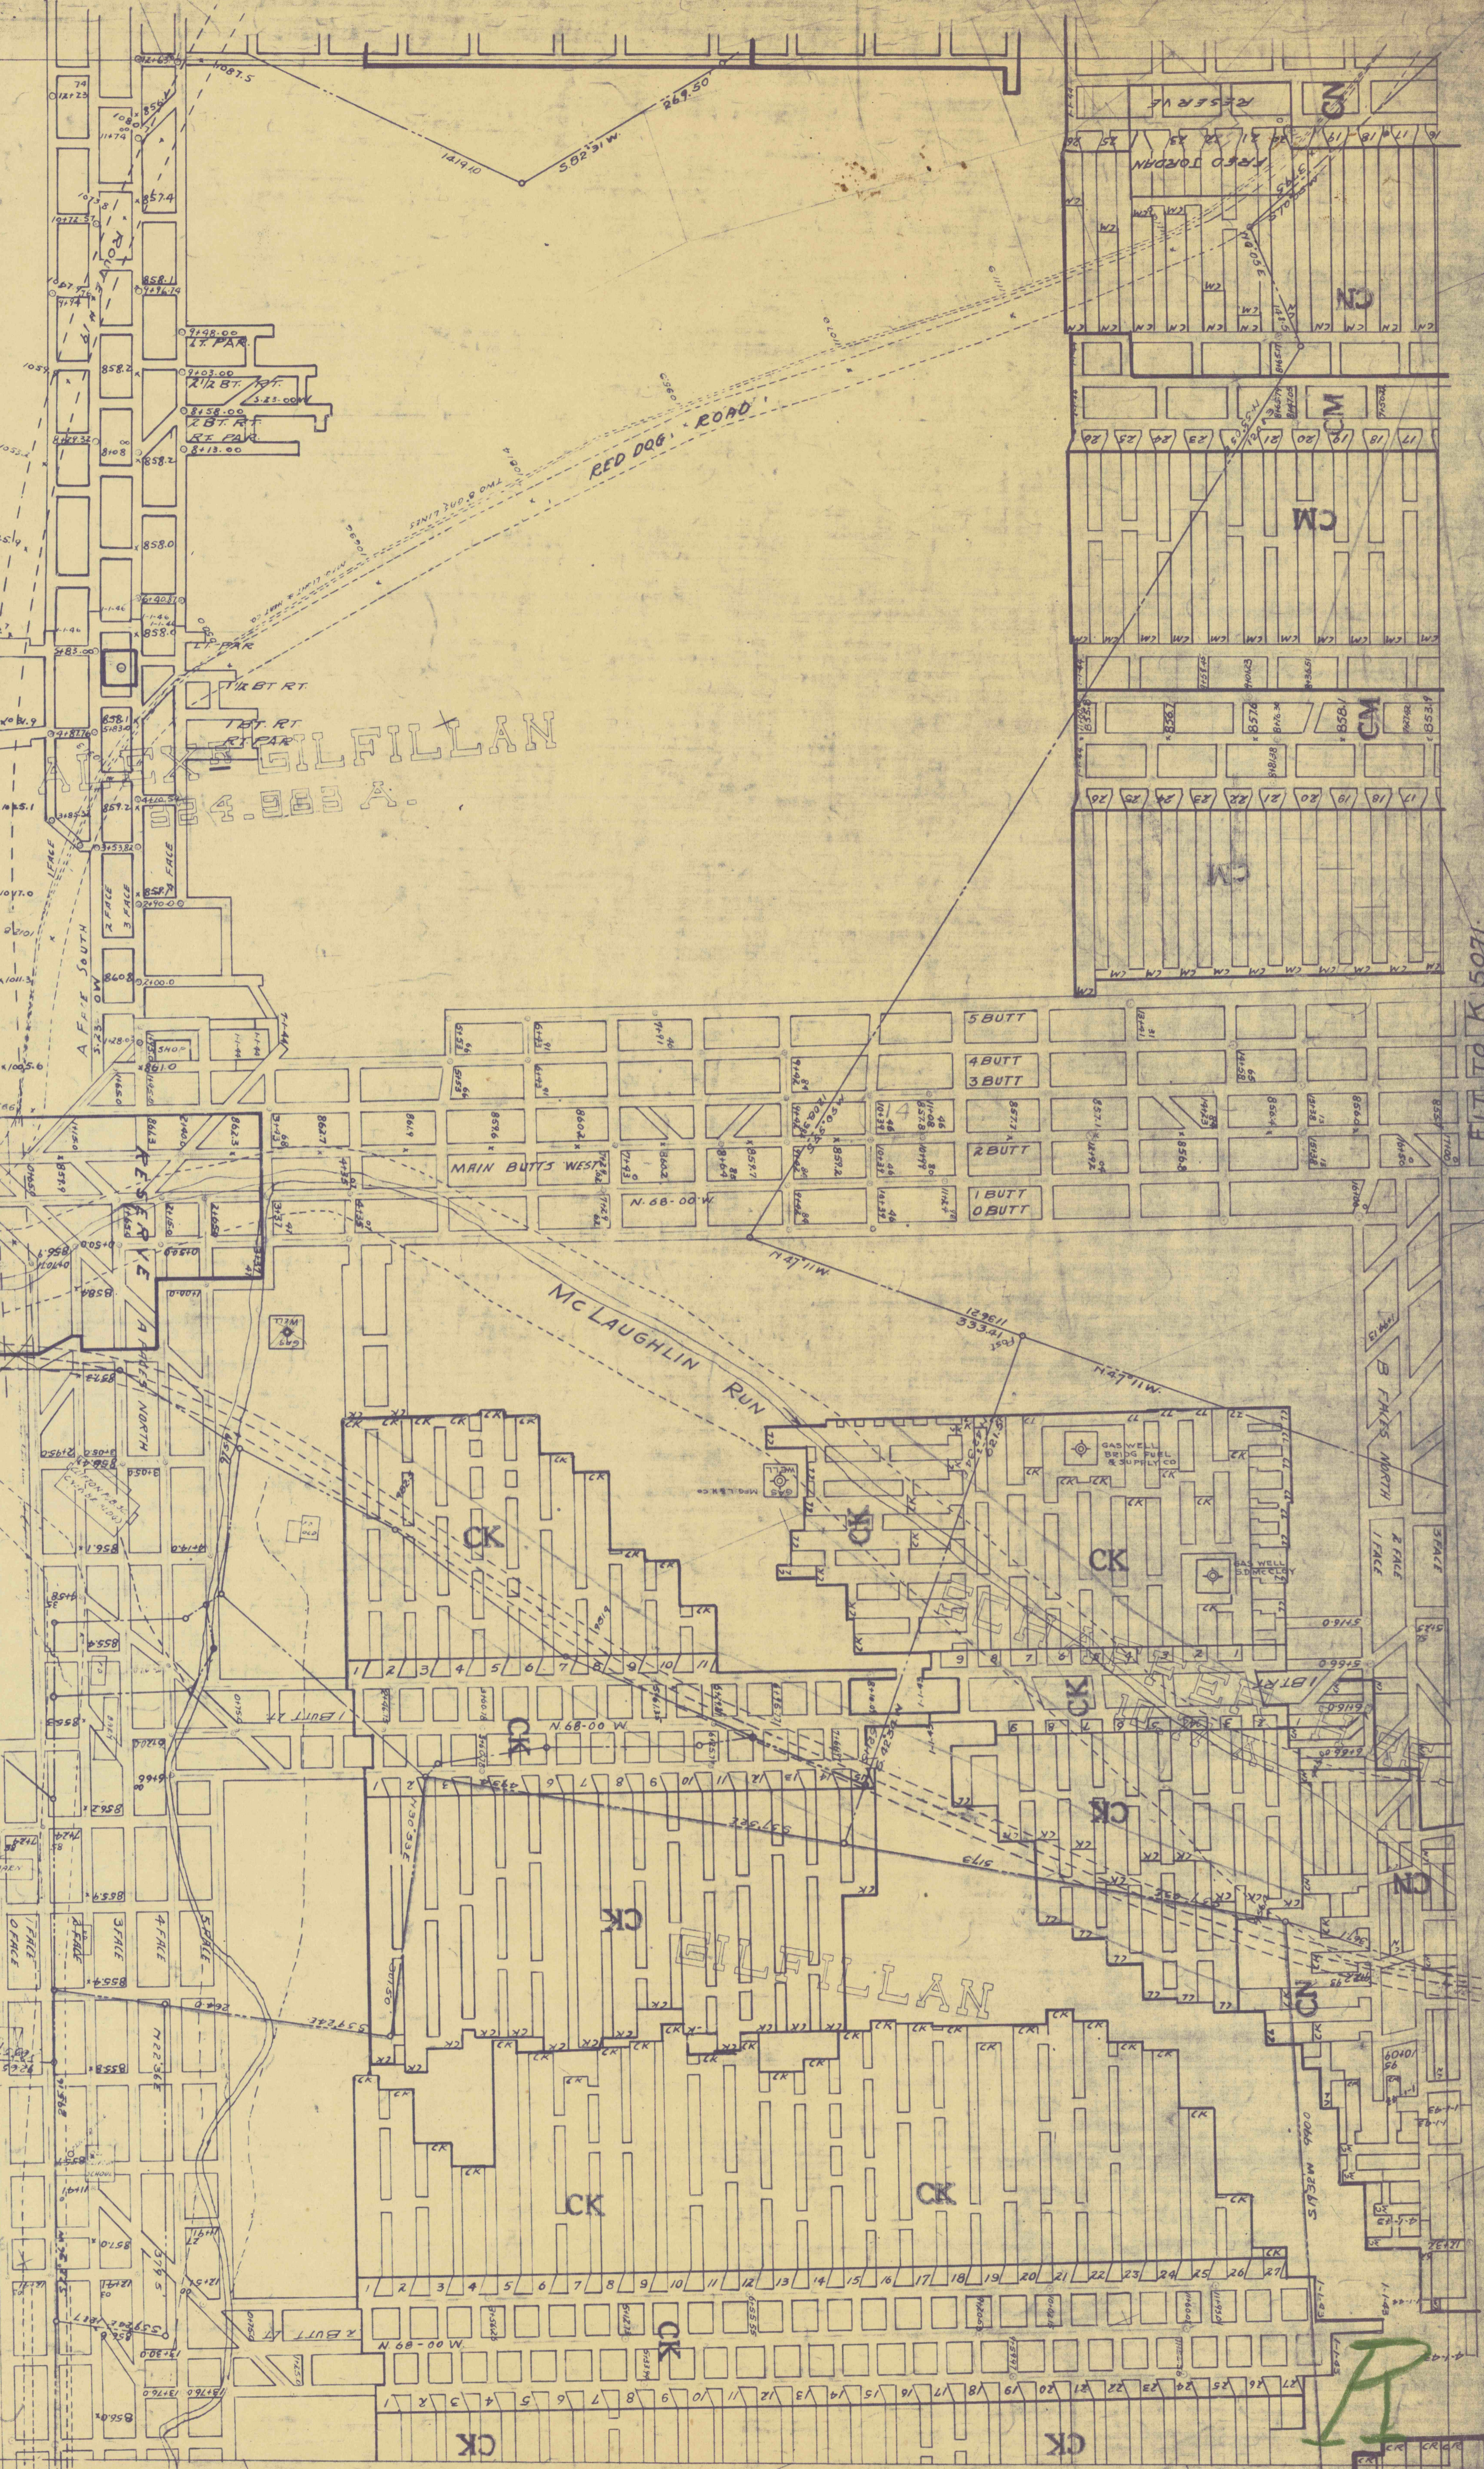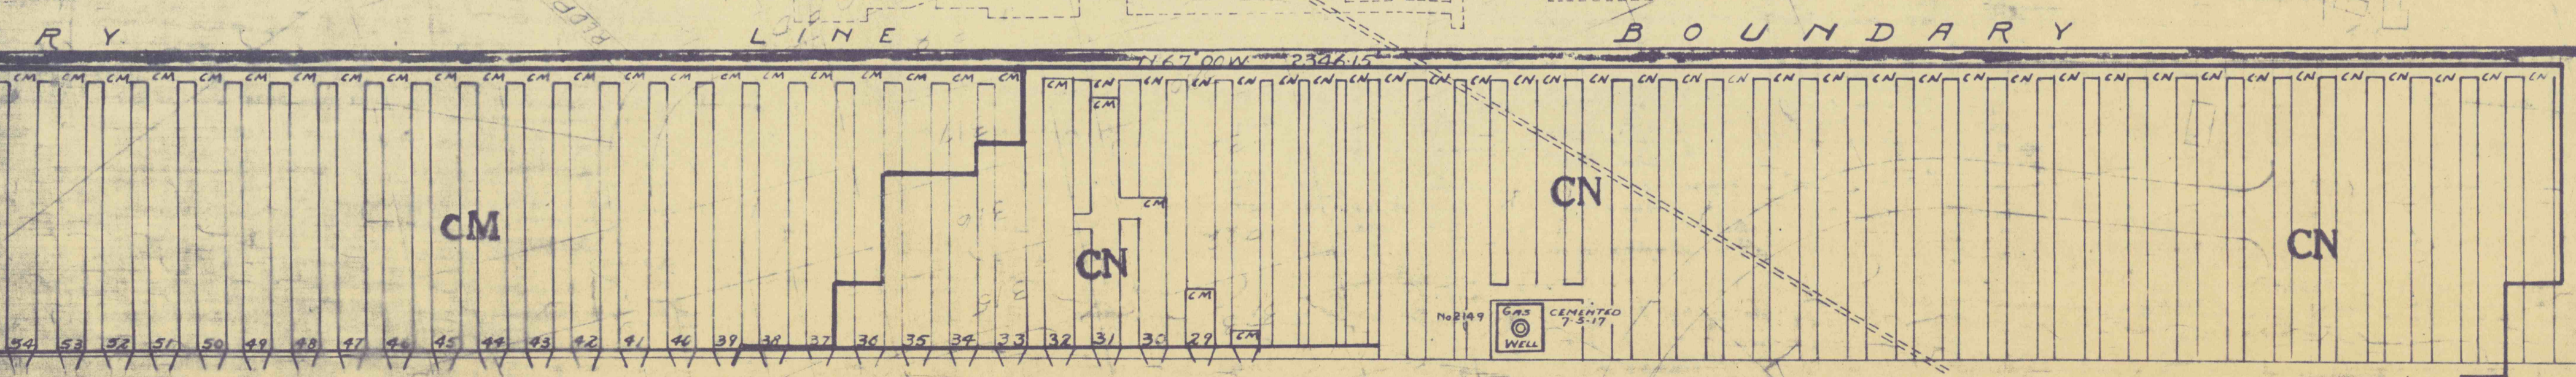

FIT TO K 5071

FIT TO K 5191

HARRISON MINE K 5192

Handwritten initials 'A'