


SAMUEL CONNER
38A BIP (includes part sold)

MINED OUT

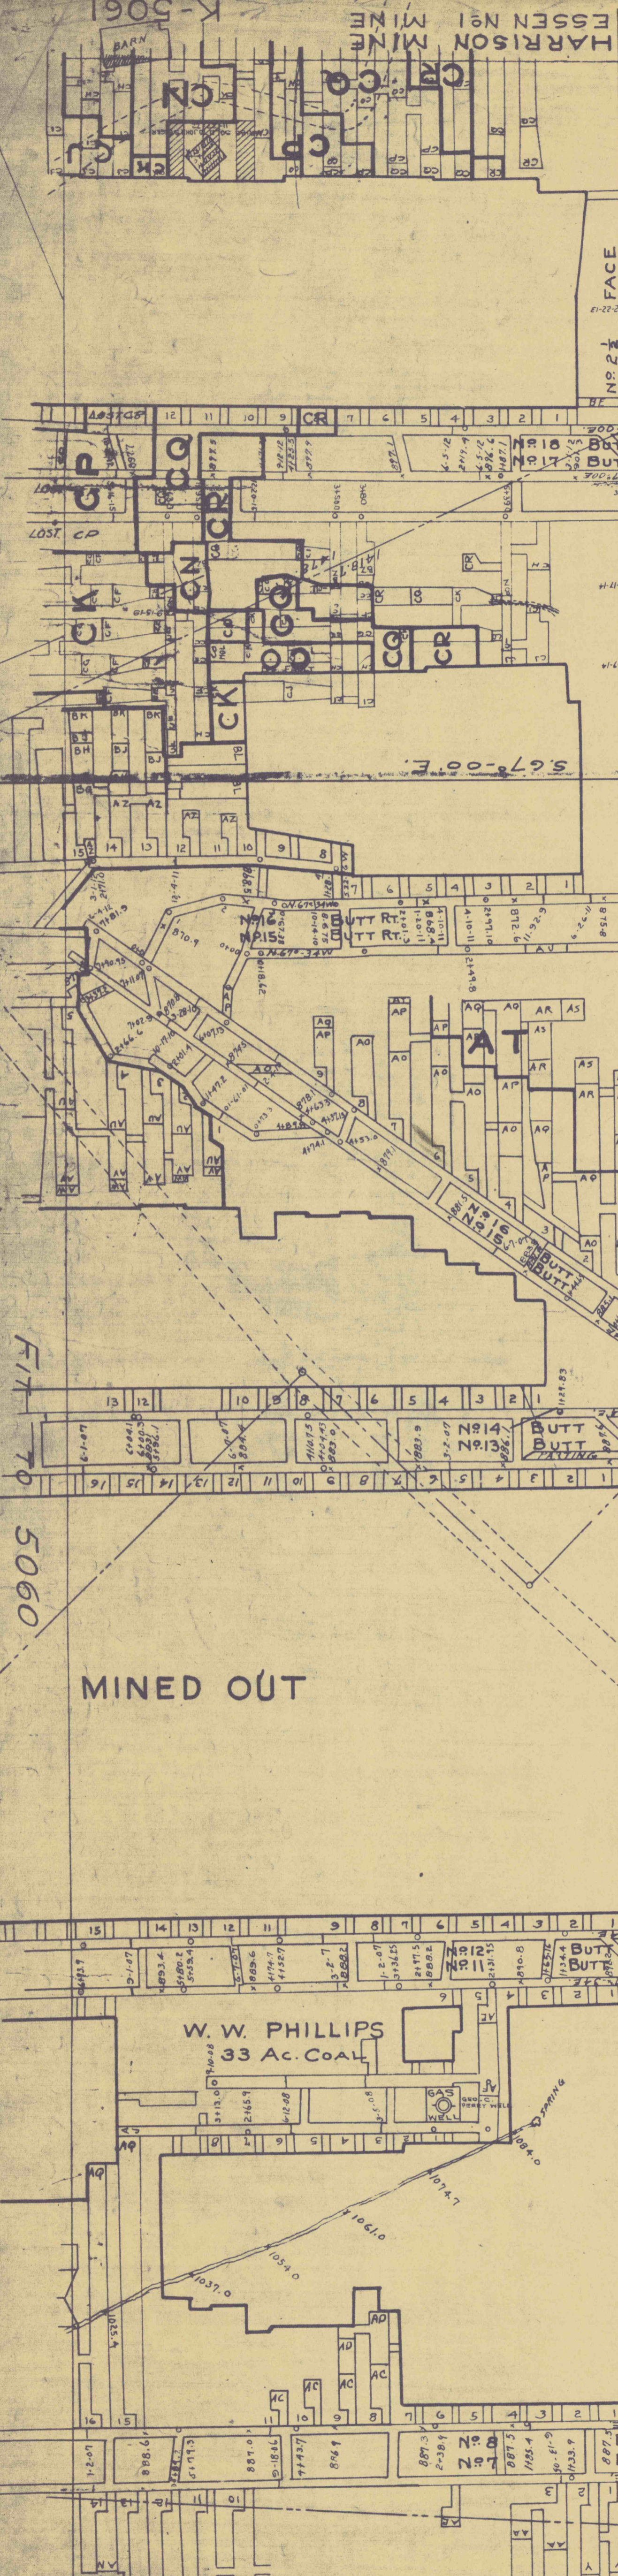

MINED OUT

W. W. PHILLIPS
33 AC. COAL

MULLIGAN
FACE

MINED OUT

HIRAM CONNER
Total Area 30.375 Ac.

P.C. CO. TO LOUIS E. SKENDER
5.40 AC. 7-1-31
HANNAH J. LEE ET AL.
8.40 AC.
P.C. CO. SURFACE

ALEXANDER MORGAN
Total Area 23.908 Ac.

WITCH HAZEL MINE
NOT OWNED BY PENNA. MINING CO.

RESERVATION 2 ACRES

MINED OUT

THERESIA JUNG
Total Area 4.837 Ac.

Enough coal to be left
to surface buildings
to be left

GRIMM
Surface Owned
by Grimm & Jones
P. C. Co. Cut

PENNA. MINING CO. TO
WITCH HAZEL COAL CO.
CAL. AREA 8.7 ACRES

F