
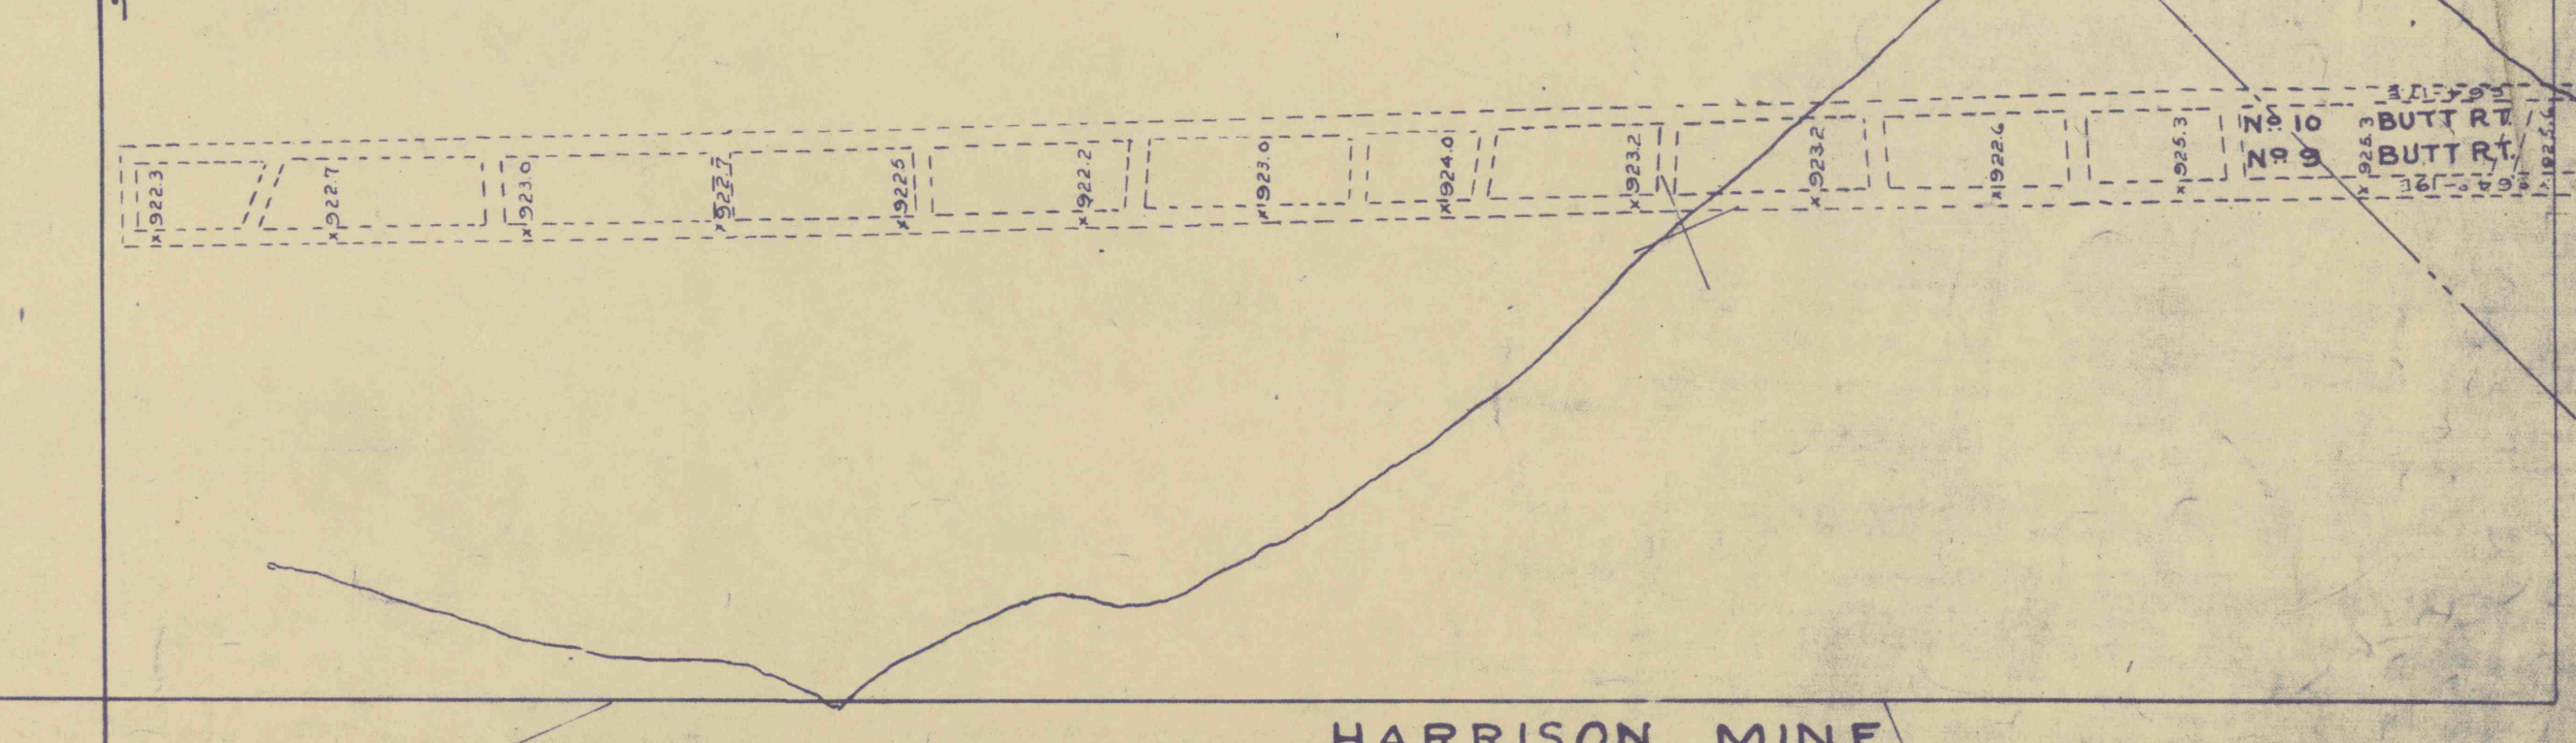
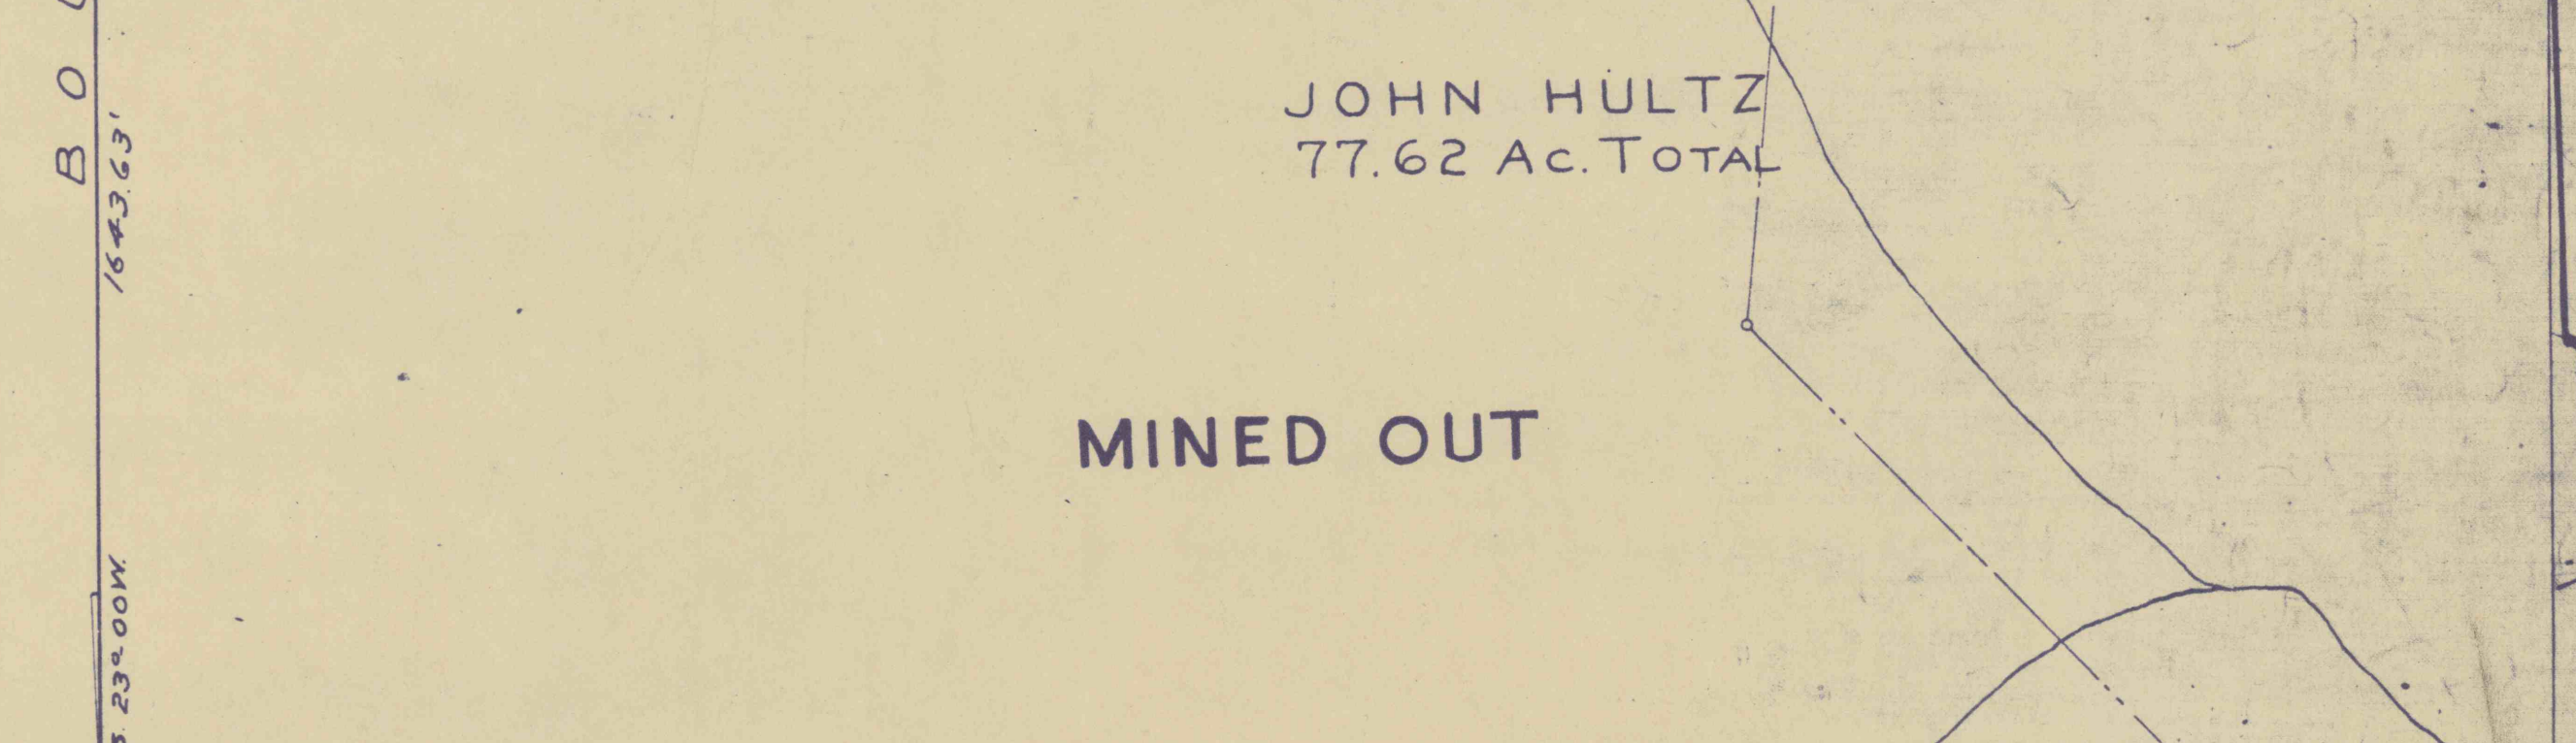
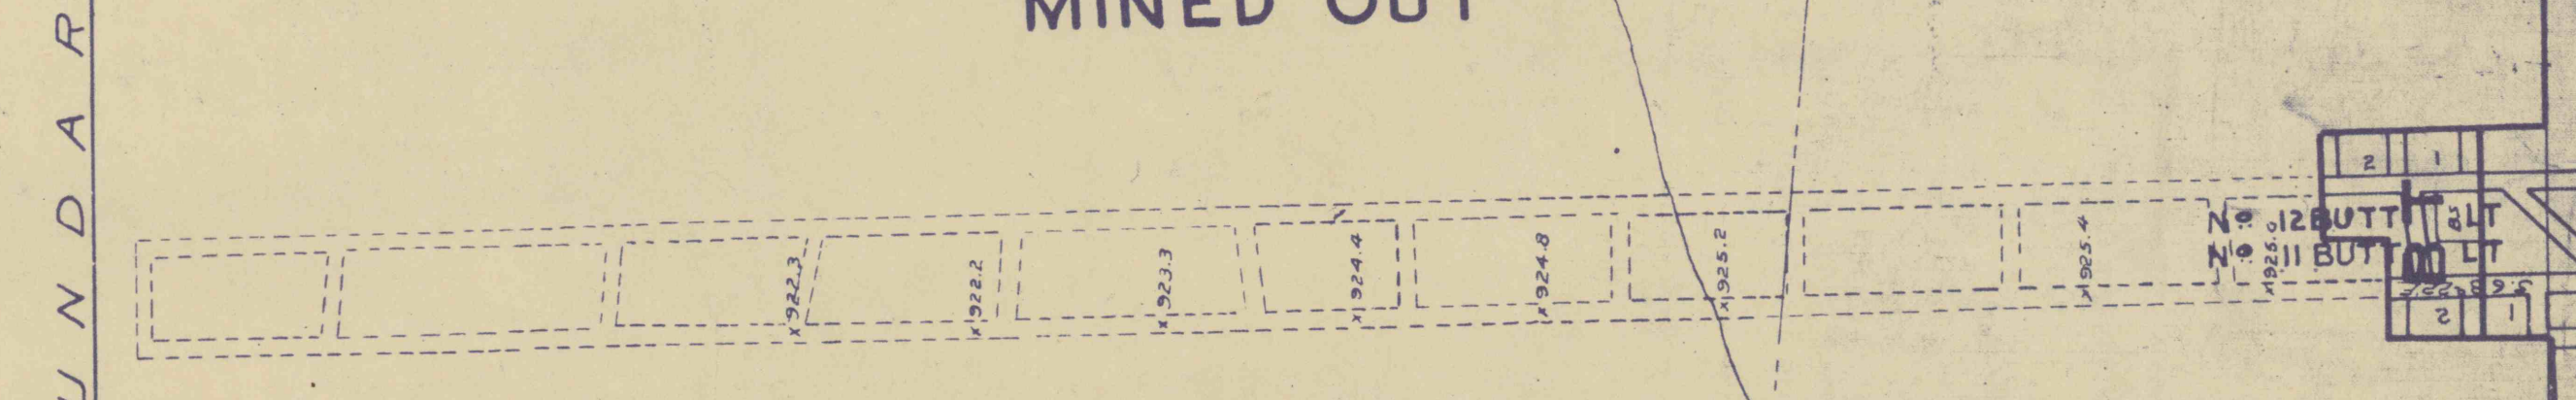
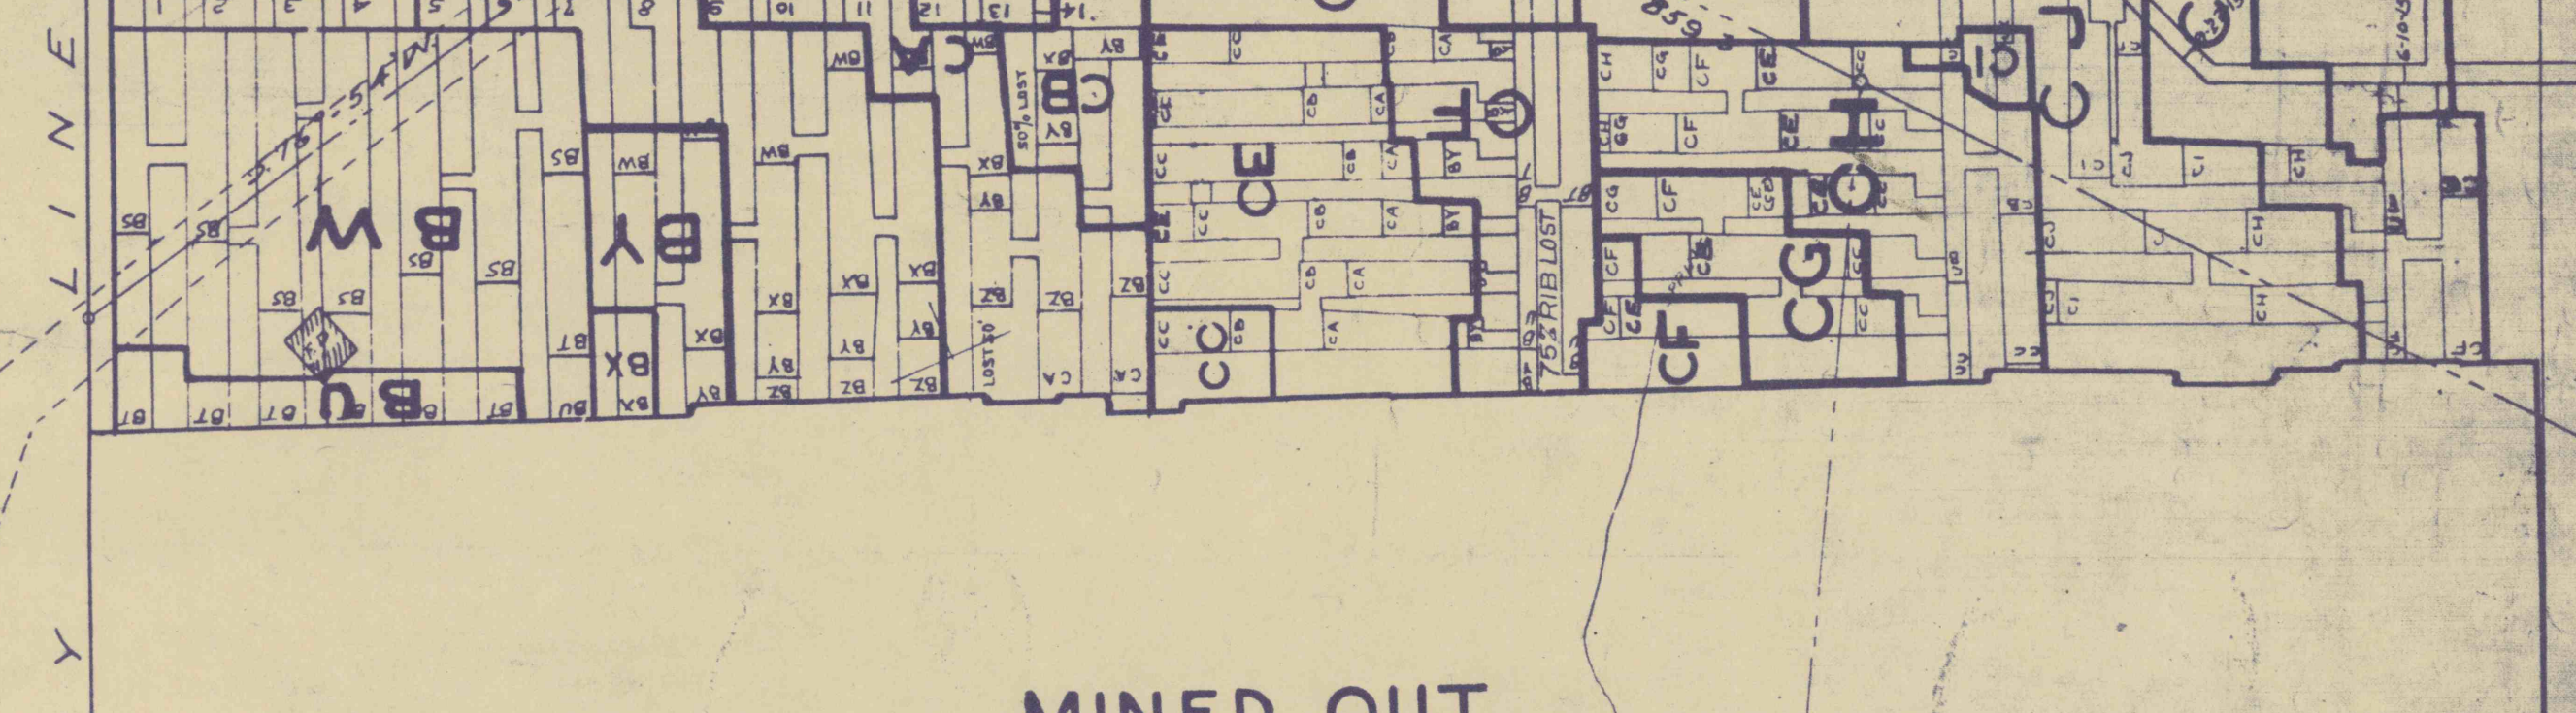
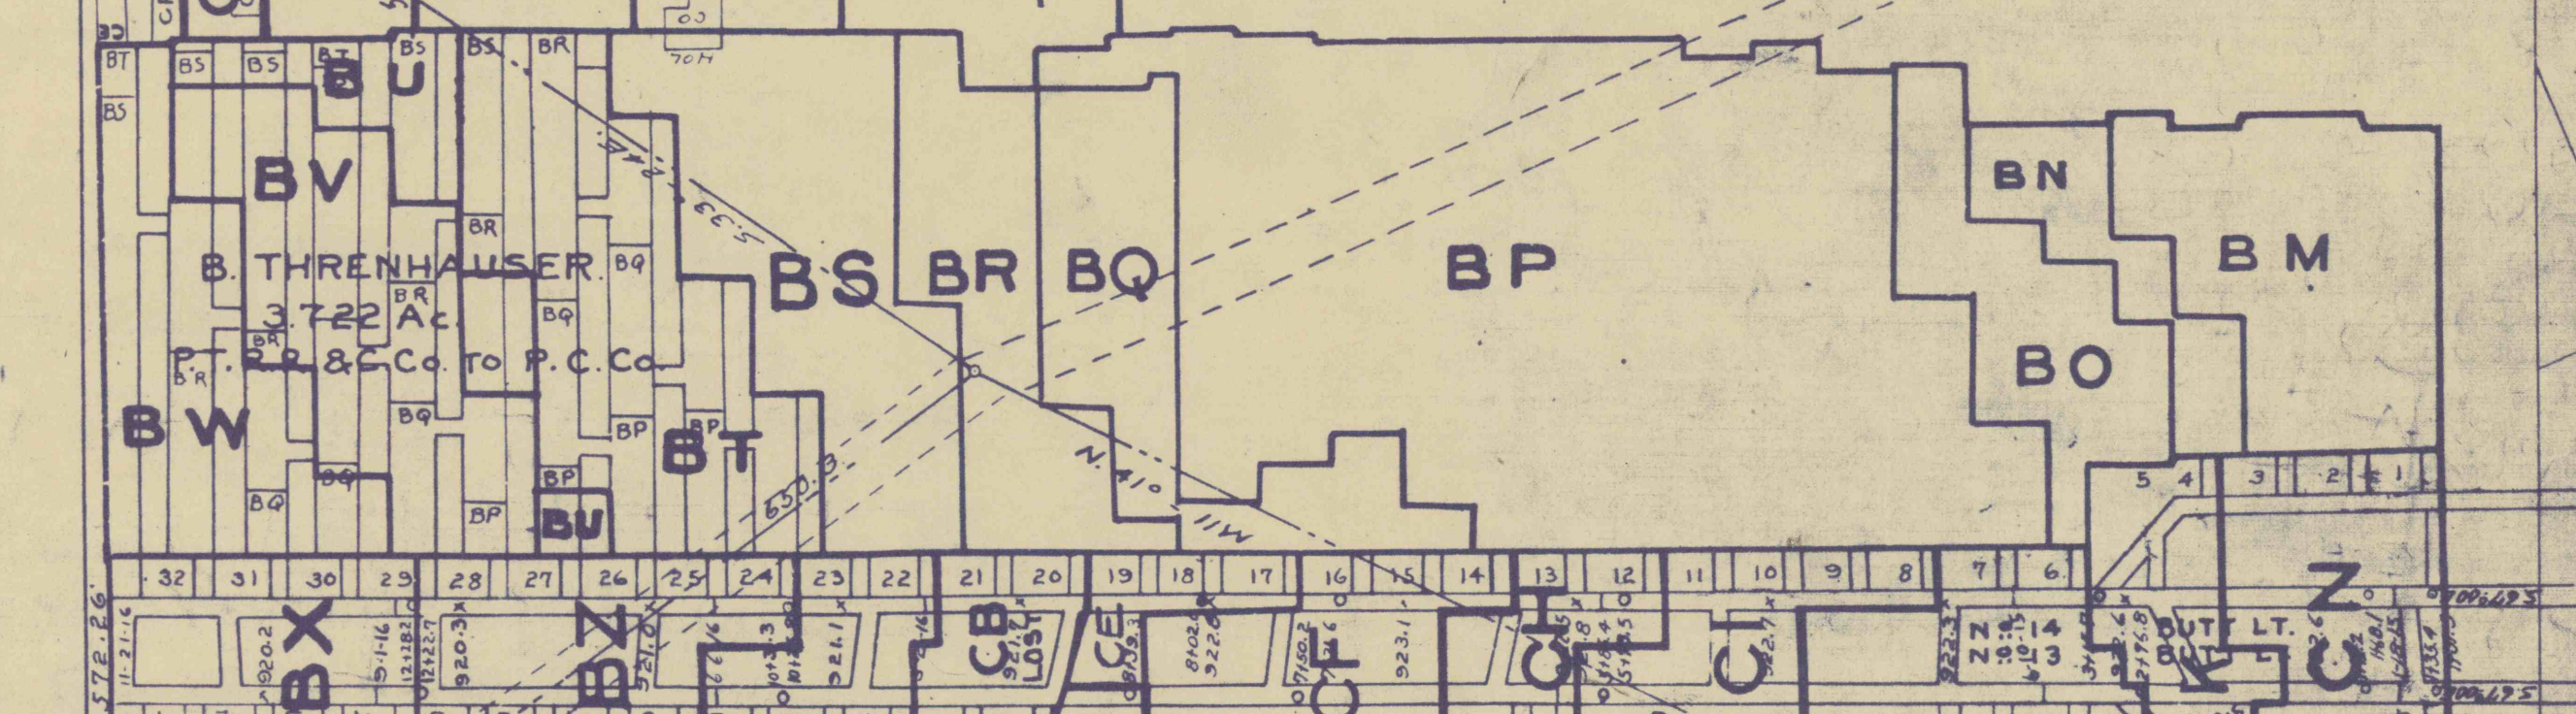
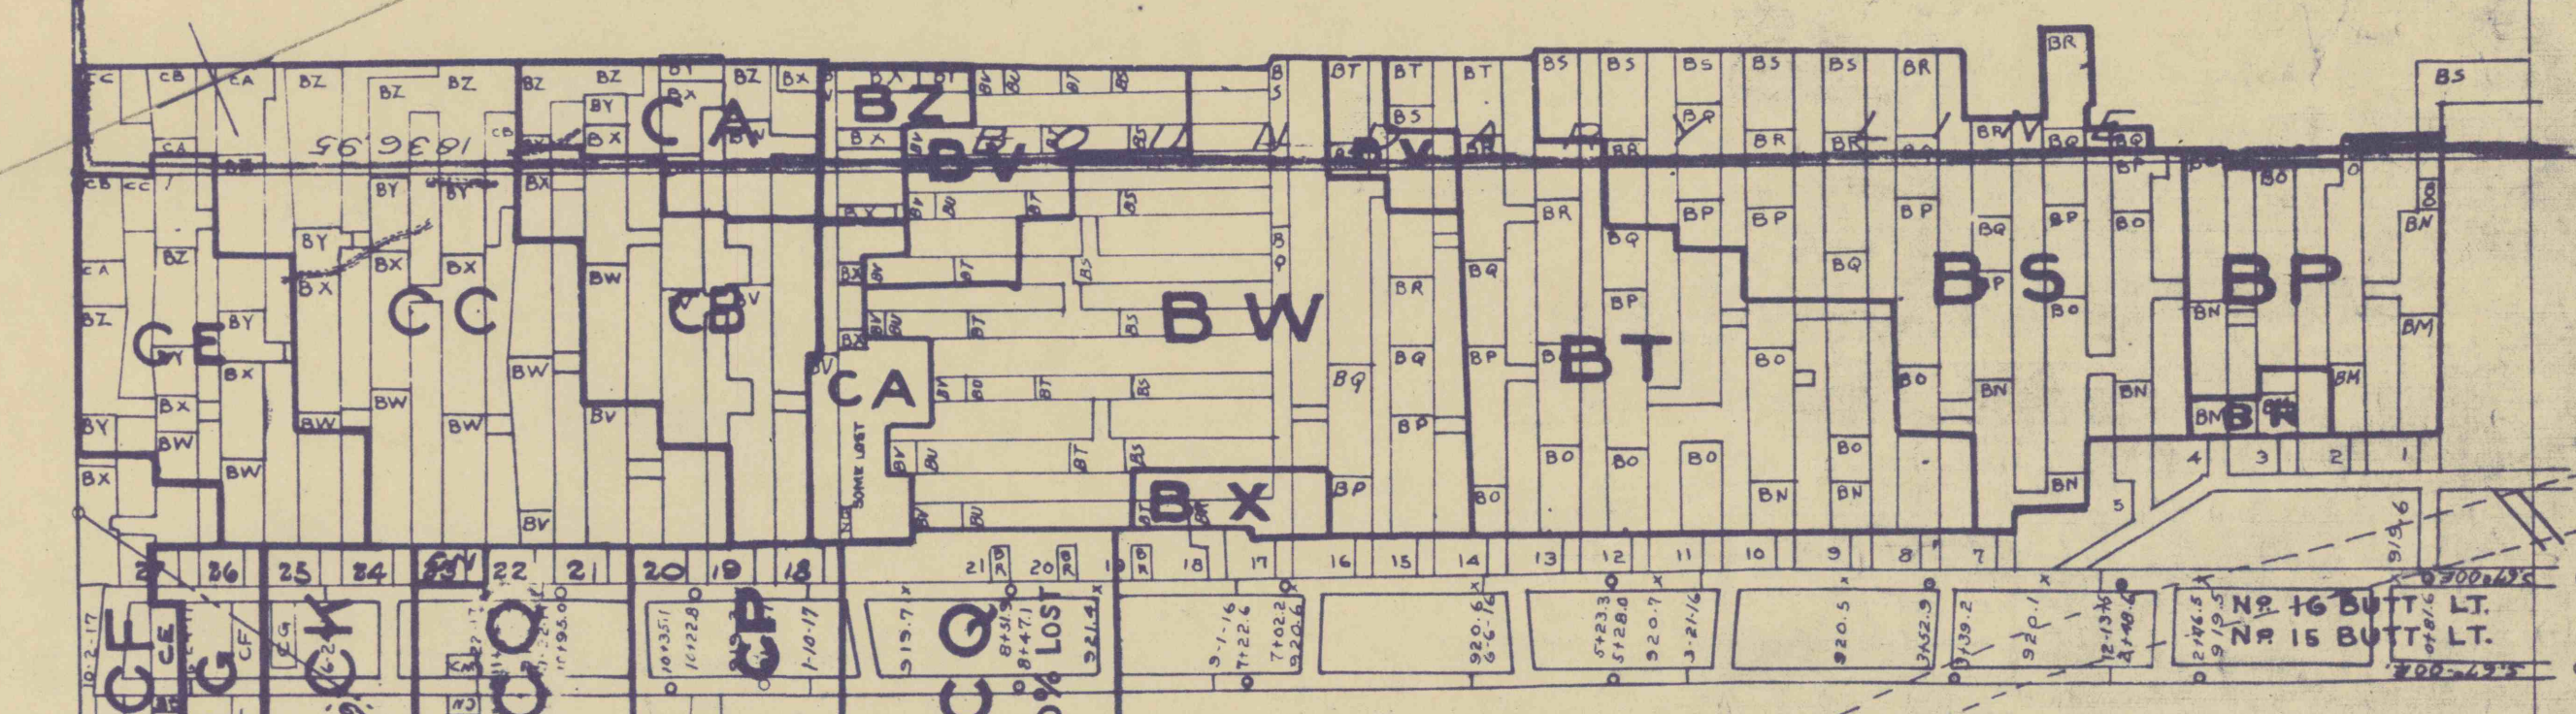


5

MINE No. 3

P.T.R.R. & C. Co.

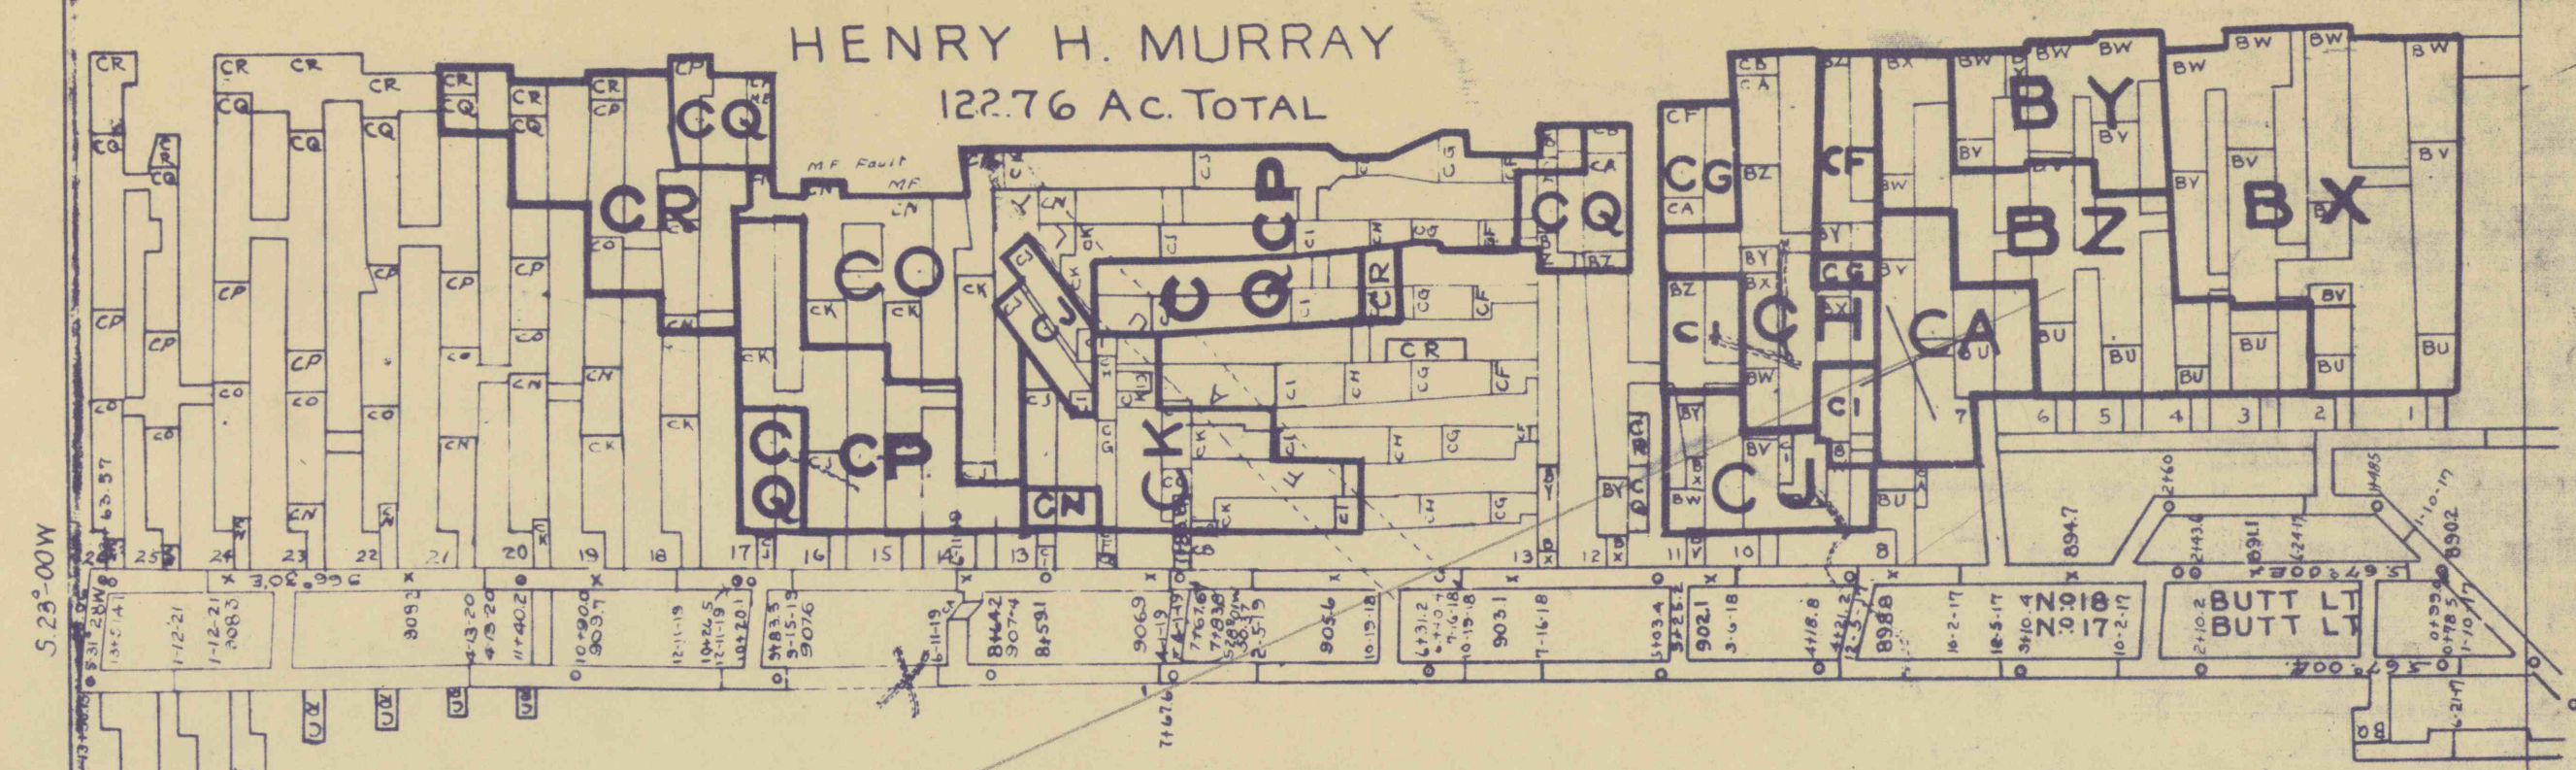

BOUNDARY

MINED OUT

MINED OUT

JOHN HULTZ
77.62 AC. TOTAL