
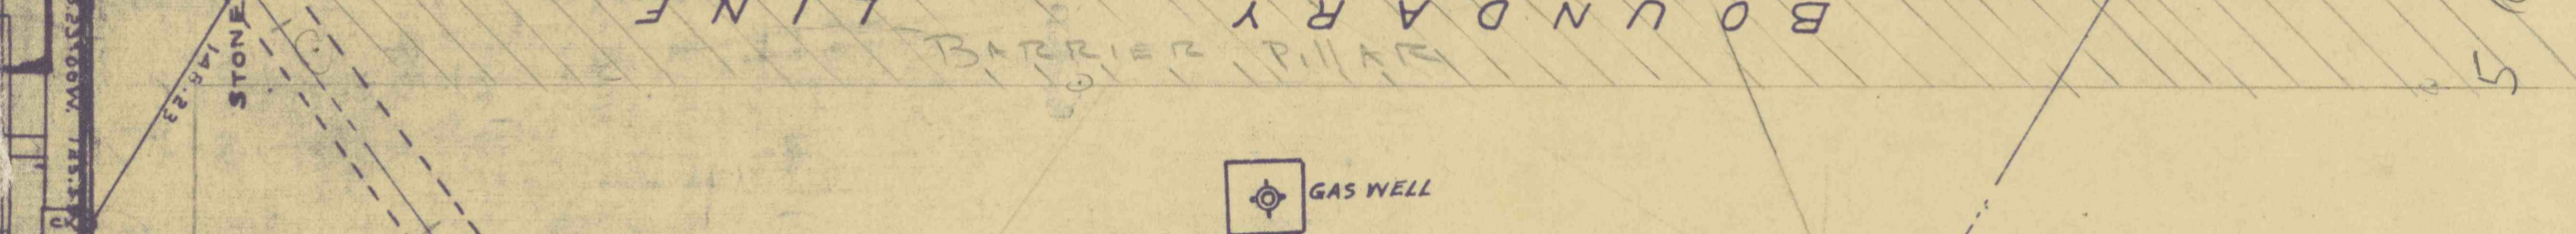
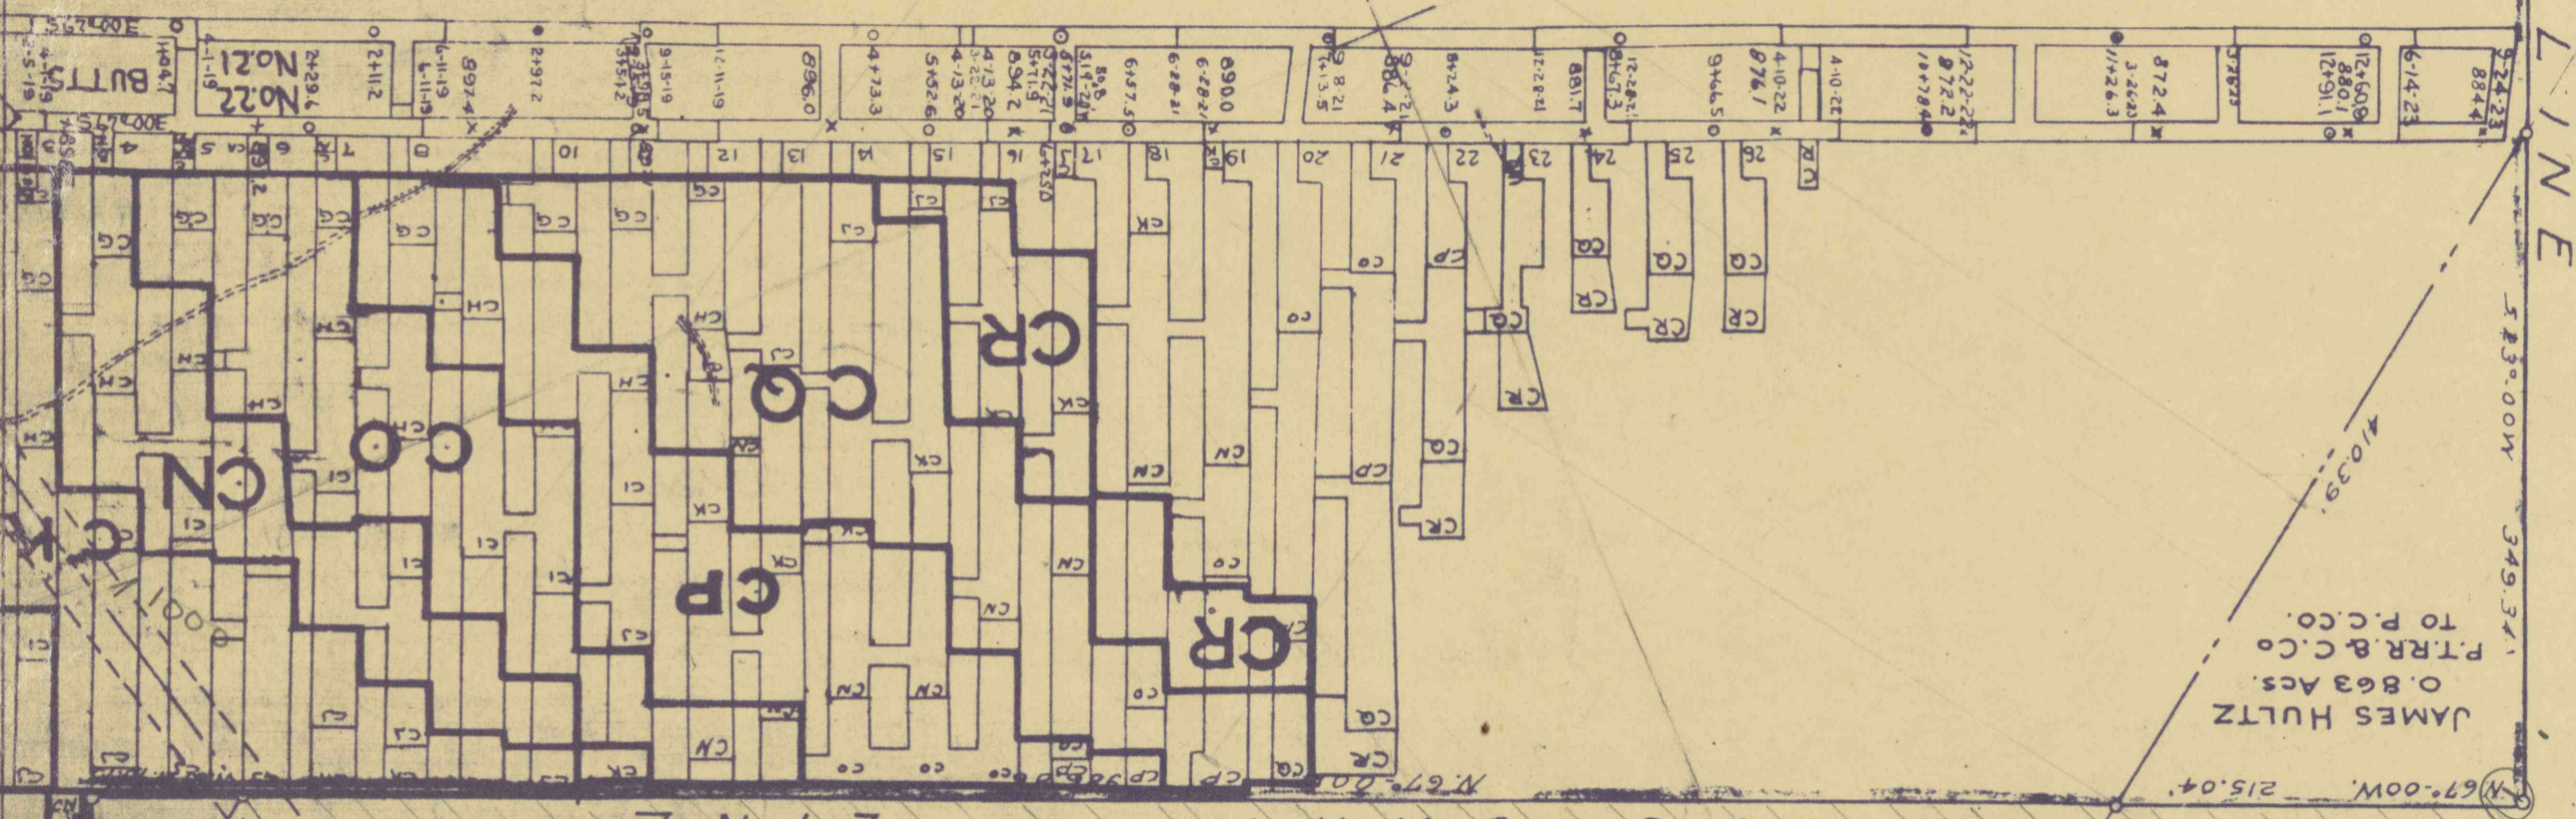


K-5058

HARRISON MINE

FIT TO 5057

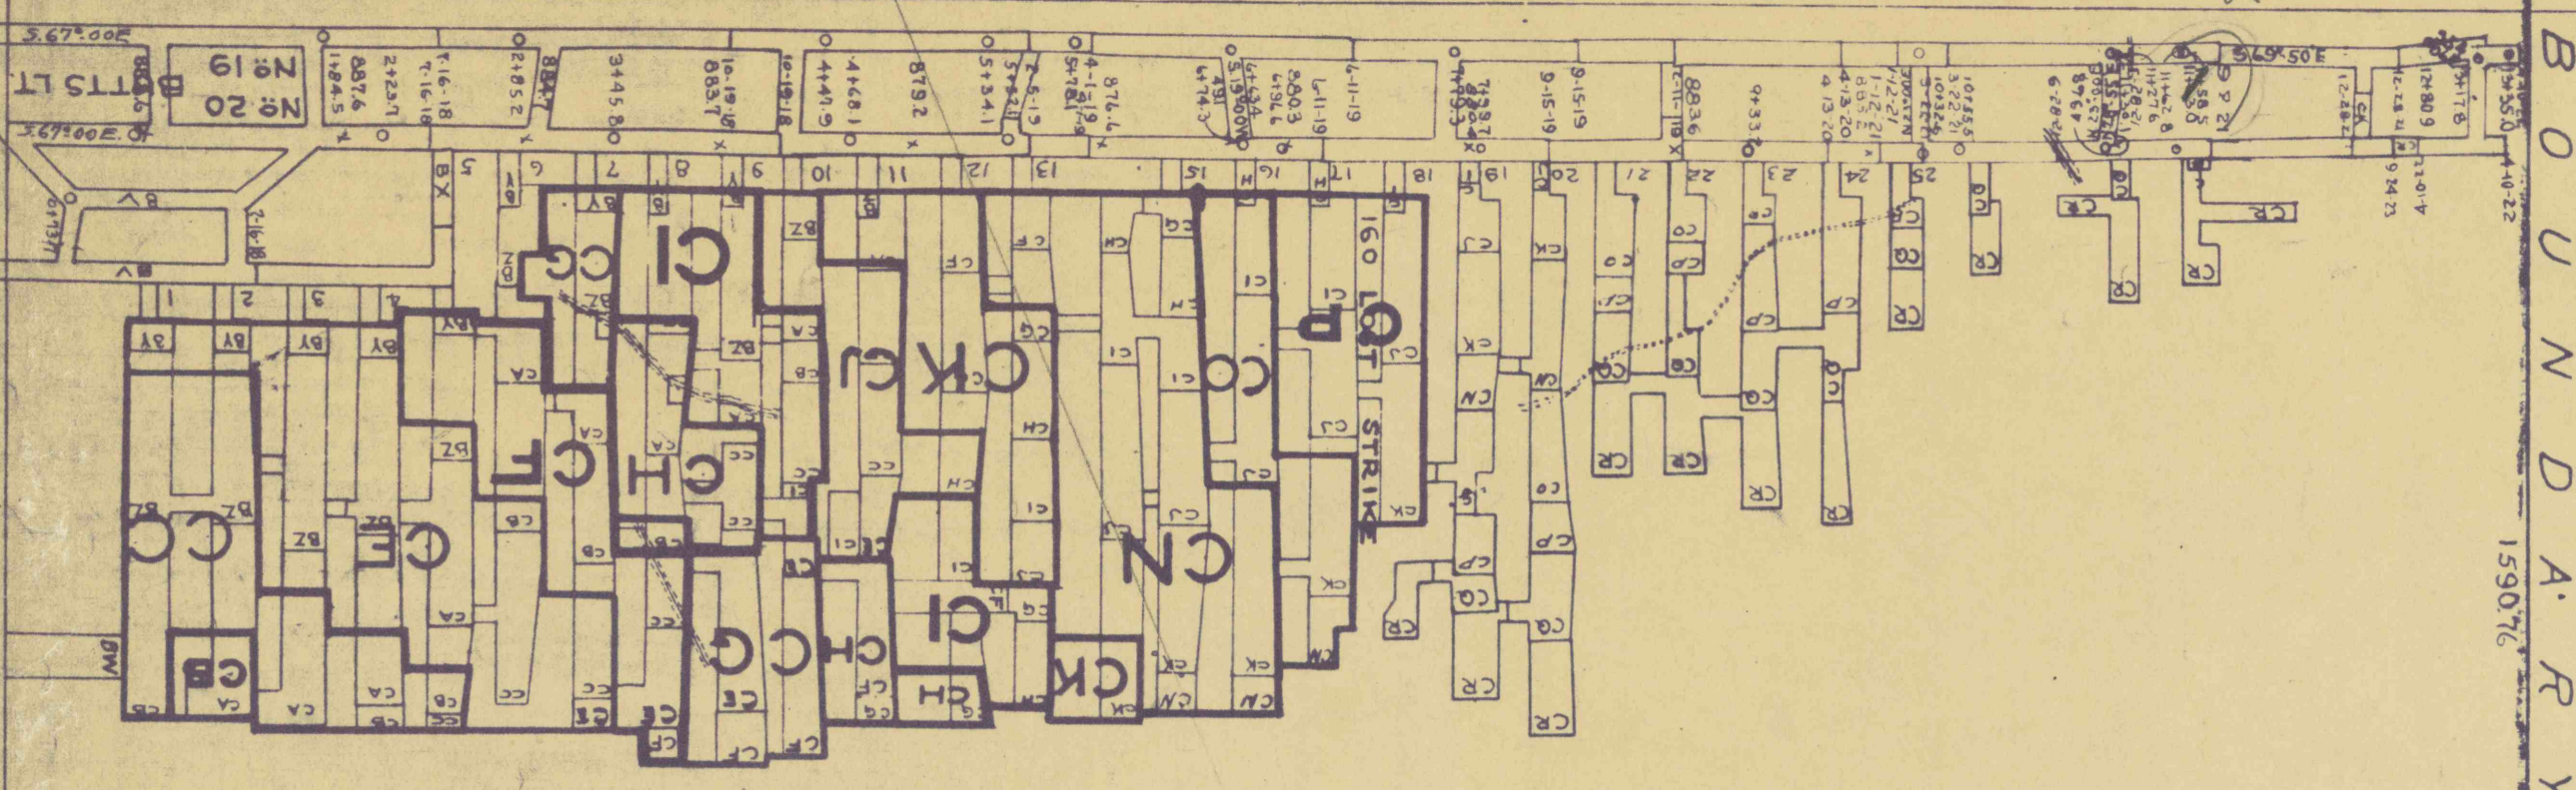

JAMES HULTZ  
 TO P. C. Co.


2 GAS WELLS

GAS WELL




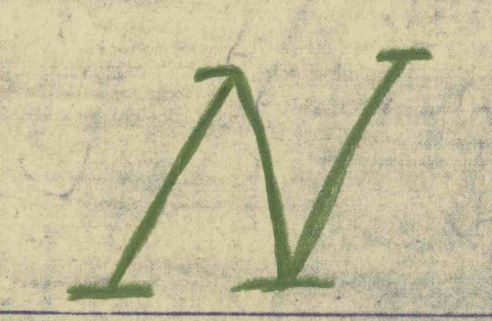

HARRISON MINE K-5058