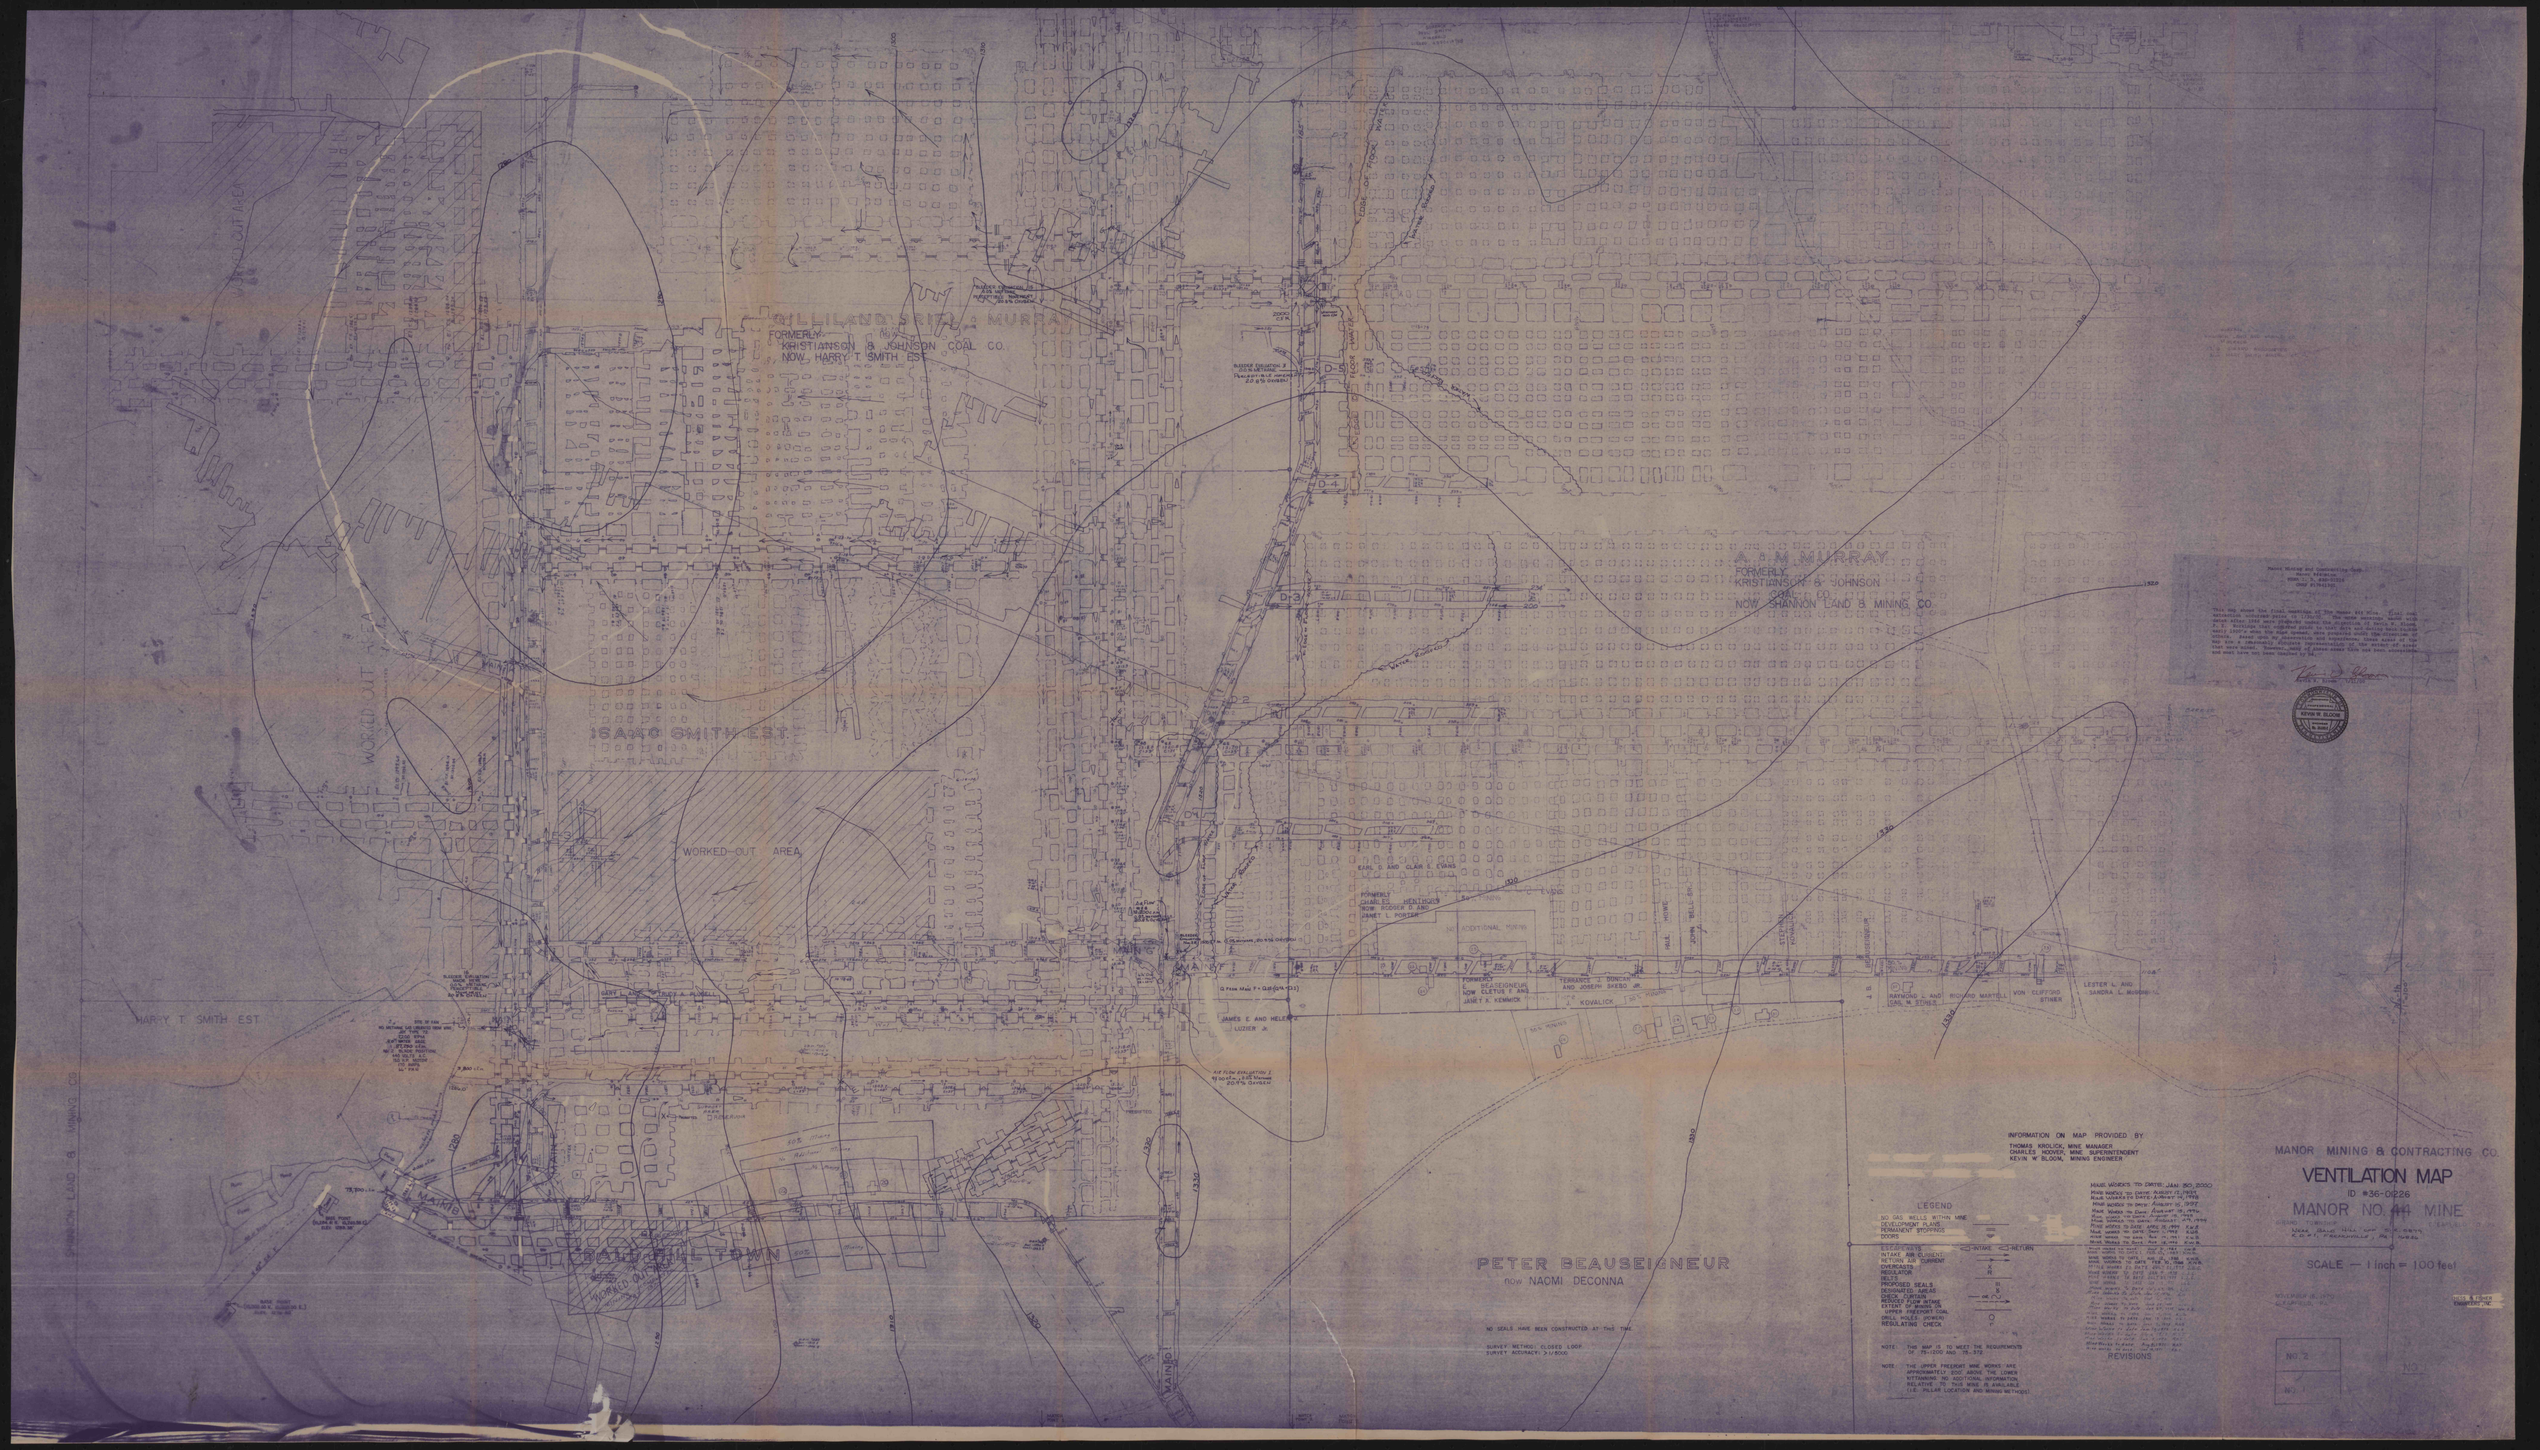

WILLILAND & SRIEL & MURRAY
FORMERLY
KRISTIANSON & JOHNSON COAL CO.
NOW HARRY T. SMITH EST.
A. & M. MURRAY
FORMERLY
KRISTIANSON & JOHNSON
COAL CO.
NOW SHANNON LAND & MINING CO.
ISAAC SMITH EST.
WORKED-OUT AREA
HARRY T. SMITH EST.
SHANNON LAND & MINING CO.
PETER BEAUSEIGNEUR
now NAOMI DECONNA
NO SEALS HAVE BEEN CONSTRUCTED AT THIS TIME.
SURVEY METHOD: CLOSED LOOP
SURVEY ACCURACY: >1/5000
INFORMATION ON MAP PROVIDED BY
THOMAS KROLICK, MINE MANAGER
CHARLES HOOVER, MINE SUPERINTENDENT
KEVIN W. BLOOM, MINING ENGINEER
LEGEND
NO GAS WELLS WITHIN MINE
DEVELOPMENT PLANS
PERMANENT STOPPINGS
DOORS
ESCAPEWAYS
INTAKE AIR CURRENT
RETURN AIR CURRENT
OVERCASTS
REGULATOR
BELTS
PROPOSED SEALS
DESIGNATED AREAS
CHECK CURTAIN
REDUCED FLOW INTAKE
EXTENT OF WORKS ON
UPPER FREEPORT COAL
DRILL HOLES (POWER)
REGULATING CHECK
NOTE: THIS MAP IS TO MEET THE REQUIREMENTS OF 75-1200 AND 75-372
NOTE: THE UPPER FREEPORT MINE WORKS ARE APPROXIMATELY 200' ABOVE THE LOWER WITTANNING. NO ADDITIONAL INFORMATION RELATIVE TO THIS MINE IS AVAILABLE (I.E. PILLAR LOCATION AND MINING METHODS)
REVISIONS
MANOR MINING & CONTRACTING CO.
VENTILATION MAP
ID #36-01226
MANOR NO. 44 MINE
SCALE — 1 inch = 100 feet
NO. 2
NO. 1