




**LEGEND**

- Regulator
- Proposed Air Flows
- Intake Air
- Return Air
- Belt Air
- Belt Line
- Permanent Stopping
- Check Curtain
- Proposed Stopping
- Doors
- Equipment Doors
- Seals
- Survey Station
- Permit Boundary
- Property Line
- Public Road
- Stream
- Mining Completed Area
- Contemplated Mining Area
- Projected Mining TO
- Projection No.
- Survey Date 11-1-00

**ESCAPEWAYS**

- Primary Escapeway
- Secondary Escapeway

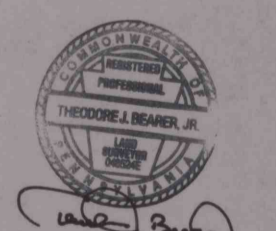


1	2	3	4
14	13	8	3
15	12	9	7
16	11	10	

SHEET 2 OF 16

**ROSEBUD MINING COMPANY**

ROSEBUD NO.2 MINE  
PERRY TWP. ARMSTRONG CO.

LOWER KITTANNING COAL SEAM  
SCALE: 1"=100'

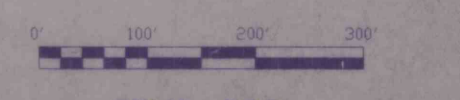

FINAL MAP