


**LEGEND**

- Regulator
- Proposed Air Flows
- Intake Air
- Return Air
- Belt Air
- Belt Line
- Permanent Stopping
- Check Curtain
- Proposed Stopping
- Doors
- Equipment Doors
- Seals
- Survey Station
- Permit Boundary
- Property Line
- Public Road
- Stream
- Mining Completed Area
- Contemplated Mining Area
- Projected Mining TO
- Projection No.
- Survey Date 11-1-00

**ESCAPEWAYS**

- Primary Escapeway
- Secondary Escapeway

FAN DATA  
 Simmons-Rand  
 Model -AMF 1600-70-3-A  
 Blade Setting -Fixed  
 5' Low Pressure  
 1180 rpm  
 50 hp  
 480volts  
 Water Gauge

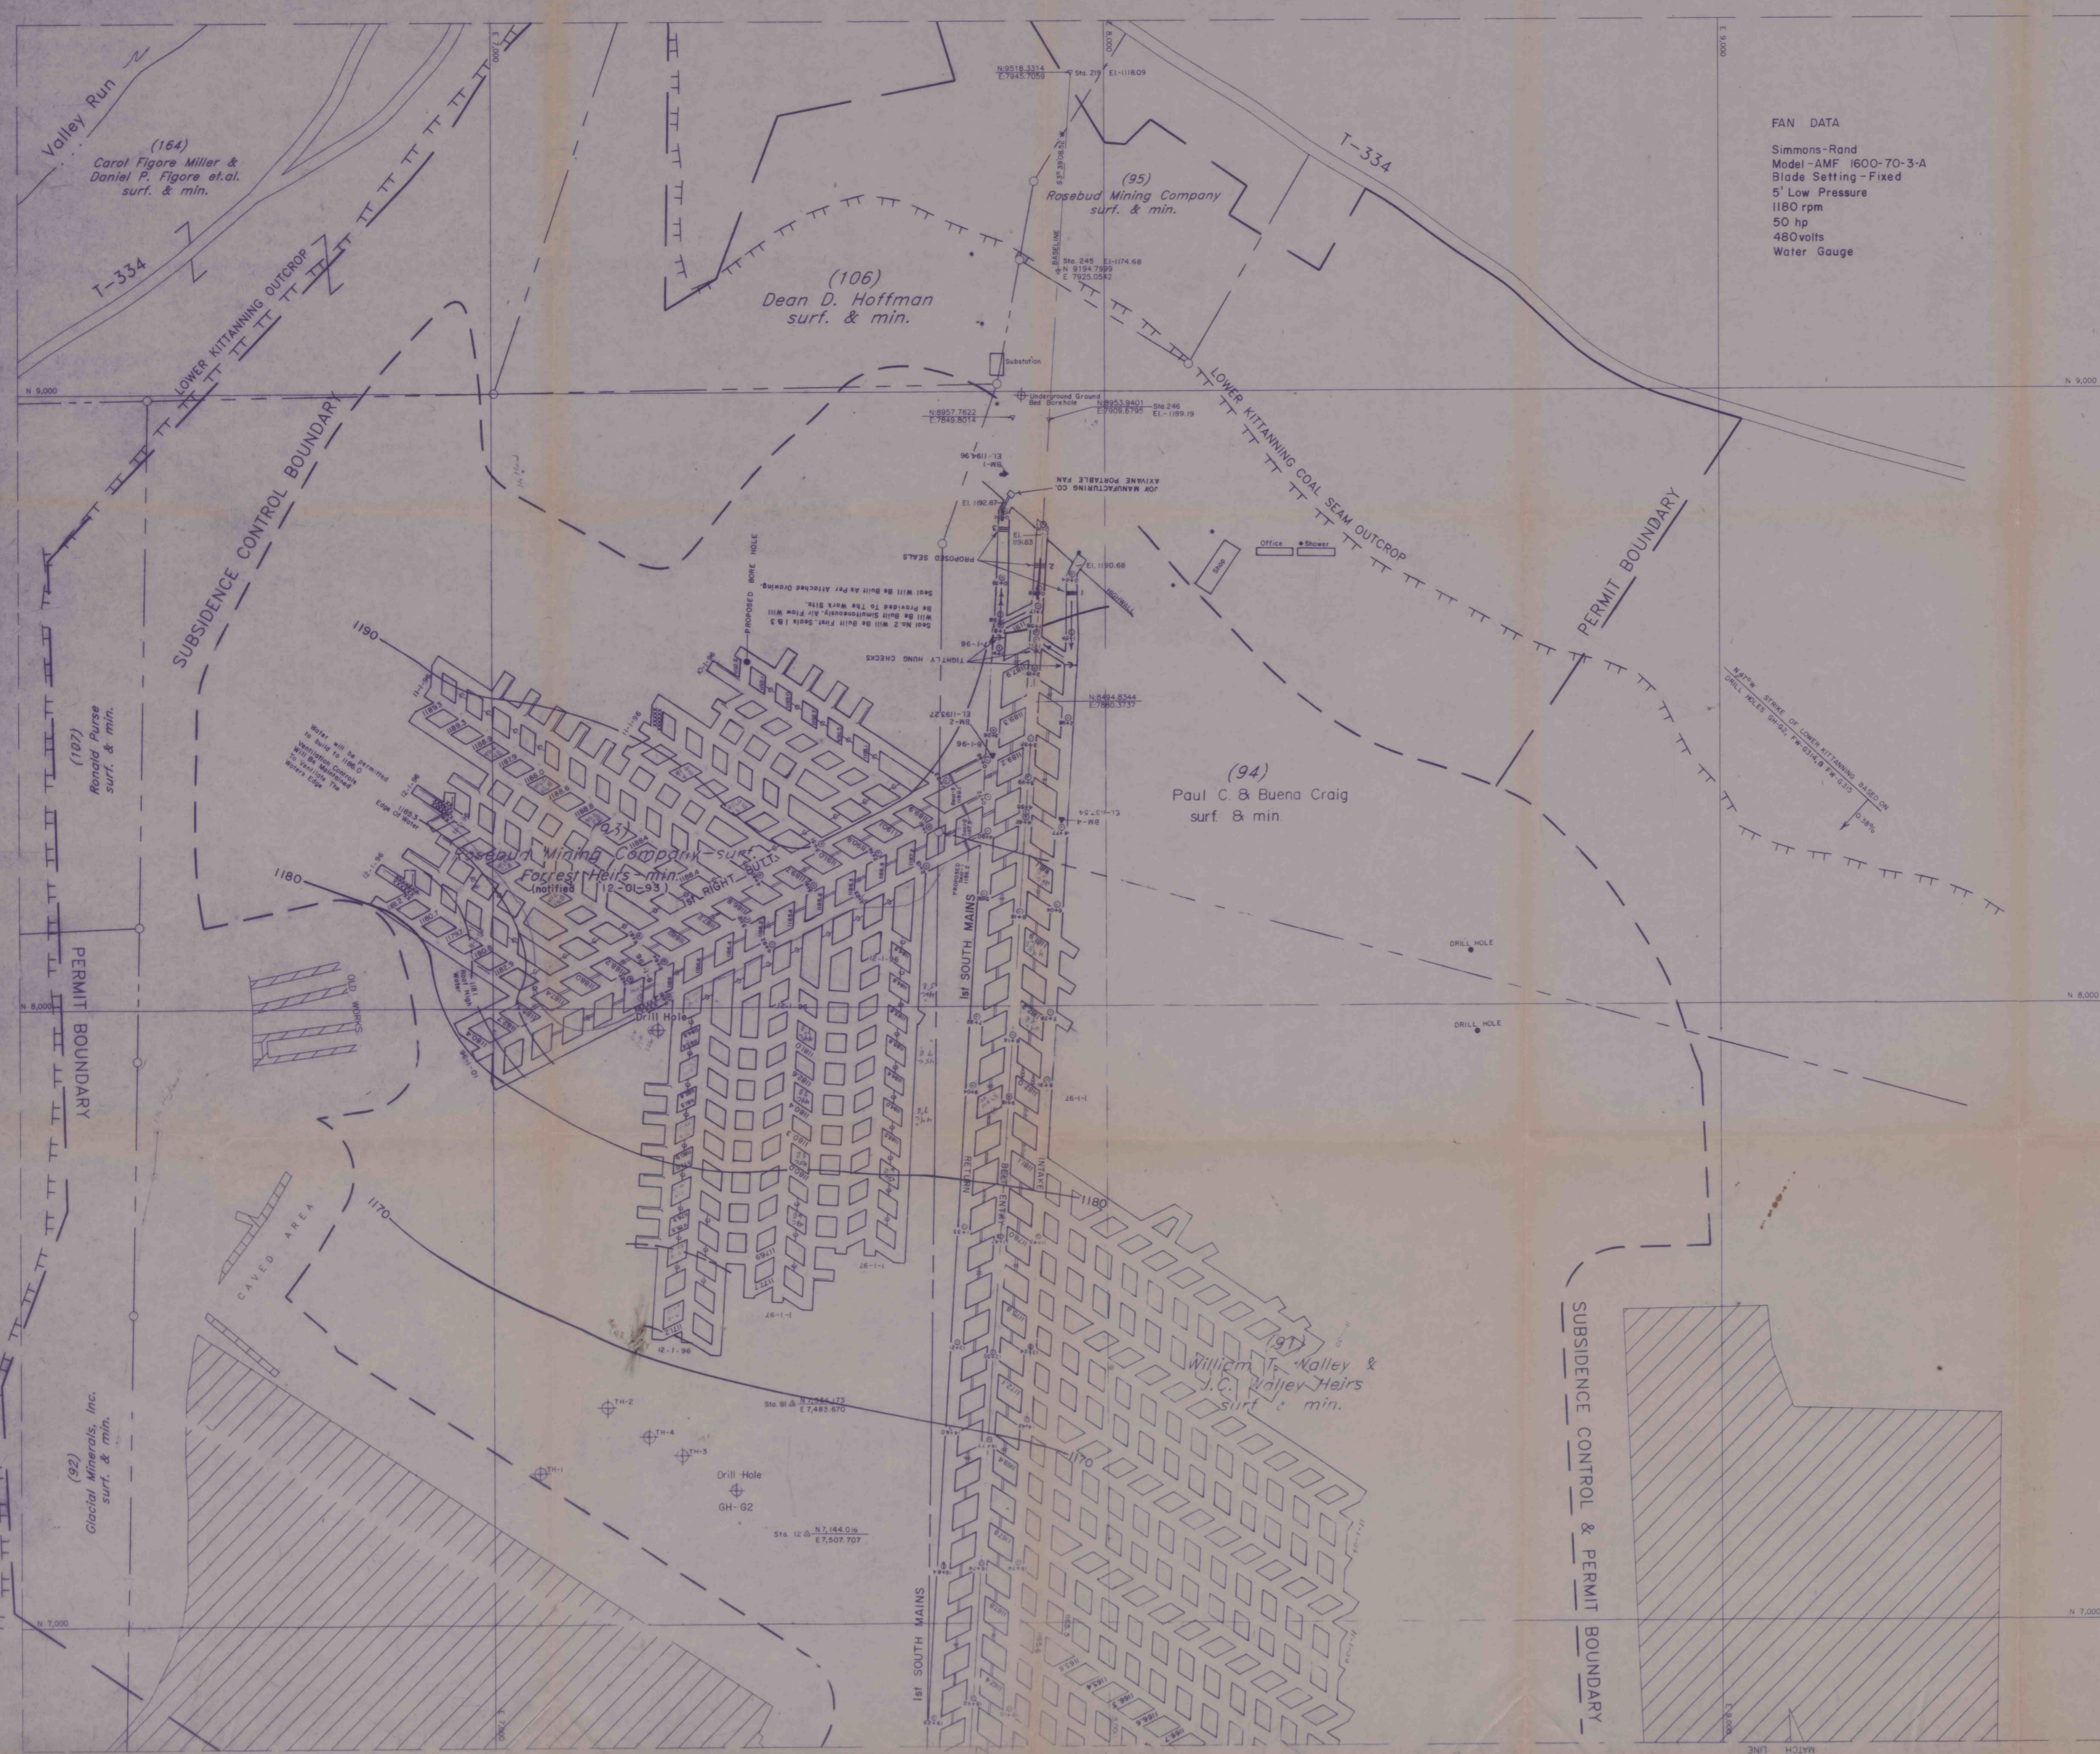

*Theodore J. Beamer, Jr.*  
4/15/01

FINAL MAP  
 MAP 75.372 & 75.1200  
 ROSEBUD MINING COMPANY  
 ROSEBUD NO.2 MINE

SHEET NO.1  
 PERRY TWP., ARMSTRONG CO.  
 LOWER KITTANNING COAL SEAM  
 SCALE: 1"=100'  
 I.D. No. 36-08410

