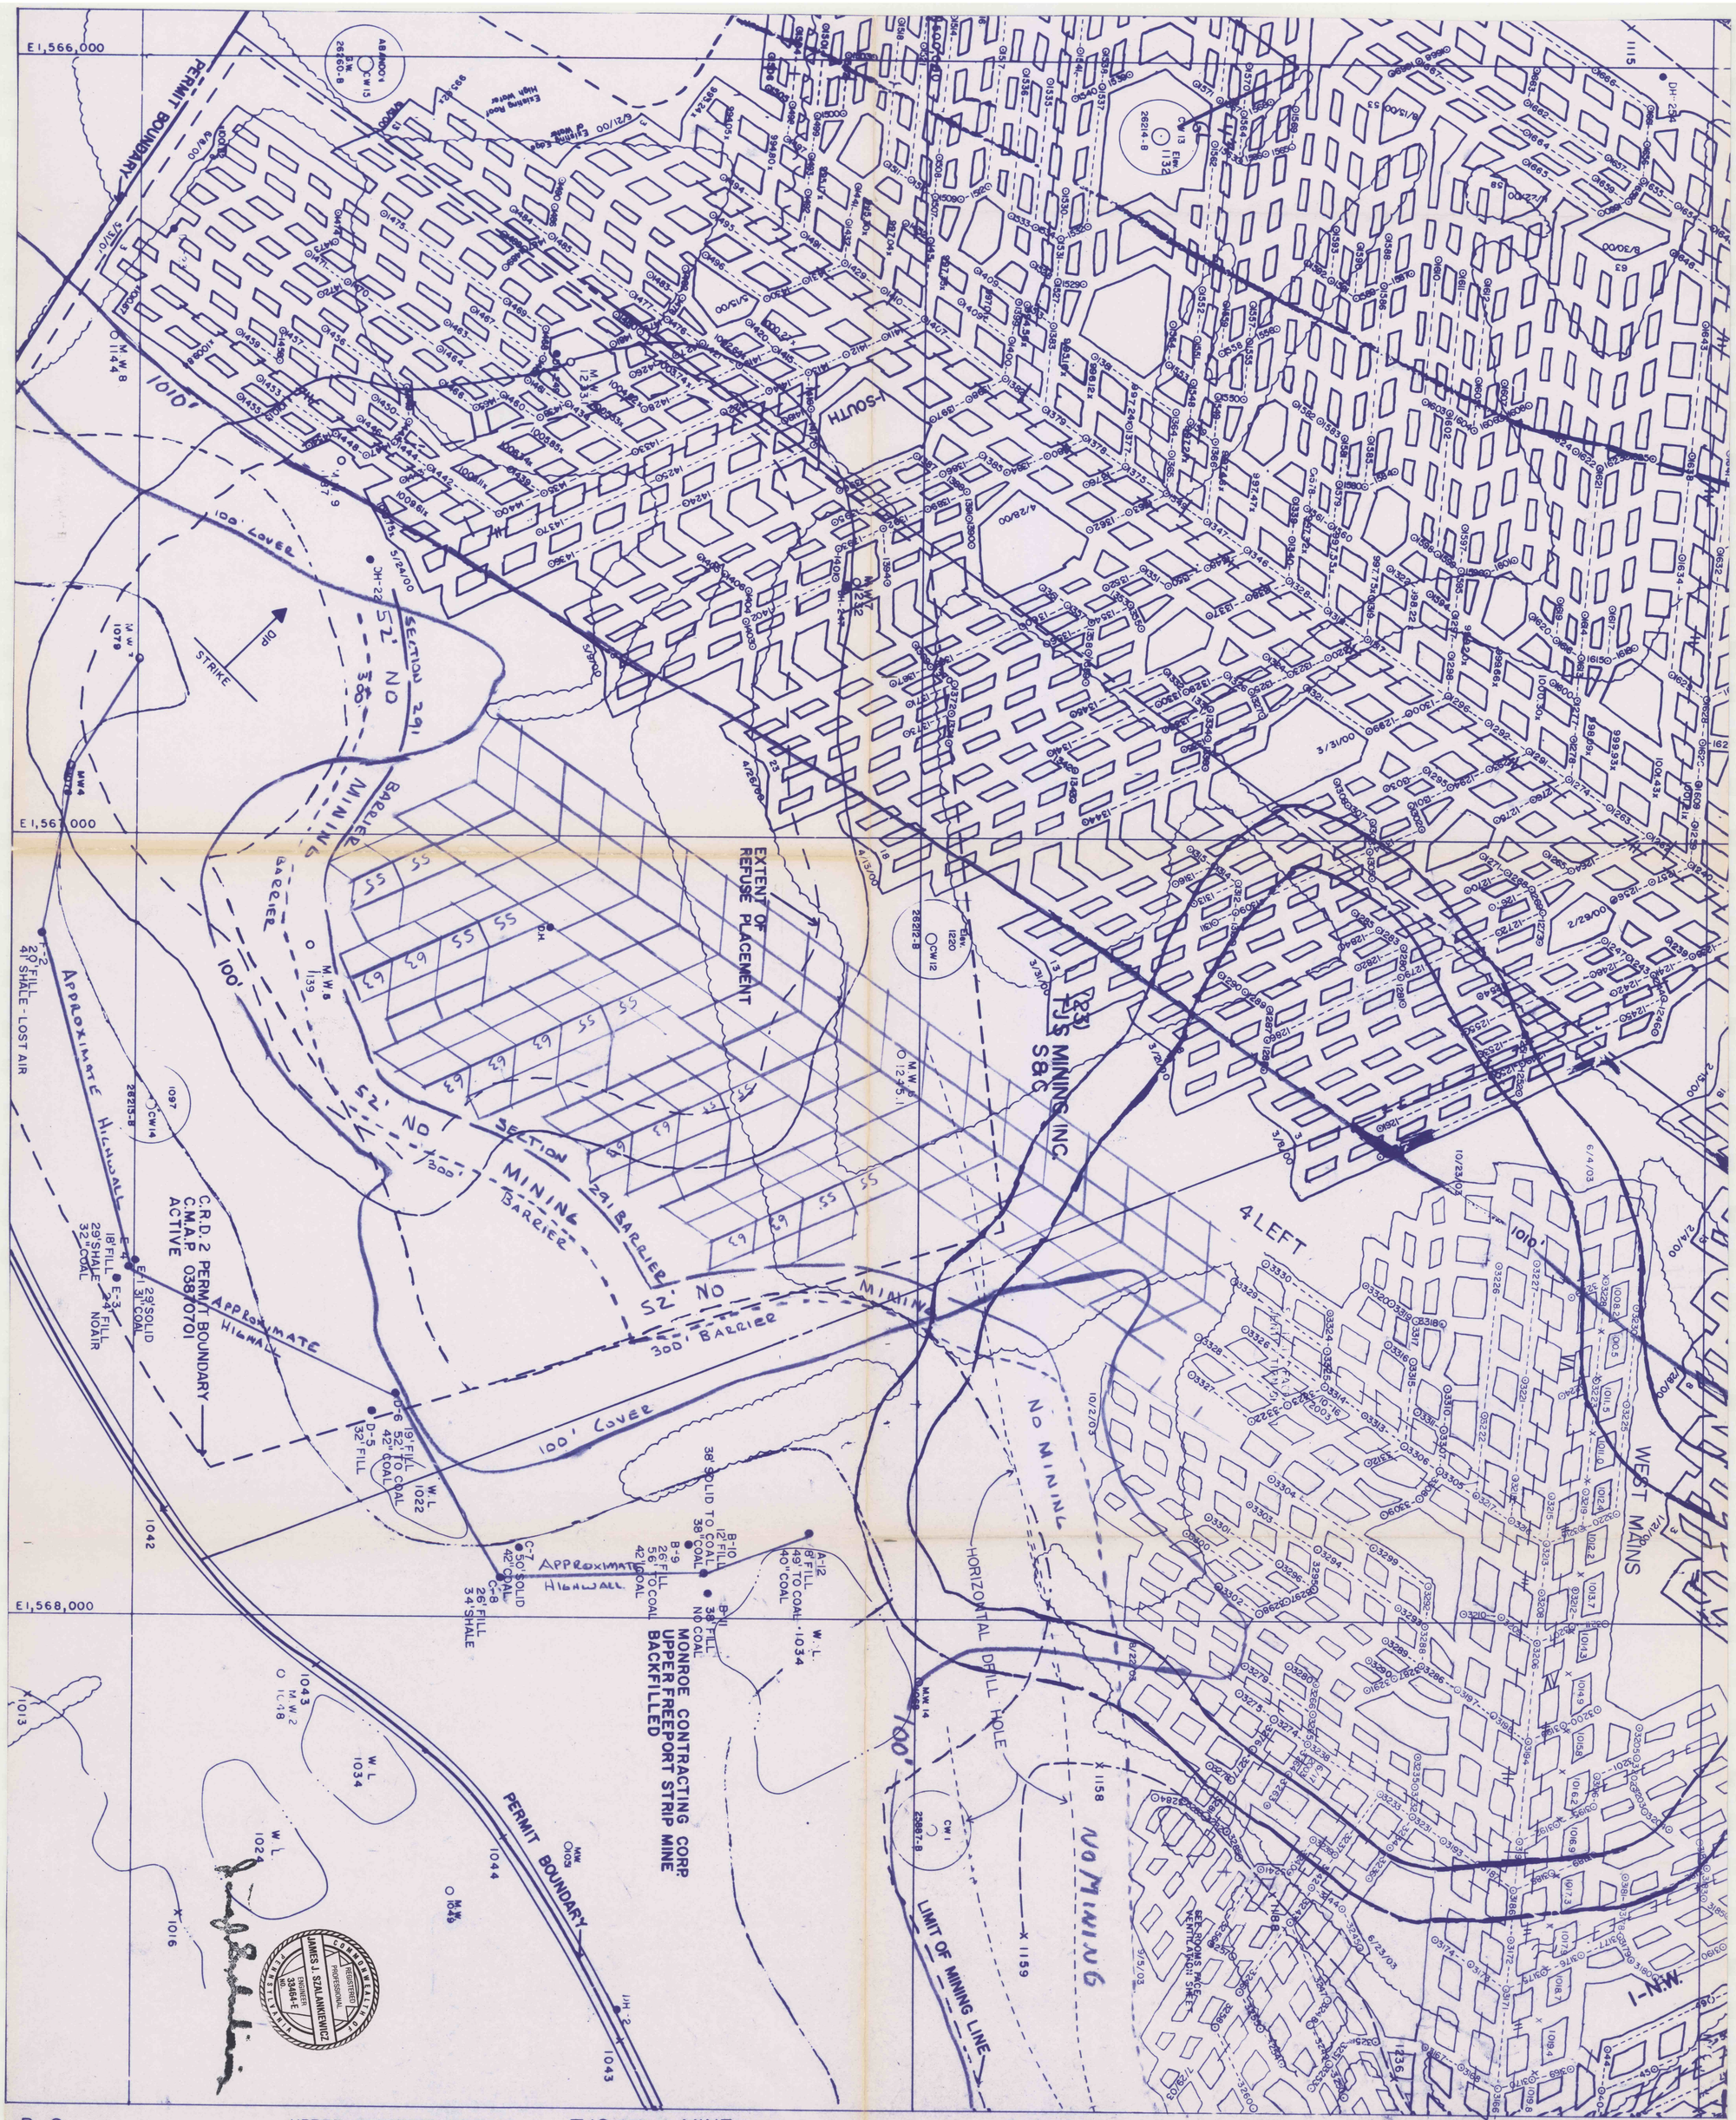

B-2

UPPER FREEPORT SEAM

TJS NO. 4 MINE
PLUMCREEK TWP.
ARMSTRONG CO.
SCALE: 1"=100'

TJS MINING INC.
PROJECTION NO. 12 REV. 1
MINING PERIOD 7/1/03 TO 1/1/04
SURVEY DATE 10/22/03