




W.G. SHIELDS
FEE

BESSIE SMITH
FEE

W.J. WORK
FEE

MINING COMPLETED
5-24-67 to 10-10-67

LEGEND
 PROPOSED 6 MONTHS DEVELOPMENT 10-10-67 to 4-10-68
 MINED OUT AREA 5-24-67 to 10-10-67

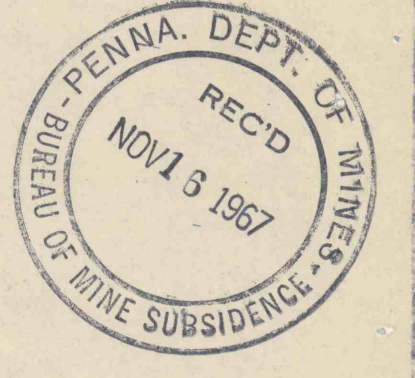

G.M.F.W. COAL COMPANY
 No. 1 MINE B COAL SEAM
 EAST MAHONING & GRANT TWP'S INDIANA COUNTY PA
 SCALE 1"=100' 10-10-1967 A.K. BLOOM, P.E.
 SURVEYED BY J.C. PASSMORE, R.S.
 SUBMITTED IN COMPLIANCE WITH MINE SUBSIDENCE ACT OF 1966
 REVISED 10-10-67

FIELD COPY

H. R. RYEN-SURF
 CABIN

40P