


Survey 1841
Lancashire No. 3
D Seam

Coal 1428-157
Elev. 1447
Lancashire No. 17 or No. 19
B Seam

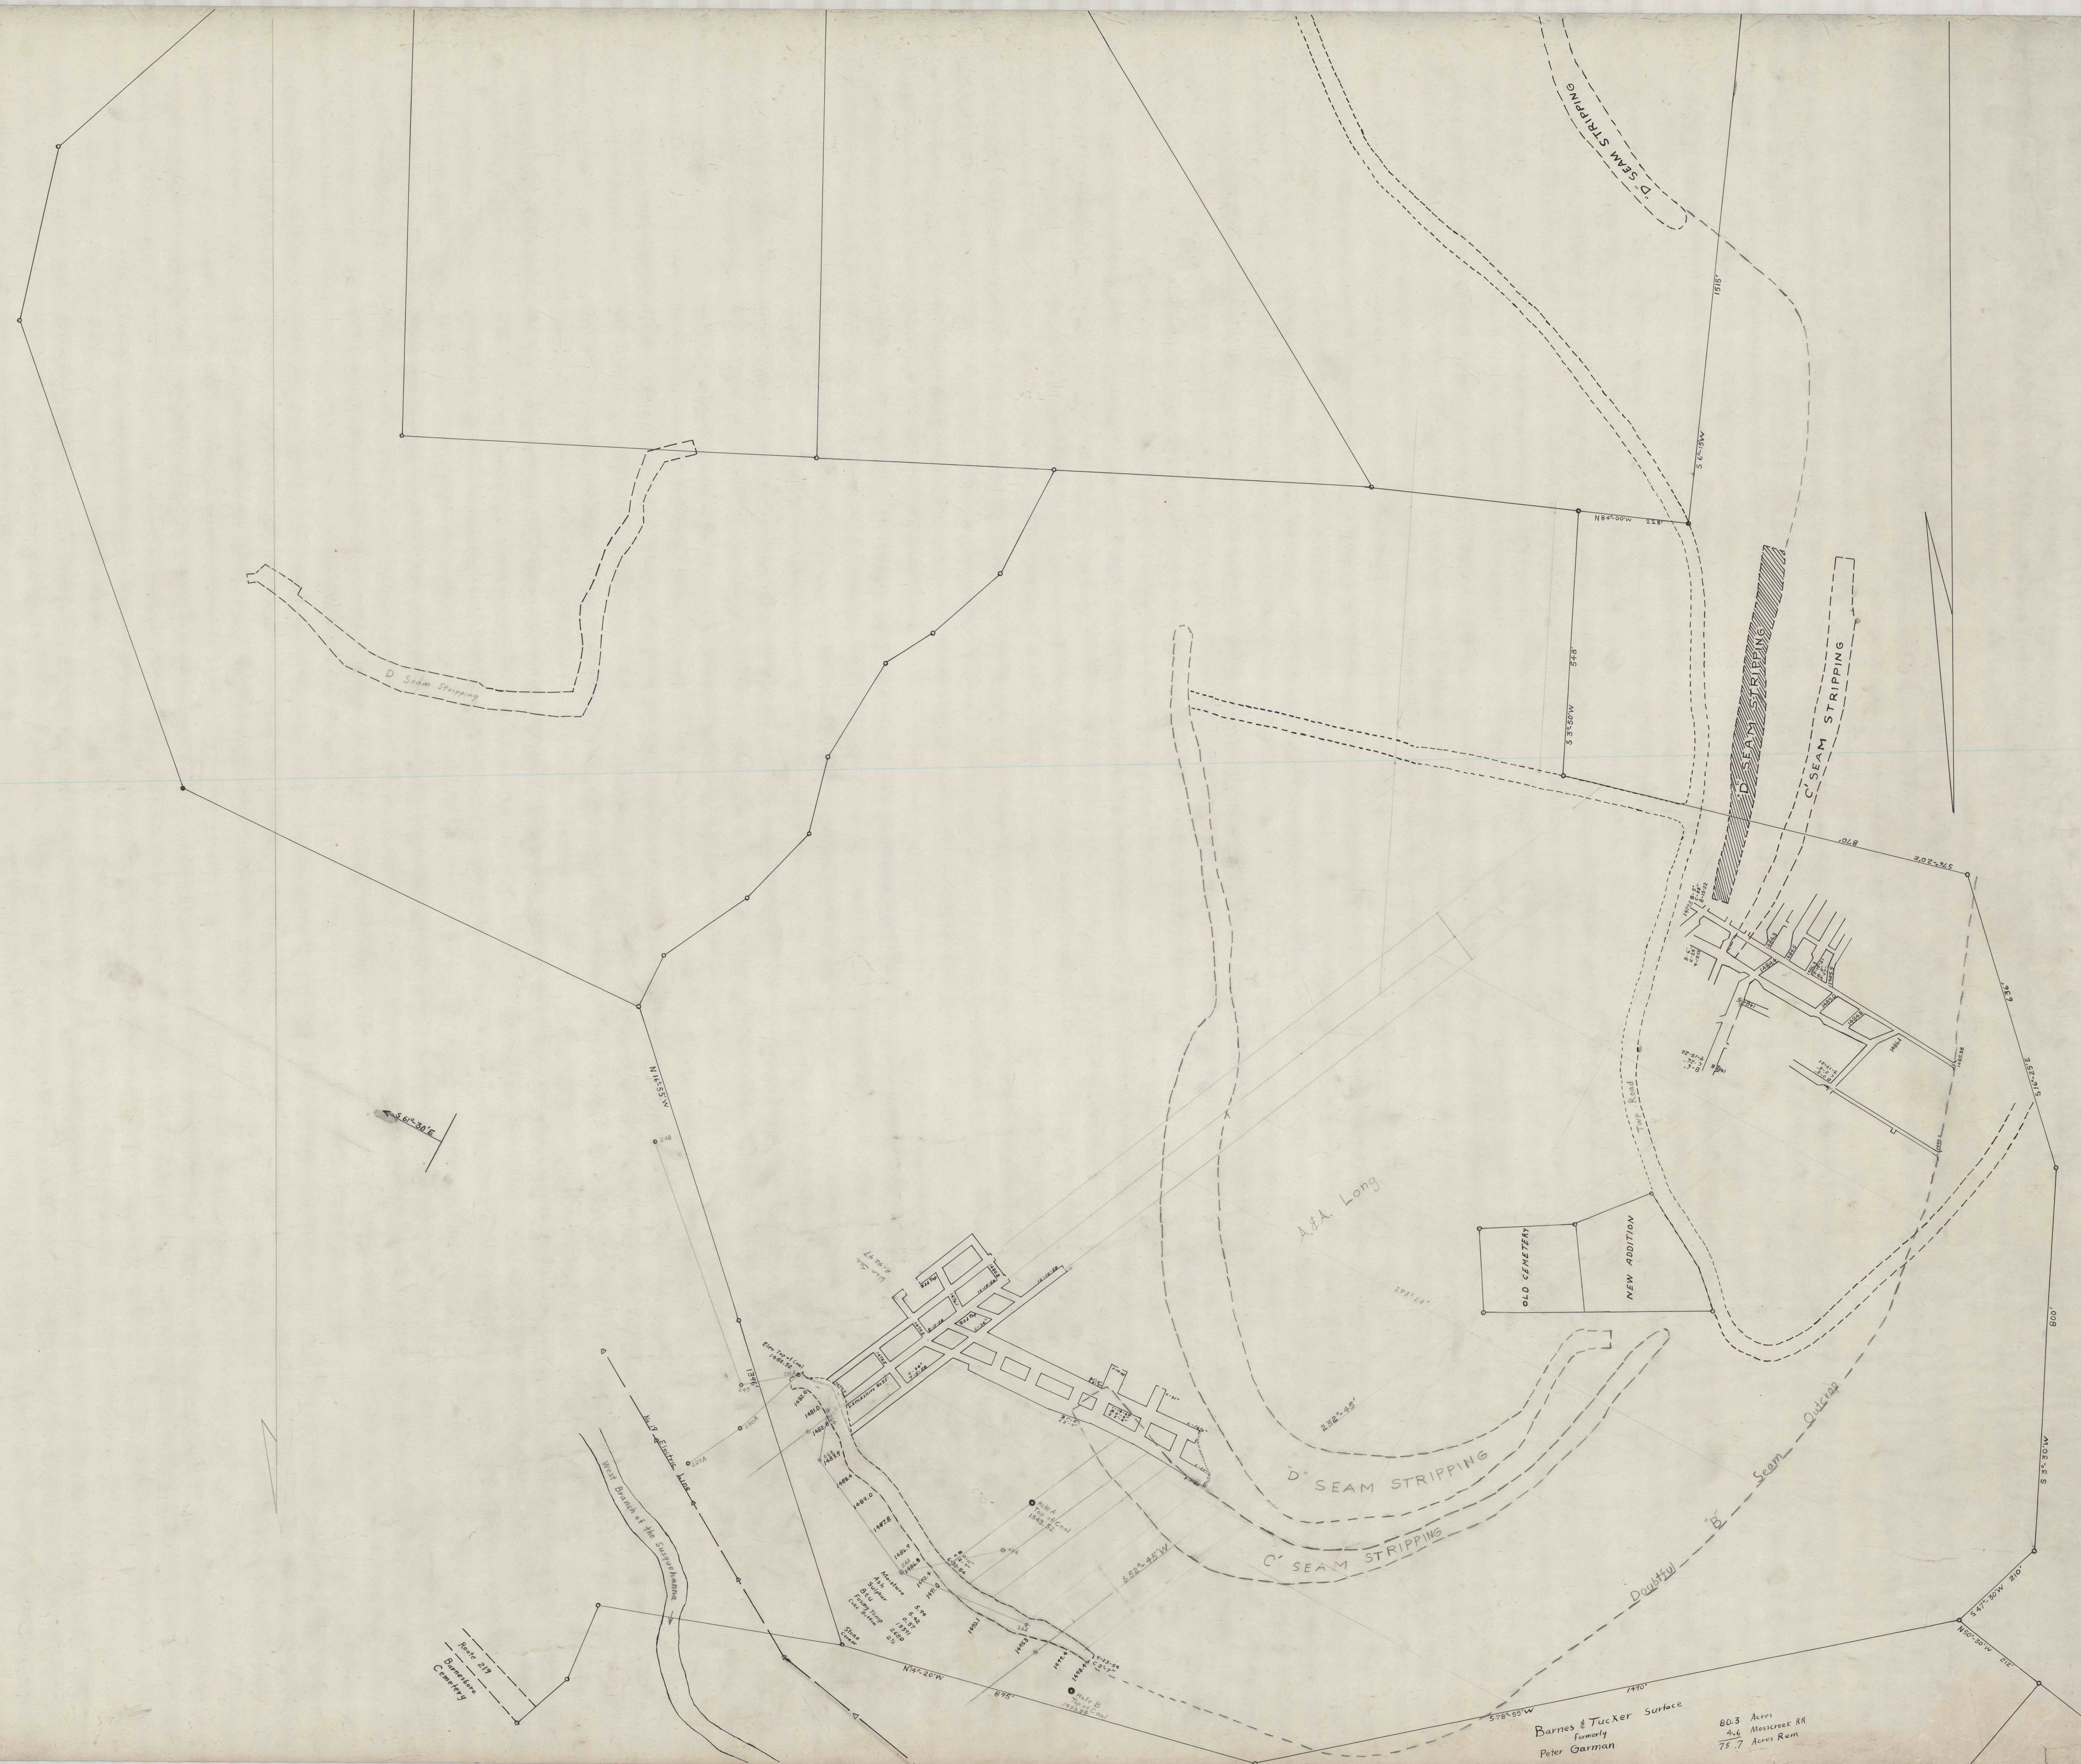

← S 81° 30' E

← N 44° 30' W
Barnes Cemetery

Barnes & Tucker Surface
Family
Peter Garman
80.3 Acres
4.6 Messmore RR
75.7 Acres Ram