


FIT TO 2


FIT TO 5

FIT TO 4

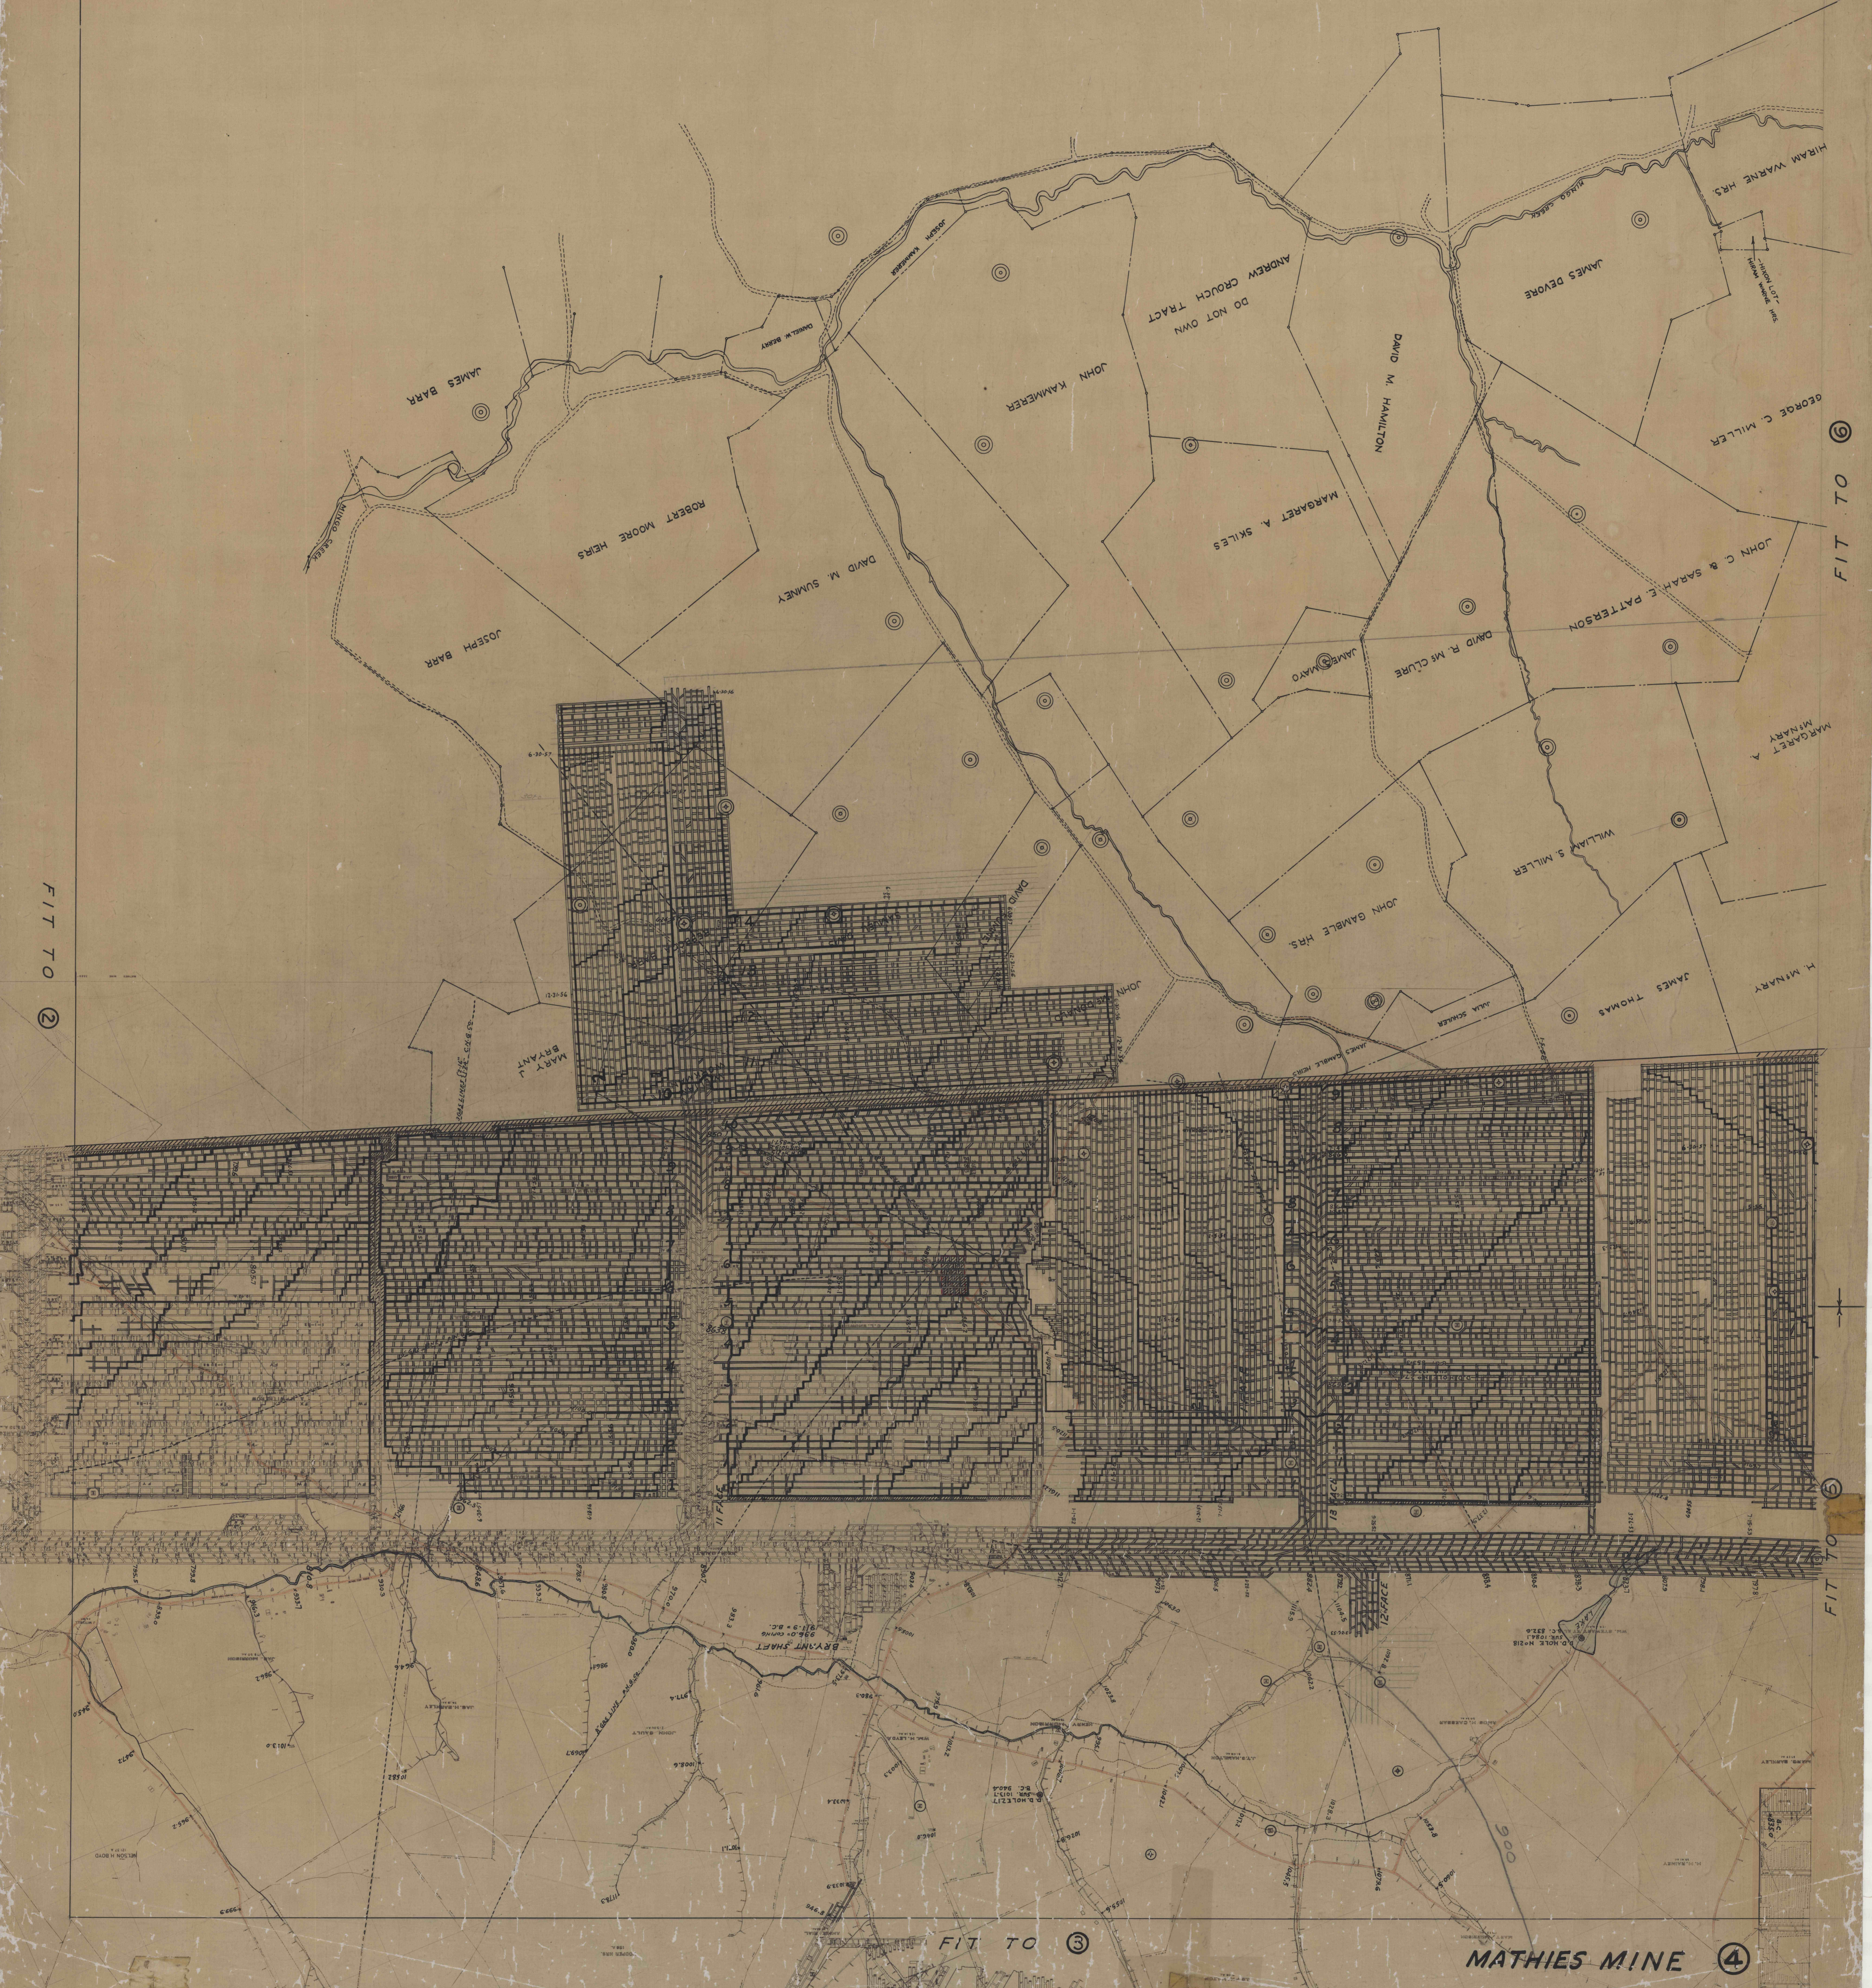

MATHIES MINE 4

FIT TO 3