

ISAAC T. CROUCH  
113.39 Ac.

M.M. BRYANT  
216.53 Ac.

WM.H. HAMILTON  
63.33 Ac.

70.00 Ac.

NOTTINGHAM

JAB. MORRISON  
77.04 Ac.

J.G.R. HAMILTON  
81.08 Ac.

H. H. RAINEY  
35.62 Ac.

AMOS H. CAESBAR  
50.34 Ac.

J.T.G. HAMILTON  
81.08 Ac.

HENRY MORRISON  
78.50 Ac.

WM. STEWART ET AL  
126.46 Ac.


53-3 - old 1.20 Ac. FIT TO K-5611  
53-4  
53-8

Fit to 11-200

FIT TO K-5603

MATHIES MINE K-5602

10-200

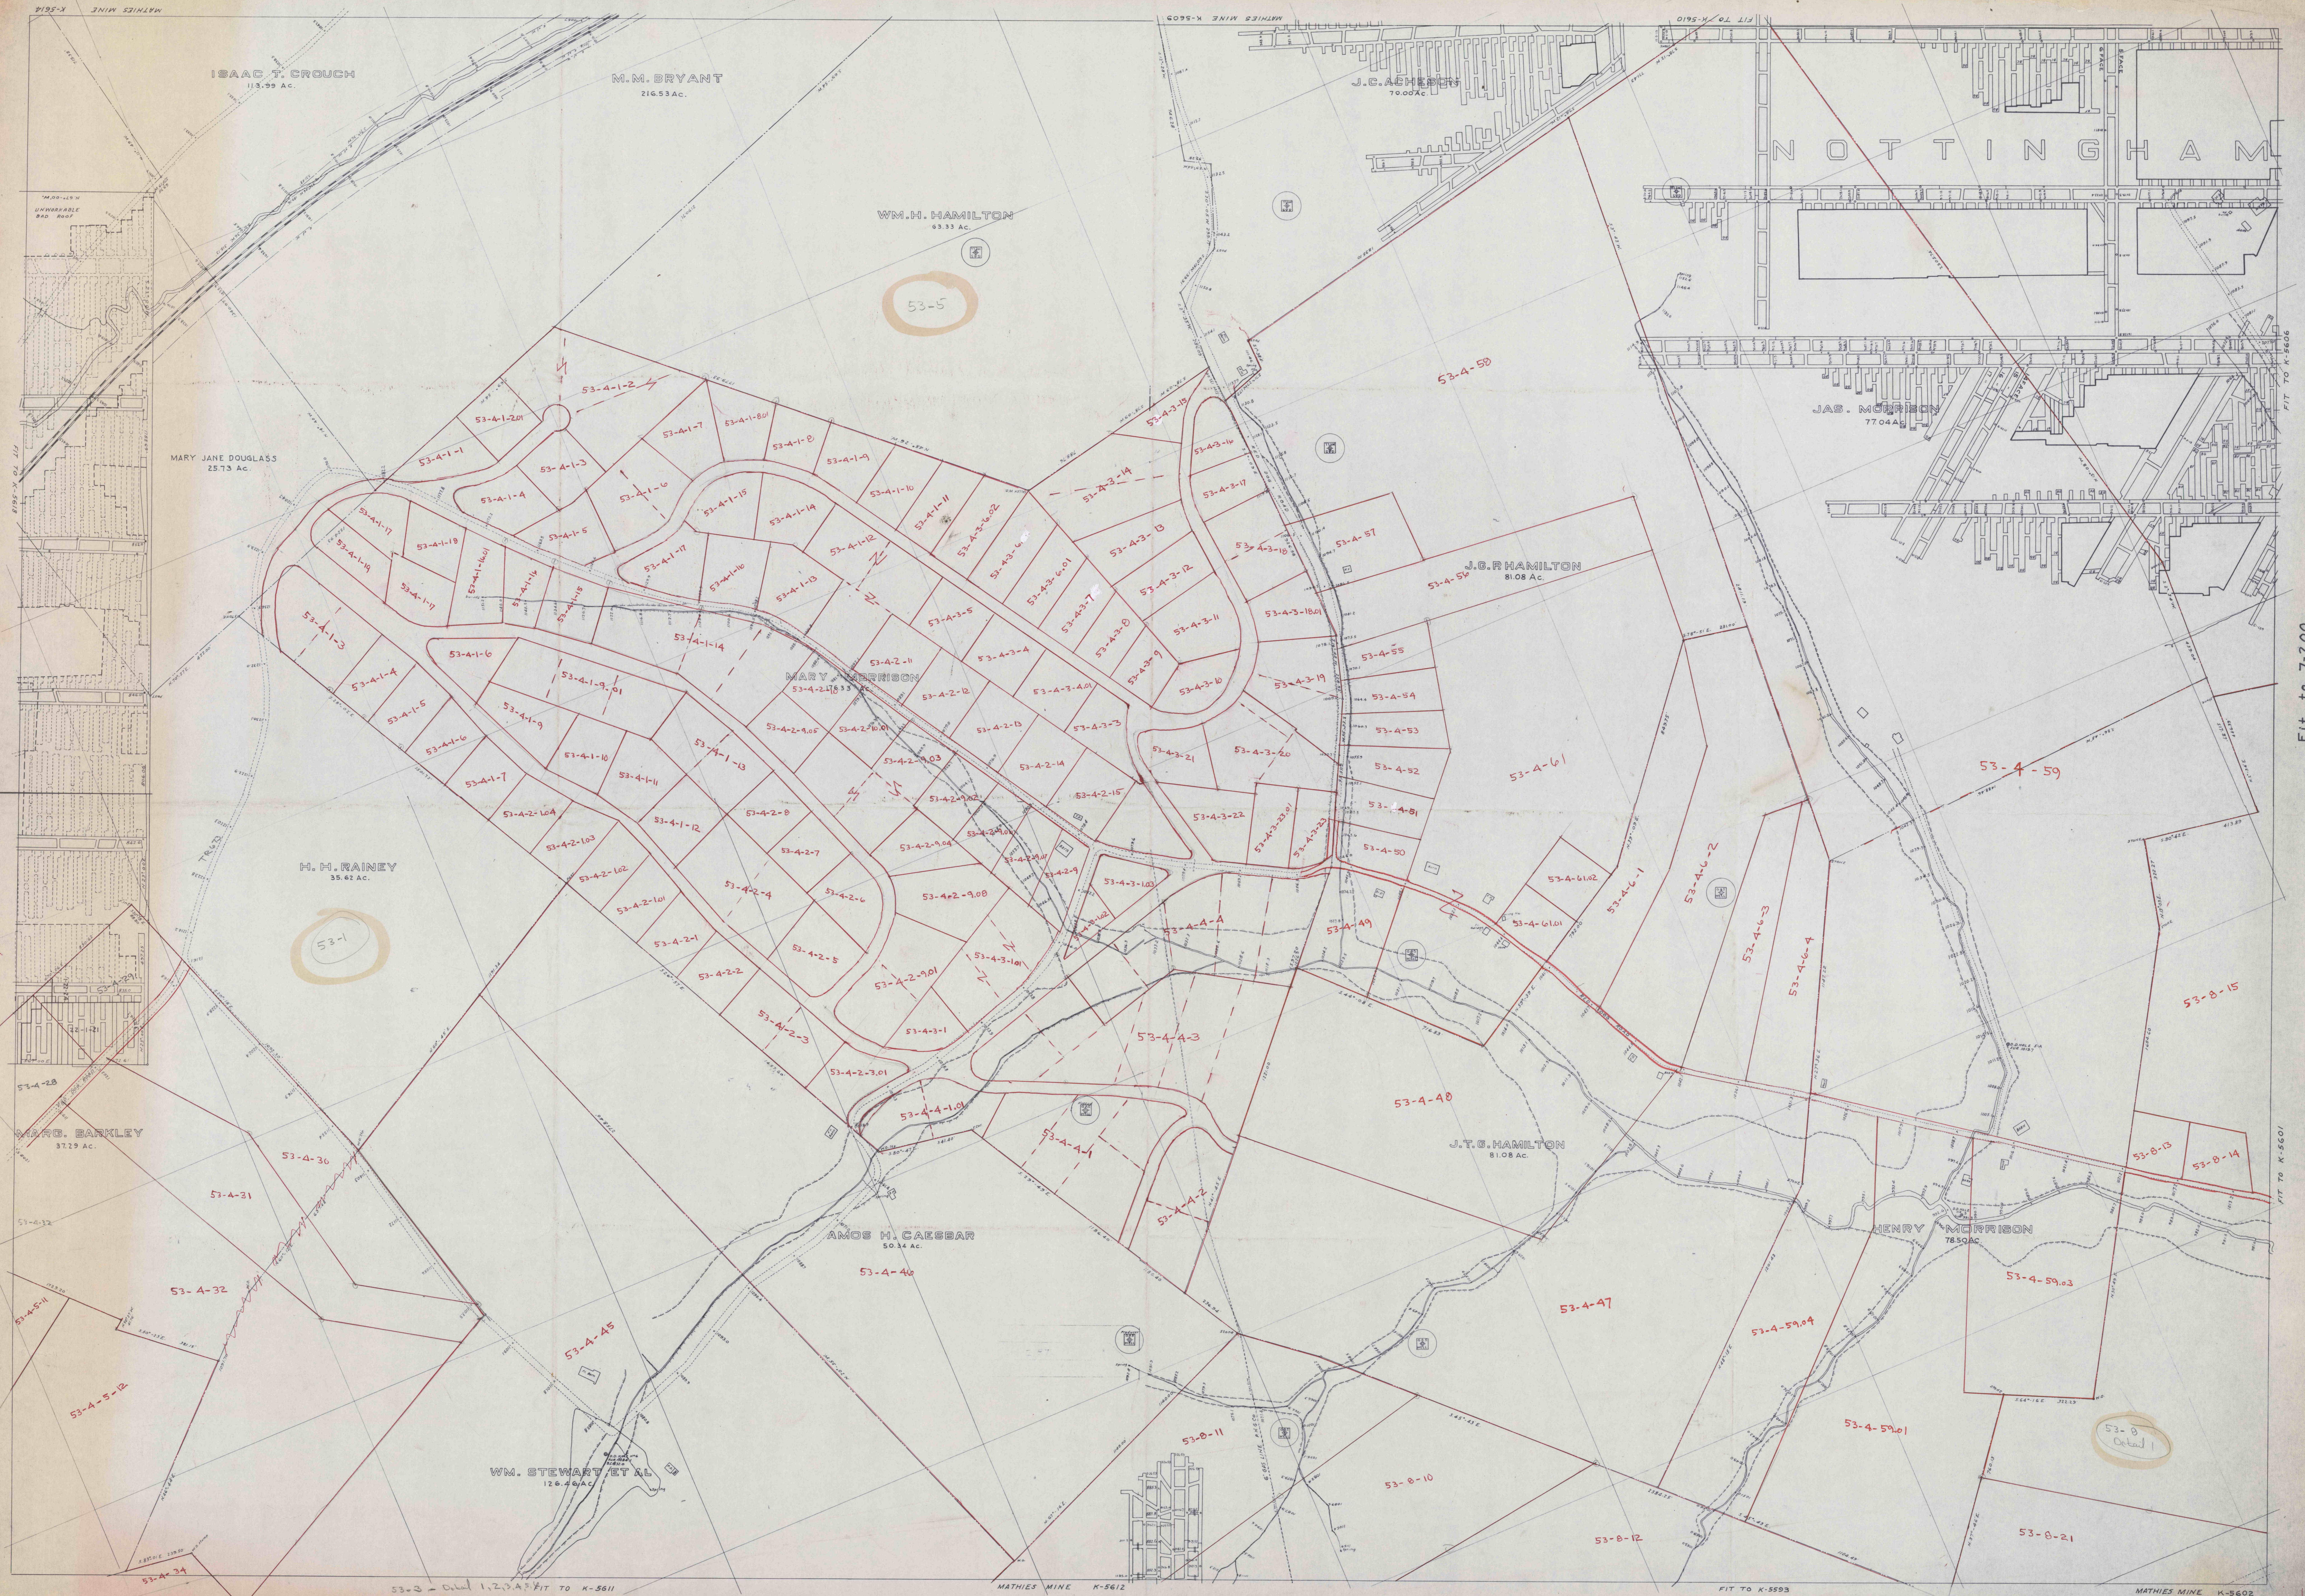

Fit to 12-200

Fit to 7-200

Fit to K-5601