


LEGEND

- 6.00 ACRES SURFACE PERMIT BOUNDARY (EXISTING)
- PROPERTY LINE
- STREAM
- OUTCROP
- PROPERTY INDEX
- MONITORING POINT
- VARIANCE
- ROADS
- SR 3029
- DEEP MINE OPENING
- MINE OPENING
- 40.30 AC. PERMIT AREA DELETED
- 0.30 AC. PERMIT AREA ADDED
- DIVERSION DITCH
- EROSION & SEDIMENTATION BERM
- SURFACE DRAINAGE
- LIMITS OF EXCAVATION


RAMPSIDE COLLIERIES
MINE 1

EXHIBIT : 6.2 ENVIRONMENTAL RESOURCES MAP
9.1 OPERATION MAP

JUL 30 2004
RICHLAND TWP. CAMBRIA CO

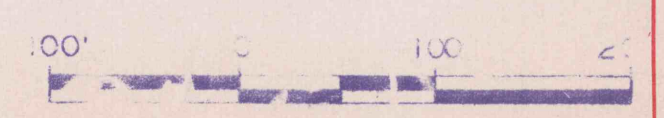

SCALE: 1"=100'

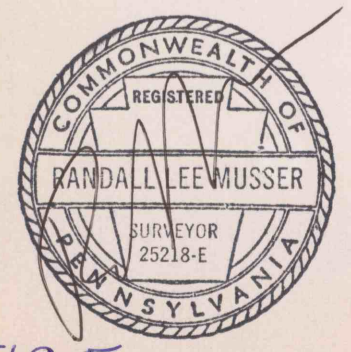

OFFICE

RECEIVED
JUL 30 2004

Dept. of Environmental Protection
Cambria District Office
JUNE 1985