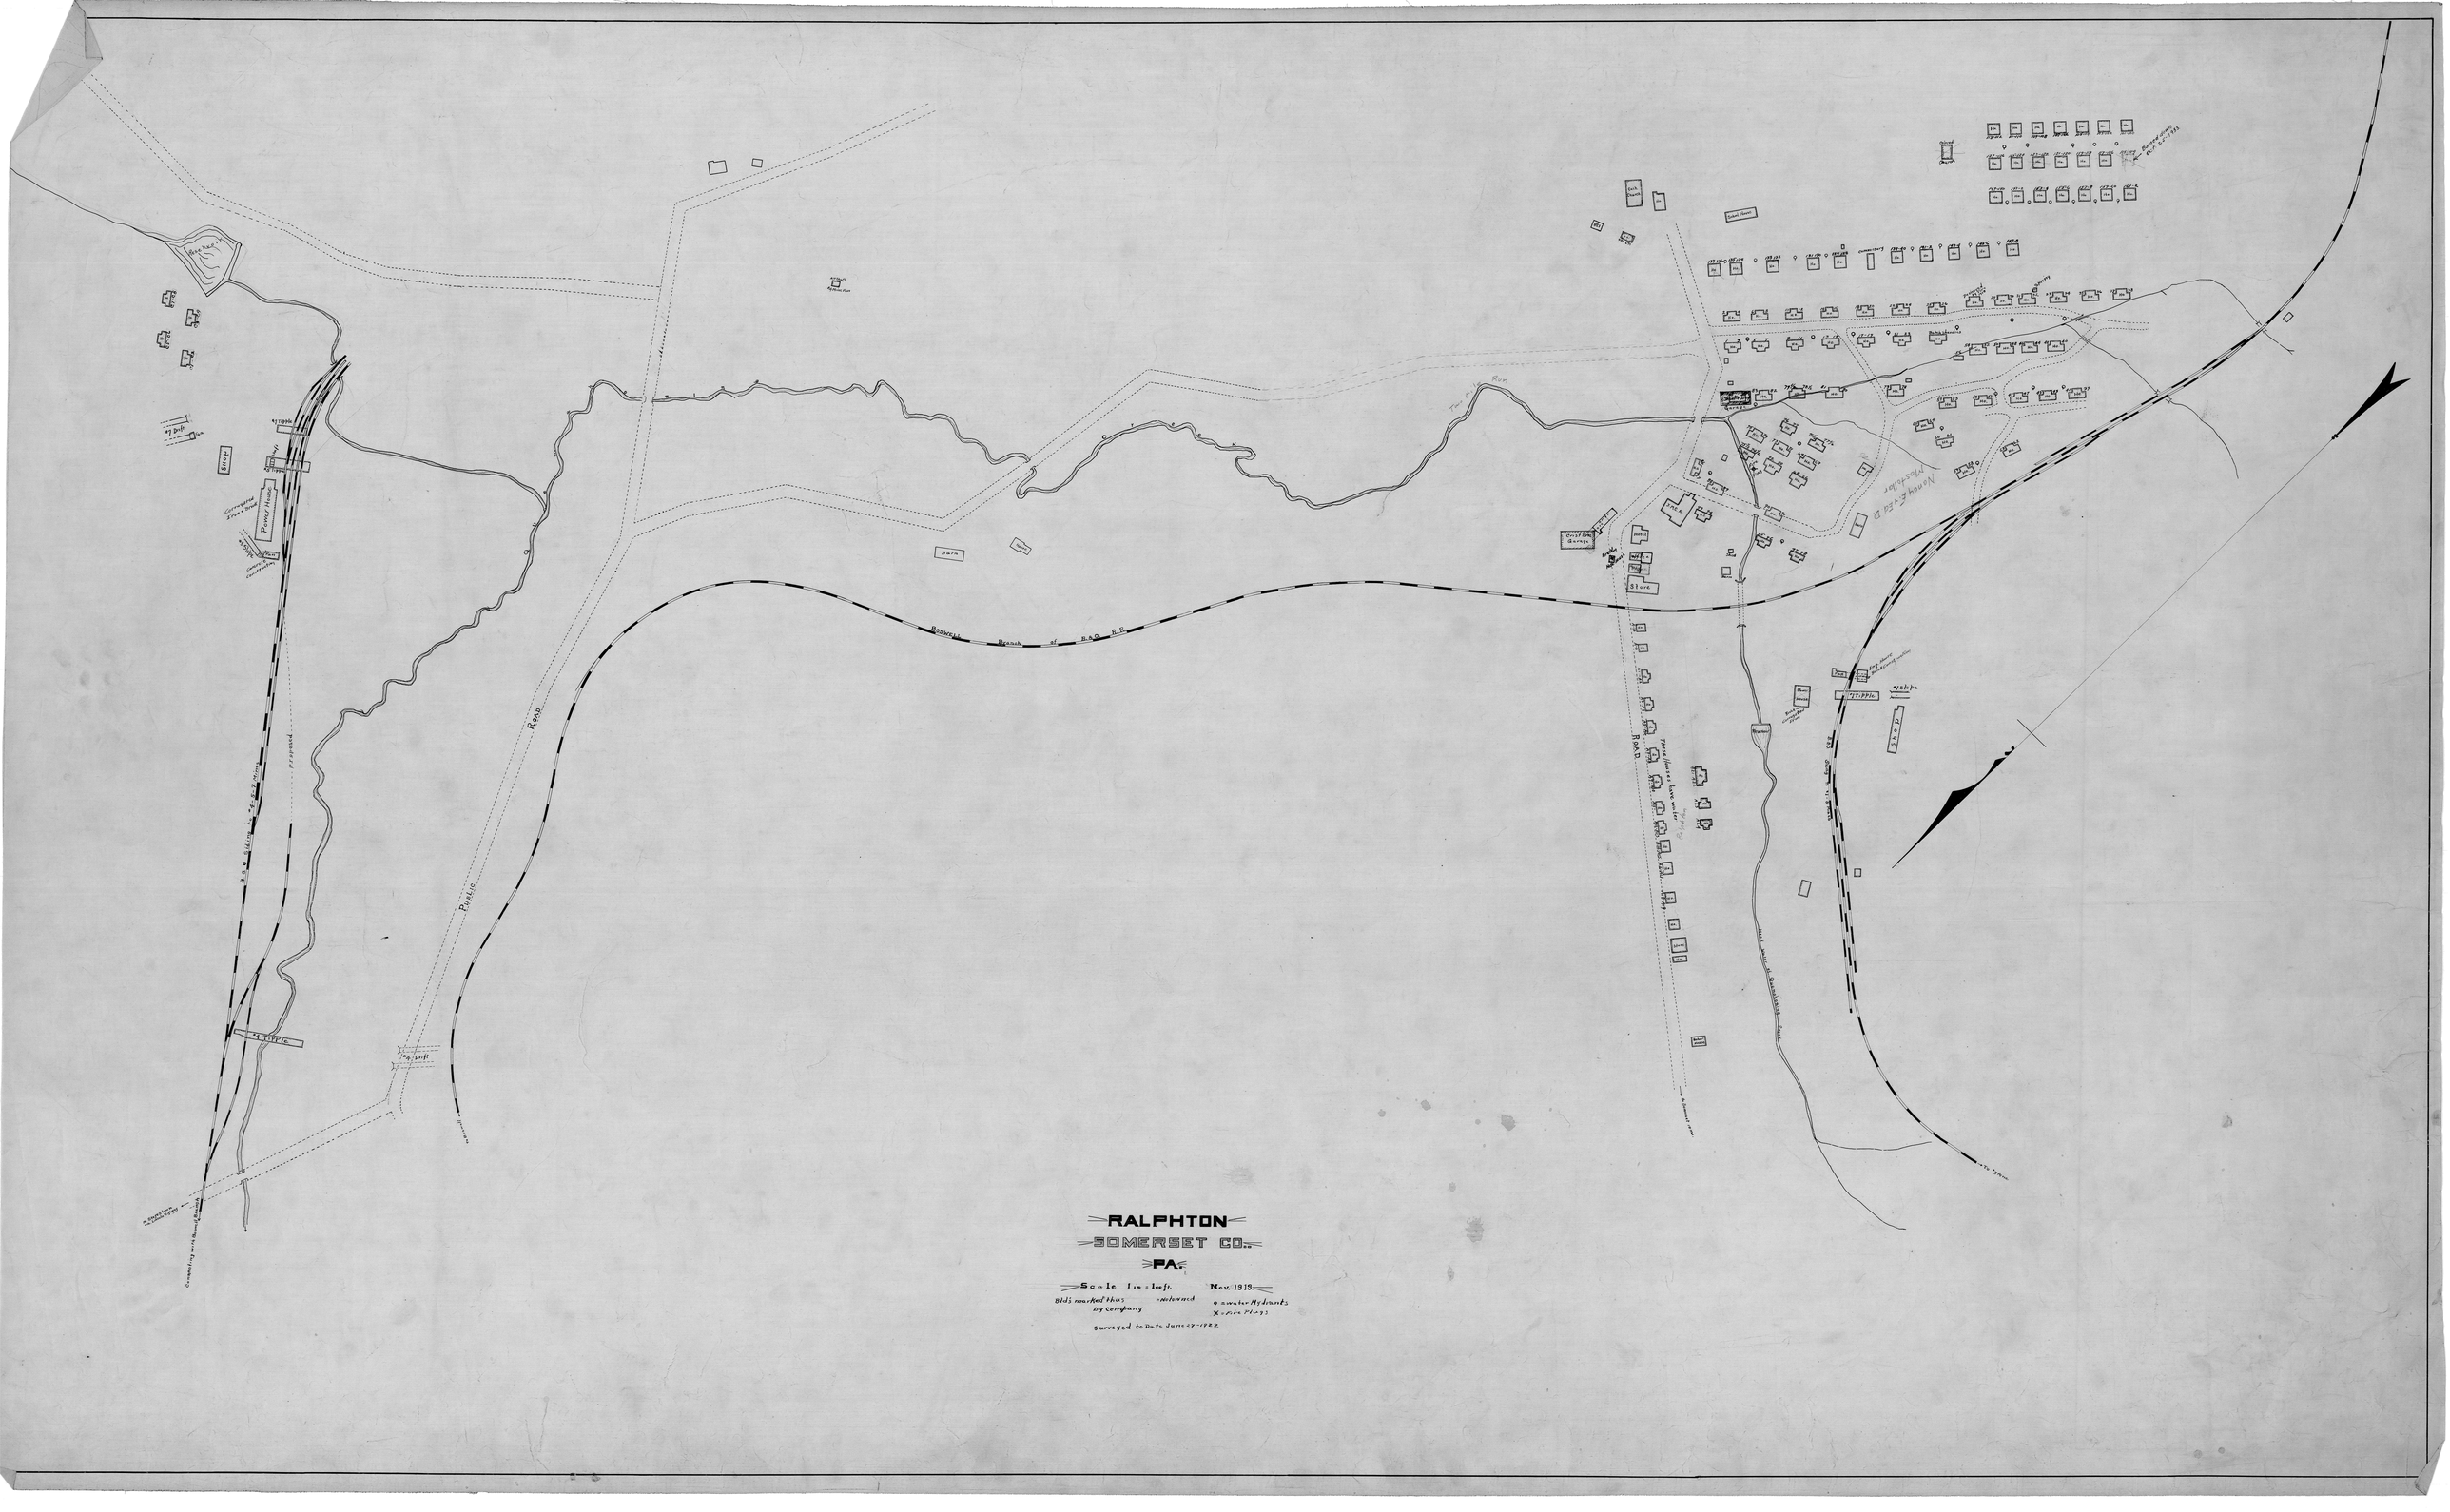
Boswell Branch of B.&O. R.R.
Road
Postoffice
Power House
Shop
Barn
Store
Hotel
Road
Shop
Nonpareil D Mostoller
Run
Proposed
Connecting with Boswell Branch
RALPHTON
SOMERSET CO.
PA.
Scale 1 in = 100 ft.
Nov. 1919
Bld's marked thus = Not owned by Company
= water Hydrants
X = fire Plugs
Surveyed to Date June 27 - 1922