Ralphton No 1

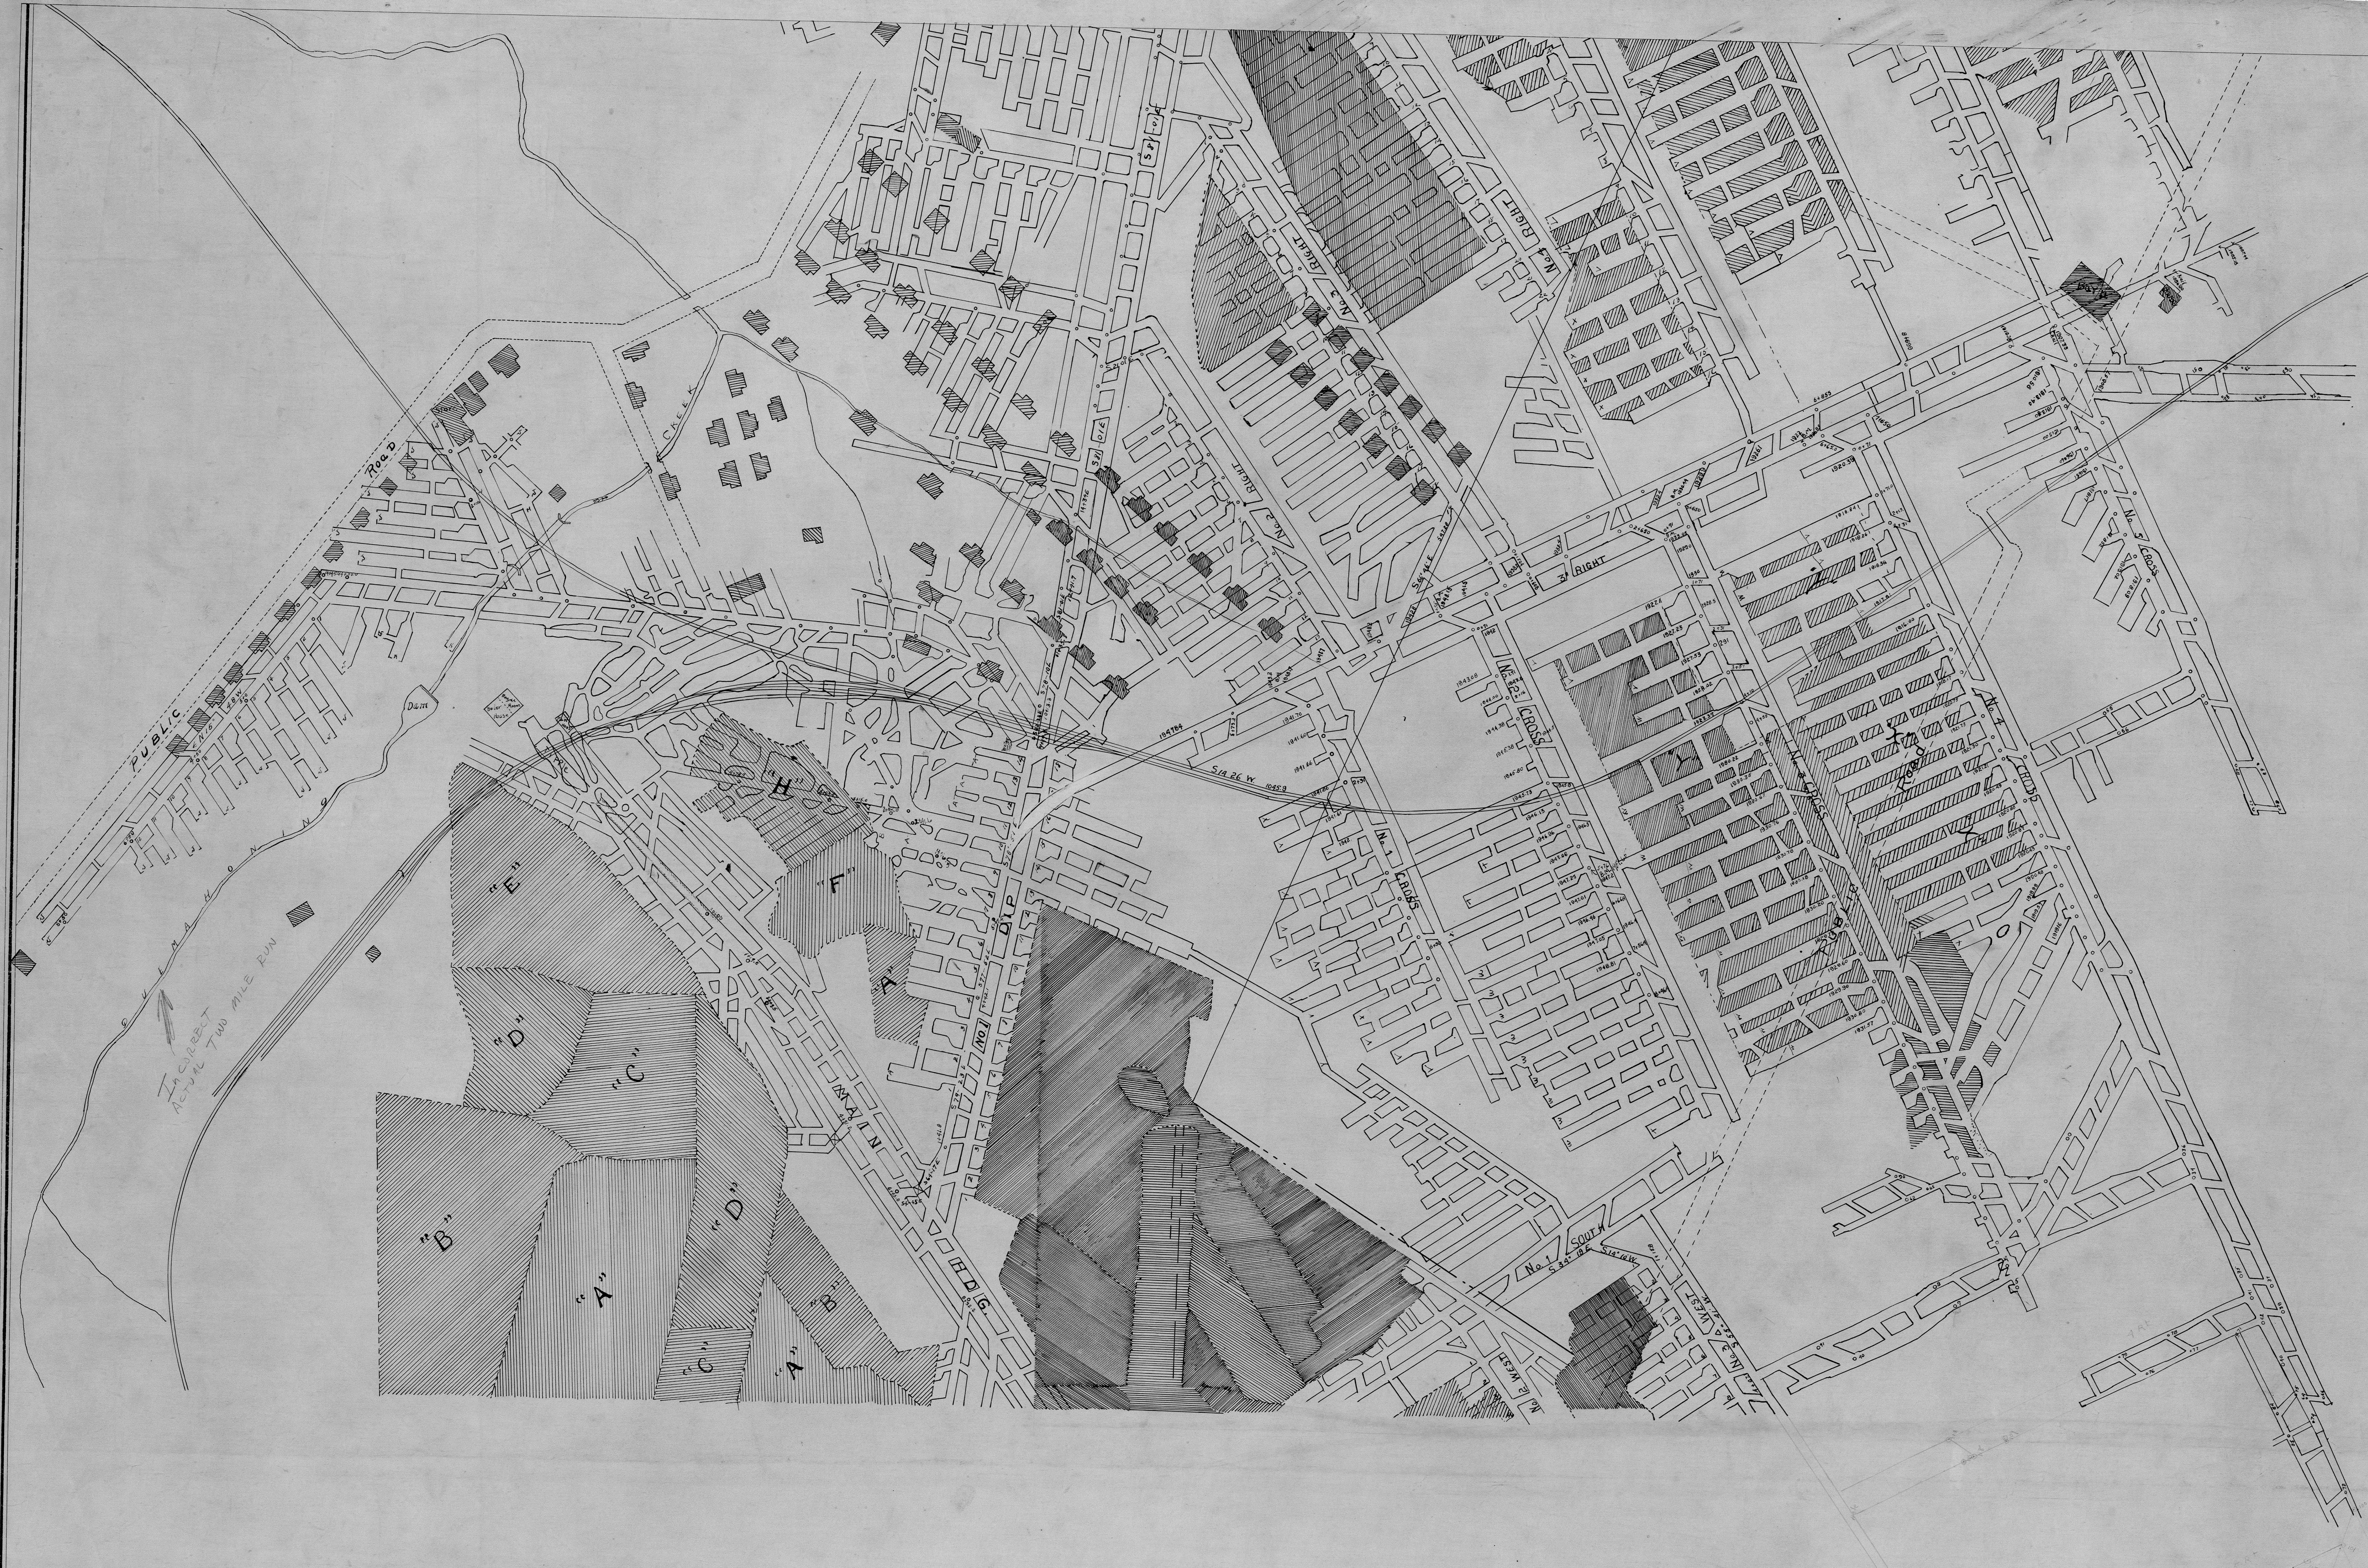
PUBLIC ROAD
CREEK
QUEMAHONING
Dam
Store
Boiler House
Engine Room
Incorrect
Actual Two Mile Run
"E"
"D"
"C"
"B"
"A"
"D"
"C"
"A"
"B"
"H"
"F"
"A"
MAIN HDG.
No. 1 DLP
S 79°-23 E
S 77°-52 E
S 78°-10 E
S 81°-01 E
No. 2 RIGHT
No. 3 RIGHT
No. 4 RIGHT
3rd RIGHT
S 60°-46 E
S 14°26 W
No. 1 CROSS
No. 2 CROSS
No. 3 CROSS
No. 4 CROSS
No. 5 CROSS
No. 1 SOUTH
S 34°-19 E
S 14° 10 W
No. 2 WEST
No. 3 WEST
S 55°-41 W
Public Road
Boy'd