


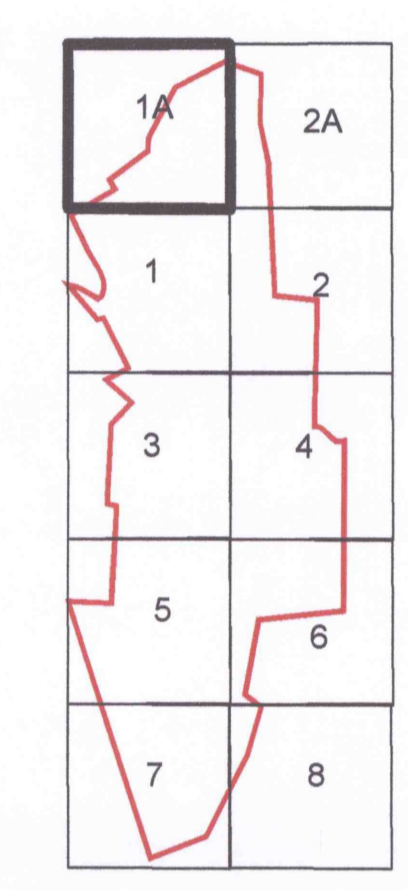


LEGEND

- UNDERGROUND PERMIT BOUNDARY
- SUBSIDENCE CONTROL BOUNDARY
- OCCUPIED DWELLING
- SURFACE PARCEL IDENTIFICATION NUMBER
- SURFACE PROPERTY LINE
- LIMIT OF PROPOSED MINING
- CASWELL
- PROJECTED COAL MINING
- COAL MINED
- STOPPING
- STOPPING W/ DOOR
- STOPPING WITH HOLE
- CHECK CURTAIN
- REGULATOR
- DOUBLE DOORS
- RUN-THROUGH CHECK
- OVERCAST
- INTAKE AIR
- RETURN AIR
- CO MONITOR
- MONITORING POINT
- TAIL PIECE
- BELT
- PRIMARY ESCAPEWAY
- SECONDARY ESCAPEWAY
- MINED OUT AREA



NOTE: This map was assembled using electronically scanned images of the Dunkard No. 2 mine maps, a map identified on the final map of the Mathews Mine, and an electronic map of the Crowded Mine-A Portal. The maps were provided by PADEP, MEFSS, and Cobra Mining, LLC. CME Engineering LP carried out both a GPS Survey and an underground check survey to physically locate identifiable features common to all three mines and to locate the underground workings of the Dunkard No. 2 Mine. No survey data was available for either the Mathews Mine or the Dunkard No. 2 Mine other than the surveys carried out by CME Engineering LP. The survey information has been added to the maps and was used to geo-reference the mine maps. No adjustments or alterations were made to the images of any of the mine maps utilized.

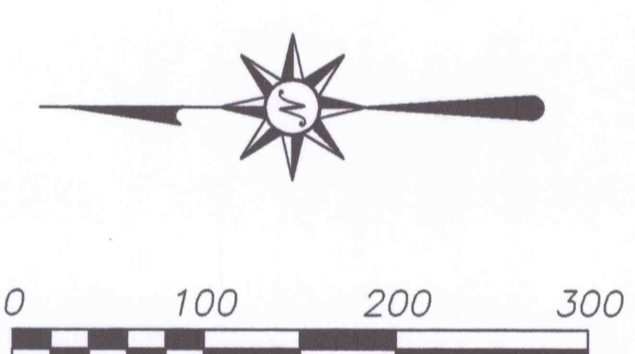

JAMES G. PRICE, MINE SUPERINTENDENT 3/2/05 DATE

JACK E. FERENCI, PE 7/2/06 DATE



CME ENGINEERING CME ENGINEERING LP 165 East Union Street, Suite 100, Somerset, PA 15501 814-443-3344 FAX: 814-444-0365	COBRA MINING, LLC 178 CHESS MINE ROAD P.O. BOX 40 DILLINER, PA 15327 FINAL MAP OF DUNKARD MINE NO. 2 SEWICKLEY COAL SEAM MINING COMPLETED 12/31/05 MSHA ID #38-01301 CMAP #30841309
--	---

REVISIONS		Drawn By:	MAK
No.	By	Date	Description
1	MAK	6/28/05	Mining Updated
2	RJB	7/31/05	Mining Updated
Checked By:			JEF
Date:			6/28/05
Scale:			1" = 100'
Project No.:			316-051
File Name:			FINAL MAP.DWG
Drawing:			1 of 10






Project Information:
 DUNKARD MINING CO.
 DUNKARD MINE NO. 2 - 36 01301
 DUNKARD TWP - GREENE CO - PA.
 SCALE: 1" = 100' SEWICKLEY SEAM
 SHEET No. 1A