



LEGEND

- UNDERGROUND PERMIT BOUNDARY
- SUBSIDENCE CONTROL BOUNDARY
- OCCUPIED DWELLING
- UNOCCUPIED STRUCTURE
- DRILLHOLE
- SURFACE PARCEL IDENTIFICATION NUMBER
- SURFACE PROPERTY LINE
- LIMIT OF PROPOSED MINING
- GASWELL
- PROJECTED COAL MINING
- COAL MINED
- STOPPING
- STOPPING W/ DOOR
- STOPPING WITH HOLE
- CHECK CURTAIN
- REGULATOR
- DOUBLE DOORS
- RUN-THROUGH CHECK
- OVERCAST
- INTAKE AIR
- RETURN AIR
- CO MONITOR
- MONITORING POINT
- TAIL PIECE
- BELT
- PRIMARY ESCAPEWAY
- SECONDARY ESCAPEWAY
- MINED OUT AREA

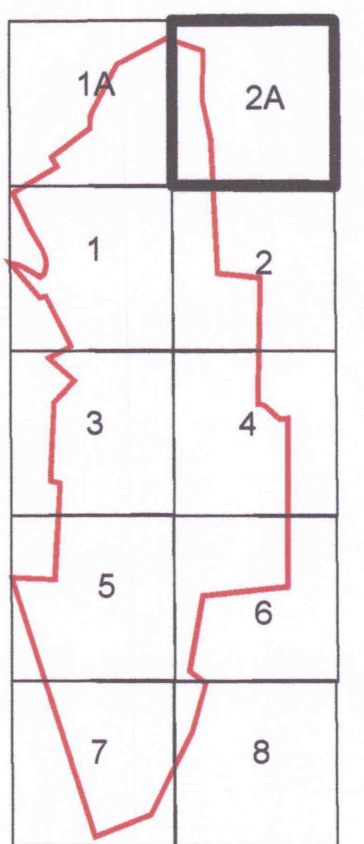

NOTE: This map was assembled using electronically scanned images of the Dunkard No. 2 Mine map, a map identified as the final map of the Mathews Mine, and an electronic map of the Crowded Mine-A Portal. The maps were provided by PADES, MDPD, and Cobra Mining, LLC. CME Engineering LP carried out both a GPS Survey and an underground check survey to physically locate identifiable features common to all three mines and to locate the underground workings of the Dunkard No. 2 Mine. No survey data was available for either the Mathews Mine or the Dunkard No. 2 Mine other than the surveys carried out by CME Engineering LP. The survey information has been added to the maps and was used to geo-reference the mine maps. No adjustments or alterations were made to the images of any of the mine maps utilized.

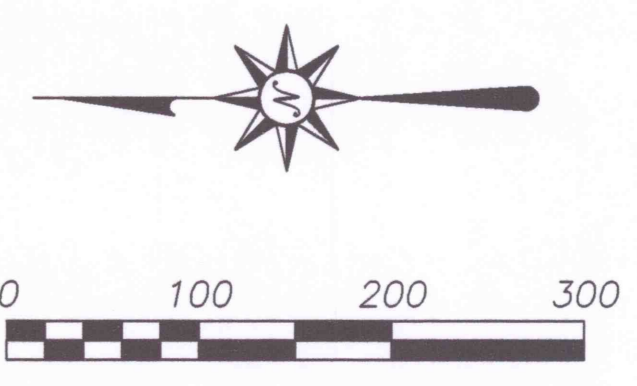

J. G. Price
 JAMES G. PRICE, MINE SUPERINTENDENT DATE

J. E. Ferenci
 JACK E. FERENCI, PE DATE

RECEIVED
 APR 16 2005

<p>CME ENGINEERING CME ENGINEERING LP 165 East Union Street, Suite 100, Somerset, PA 15501 814-443-3344 FAX: 814-444-0365</p>		<p>DUNKARD 100' SHT 2A COBRA MINING, LLC 178 CHESS MINE ROAD DILLNER, PA 15227 FINAL MAP OF DUNKARD MINE NO. 2 SEWICKLEY COAL BEAM MINING COMPLETED 12/31/05 MSHA ID #55-01301 CMP #00641329</p>											
		<p>REVISIONS</p> <table border="1"> <thead> <tr> <th>No.</th> <th>By</th> <th>Date</th> <th>Description</th> </tr> </thead> <tbody> <tr> <td>1</td> <td>MAK</td> <td>6/28/05</td> <td>Mining Updated</td> </tr> <tr> <td>2</td> <td>RJB</td> <td>12/31/05</td> <td>Mining Updated</td> </tr> </tbody> </table>	No.	By	Date	Description	1	MAK	6/28/05	Mining Updated	2	RJB	12/31/05
No.	By	Date	Description										
1	MAK	6/28/05	Mining Updated										
2	RJB	12/31/05	Mining Updated										

RECEIVED
 JUN 27 2005
 Dept. of Environmental Resources
 Machinery Control Unit