



**LEGEND**

- UNDERGROUND PERMIT BOUNDARY
- SUBSISTENCE CONTROL BOUNDARY
- OCCUPIED DWELLING
- UNOCCUPIED STRUCTURE
- DRILLHOLE
- SURFACE PARCEL IDENTIFICATION NUMBER
- SURFACE PROPERTY LINE
- LIMIT OF PROPOSED MINING
- GASWELL
- PROJECTED COAL MINING
- COAL MINED
- STOPPING
- STOPPING W/ DOOR
- STOPPING WITH HOLE
- CHECK CURTAIN
- REGULATOR
- DOUBLE DOORS
- RUN-THROUGH CHECK
- OVERCAST
- INTAKE AIR
- RETURN AIR
- CO MONITOR
- MONITORING POINT
- TAIL PIECE
- BELT
- PRIMARY ESCAPEWAY
- SECONDARY ESCAPEWAY
- MINED OUT AREA

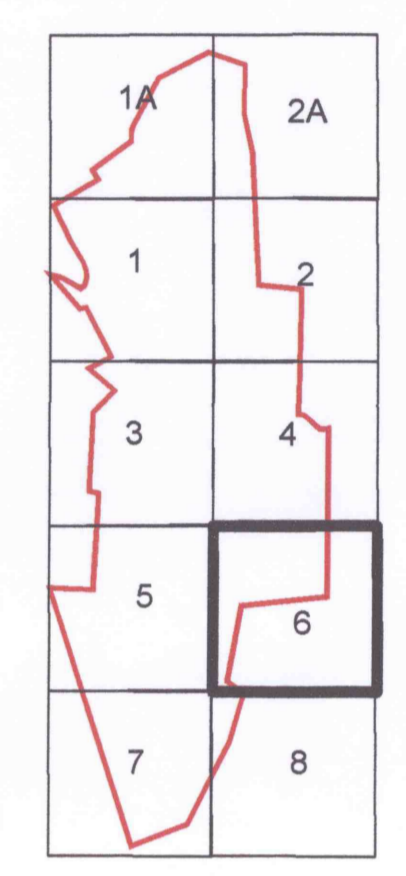

NOTE: This map was assembled using electronically scanned images of the Dunkard No. 2 Mine map, a map identified as the first map of the Mathews Mine, and an electronic map of the Crowded Mine-A Parcel. The maps were provided by PADEP, MEPCO, and Cobra Mining, LLC. CME Engineering LP carried out both a GPS Survey and an underground check survey to physically locate identifiable features common to all three mines and to locate the underground workings of the Dunkard No. 2 Mine. No survey data was available for either the Mathews Mine or the Dunkard No. 2 Mine other than the surveys carried out by CME Engineering LP. The survey information has been added to the maps and was used to georeference the mine maps. No adjustments or alterations were made to the images of any of the mine maps utilized.

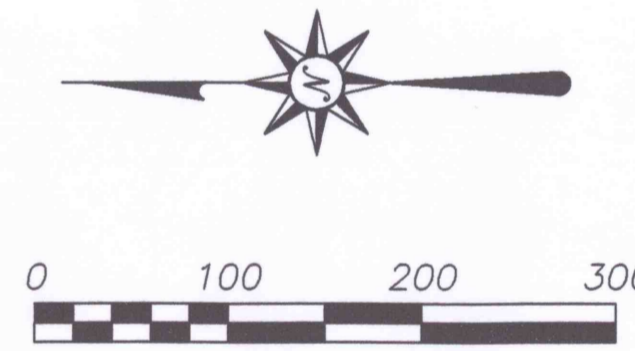

*James G. Price*  
 JAMES G. PRICE, MINE SUPERINTENDENT      3/2/06  
 DATE

*Jack E. Precenci*  
 JACK E. PRECENCI, PE      3/2/06  
 DATE

RECEIVED  
 APR 10 2006  
 Dept. of Environmental Protection  
 Bureau of Mine Safety

<p><b>CME ENGINEERING</b>          CME ENGINEERING LP          165 East Union Street, Suite 100, Somerset, PA 15501          814-443-3344 FAX: 814-444-0365</p>		<p>DUNKARD 100' SHT 6          COBRA MINING, LLC          178 CHESS MINE ROAD          P.O. BOX 40          DILLINER, PA 15327</p>													
		<p><b>FINAL MAP OF DUNKARD MINE NO. 2</b>          SEWICKLEY COAL SEAM          MINING COMPLETED 12/01/05          MSHA ID #36-01301          CMAP #30841309</p>													
<p>REVISIONS</p> <table border="1"> <thead> <tr> <th>No.</th> <th>By</th> <th>Date</th> <th>Description</th> </tr> </thead> <tbody> <tr> <td>1</td> <td>MAK</td> <td>6/28/05</td> <td>Mining Updated</td> </tr> <tr> <td>2</td> <td>RJB</td> <td>12/31/05</td> <td>Mining Updated</td> </tr> </tbody> </table>				No.	By	Date	Description	1	MAK	6/28/05	Mining Updated	2	RJB	12/31/05	Mining Updated
No.	By	Date	Description												
1	MAK	6/28/05	Mining Updated												
2	RJB	12/31/05	Mining Updated												
<p>Drawn By: MAK          Checked By: JEF          Date: 6/28/05          Scale: 1" = 100'          Project No.: 316-051          File Name: FINAL MAP.DWG          Drawing: 8 of 10</p>		<p>Prepared by:          COBRA MINING          178 CHESS MINE RD          DILLINER, PA          SEWICKLEY COAL          DUNKARD MINE          SEWICKLEY COAL          DUNKARD TOWN          PENNSYLVANIA          MSHA ID # 36-01301          CMAP #30841309</p>													