


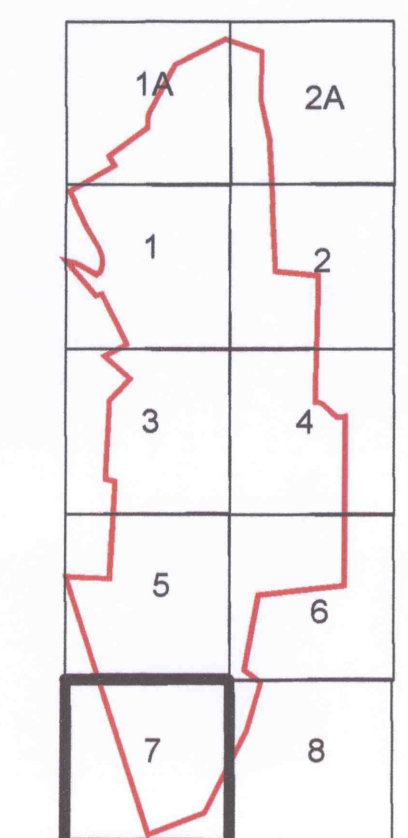


LEGEND

- UNDERGROUND PERMIT BOUNDARY
- SUBSIDENCE CONTROL BOUNDARY
- OCCUPIED DWELLING
- UNOCCUPIED STRUCTURE
- DRILLHOLE
- SURFACE PARCEL IDENTIFICATION NUMBER
- SURFACE PROPERTY LINE
- LIMIT OF PROPOSED MINING
- GASWELL
- PROJECTED COAL MINING
- COAL MINED
- STOPPING
- STOPPING W/ DOOR
- CHECK CURTAIN
- REGULATOR
- DOUBLE DOORS
- RUN-THROUGH CHECK
- OVERCAST
- INTAKE AIR
- RETURN AIR
- CO MONITOR
- MONITORING POINT
- TAIL PIECE
- BELT
- PRIMARY ESCAPEWAY
- SECONDARY ESCAPEWAY
- MINED OUT AREA



NOTE: This map was assembled using electronically scanned images of the Dunkard No. 2 Mine map, a map identified as the final map of the Mother Mine, and an electronic map of the Crowfoot Mine-A Permit. The maps were provided by PADEF, MPPCO, and Cobra Mining, LLC. CME Engineering LP carried out both a GPS Survey and an underground check survey to physically locate identifiable features common to all three mines and to locate the underground workings of the Dunkard No. 2 Mine. No survey data was available for either the Mother Mine or the Dunkard No. 2 Mine other than the surveys carried out by CME Engineering LP. The survey information has been added to the maps and was used to geo-reference the mine maps. No adjustments or alterations were made to the images of any of the mine maps utilized.

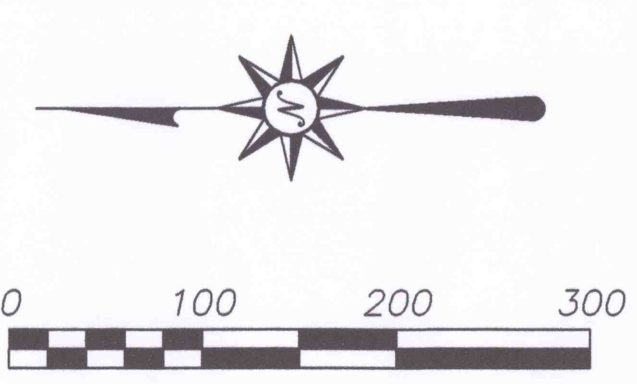

J.G. Price
 JAMES G. PRICE, MINE SUPERINTENDENT 3/2/05
 DATE

J.E. Ferenci
 JACK E. FERENCI, PE 3/16/05
 DATE

RECEIVED
 APR 10 2005

CME
ENGINEERING

CME ENGINEERING LP
 165 East Union Street, Suite 100, Somerset, PA 15501
 814-443-3344 FAX: 814-444-0365

DUNKARD 100' SHT 7
 COBRA MINING, LLC
 178 CHESS MINE ROAD
 P.O. BOX 40
 DILLINER, PA 15327
FINAL MAP OF
DUNKARD MINE NO. 2
 SEMWICKLEY COAL SEAM
 MINING COMPLETED 12/31/05
 MSHA ID #58-01301
 CMAP #30841309

REVISIONS			Drawn By: MAK	
No.	By	Date	Description	Checked By: JEF
1	MAK	6/28/05	Mining Updated	Date: 6/28/05
2	RJB	12/31/05	Mining Updated	Scale: 1" = 100'
				Project No.: 316-051
				File Name: FINAL MAP.DWG
				Drawing: 9 of 10

SHEET
 DUNKARD
 DUNKARD MINE
 DUNKARD TAIL
 SCALE: 1"=100'

