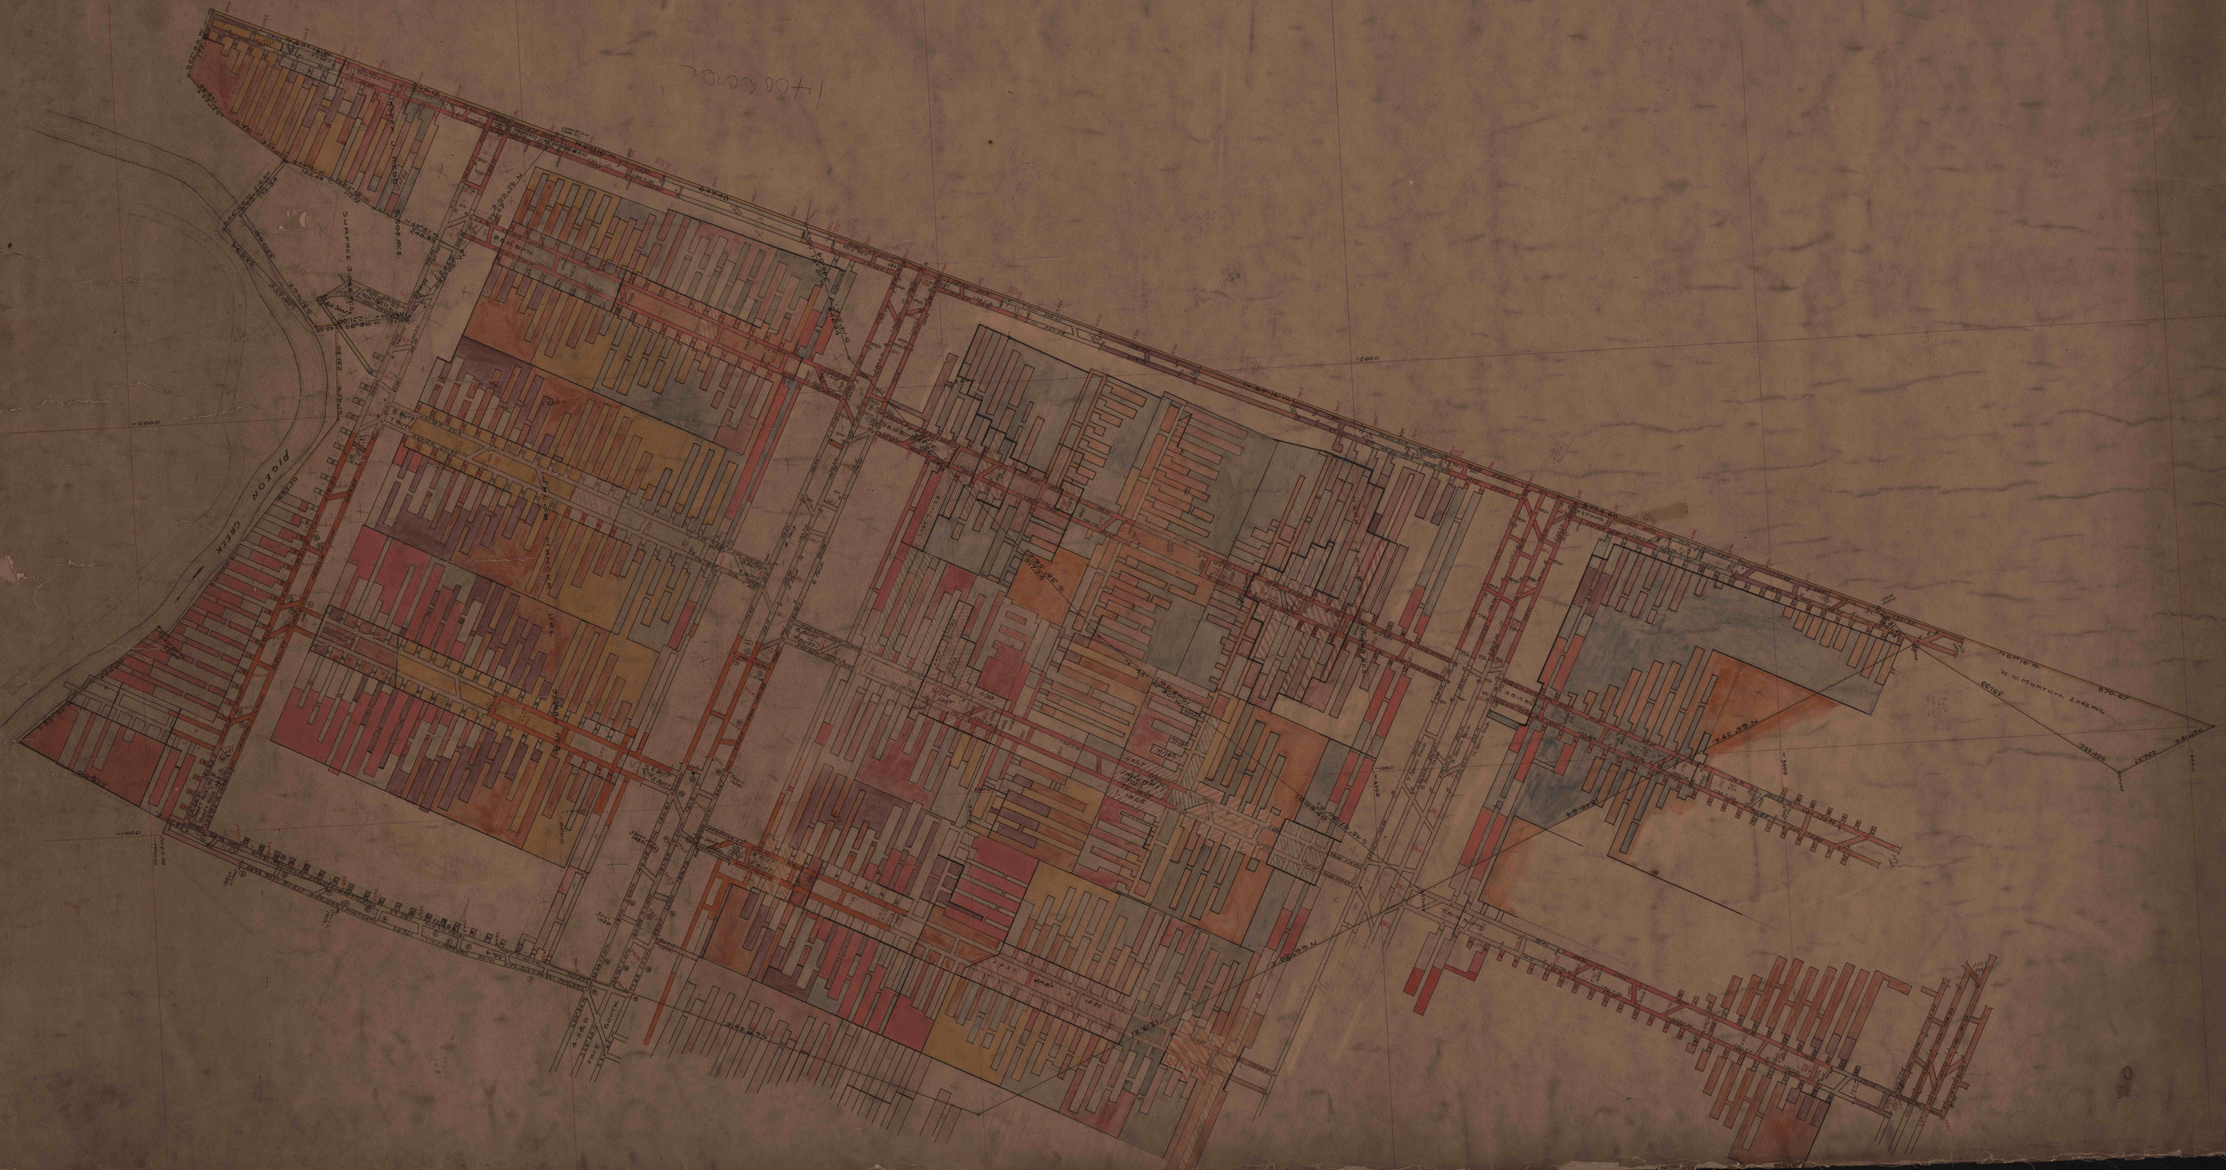
PIGEON CREEK
SECTION
W. W. MORTON, ENGR.
CHIEF