


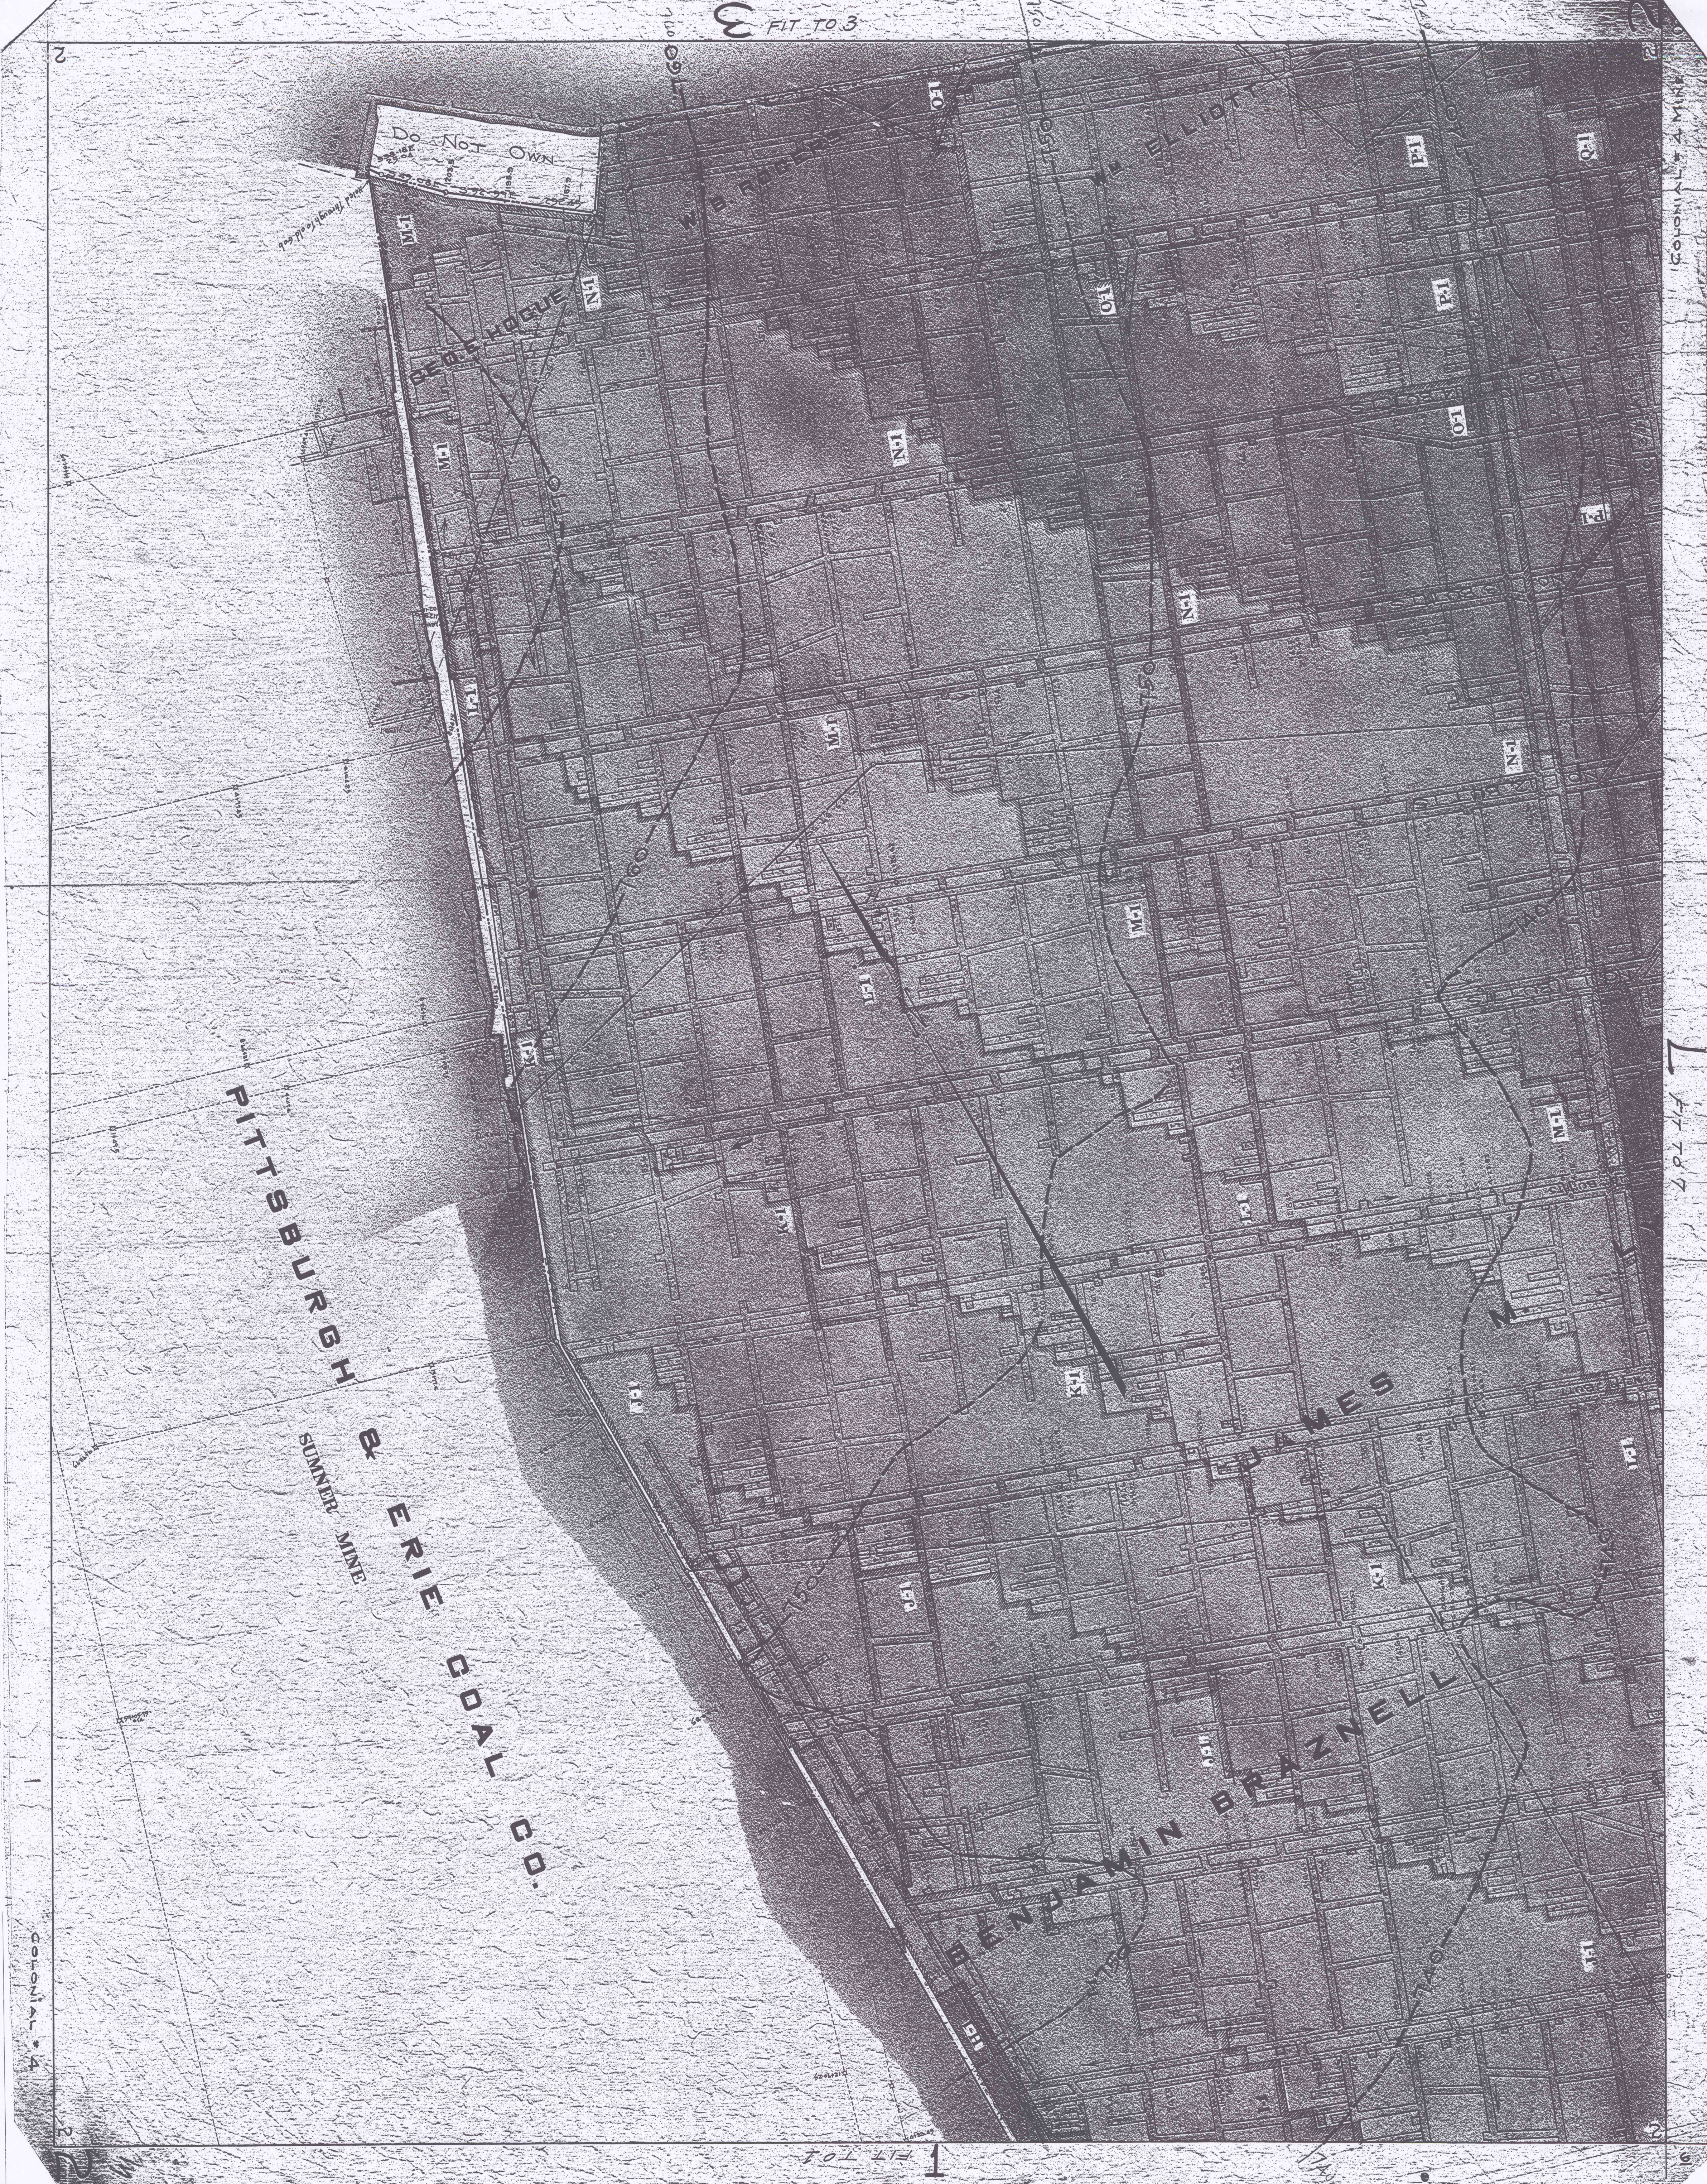

Do Not Own

PITTSBURGH & ERIE COAL CO. SUMNER MINE

JAMES

BENJAMIN BRAZELLE

COLONIAL #4 MINE

FIT TO 3

FIT TO 1