


8 FLOOR

COLONIAL NO. 4

12 FT TO 12

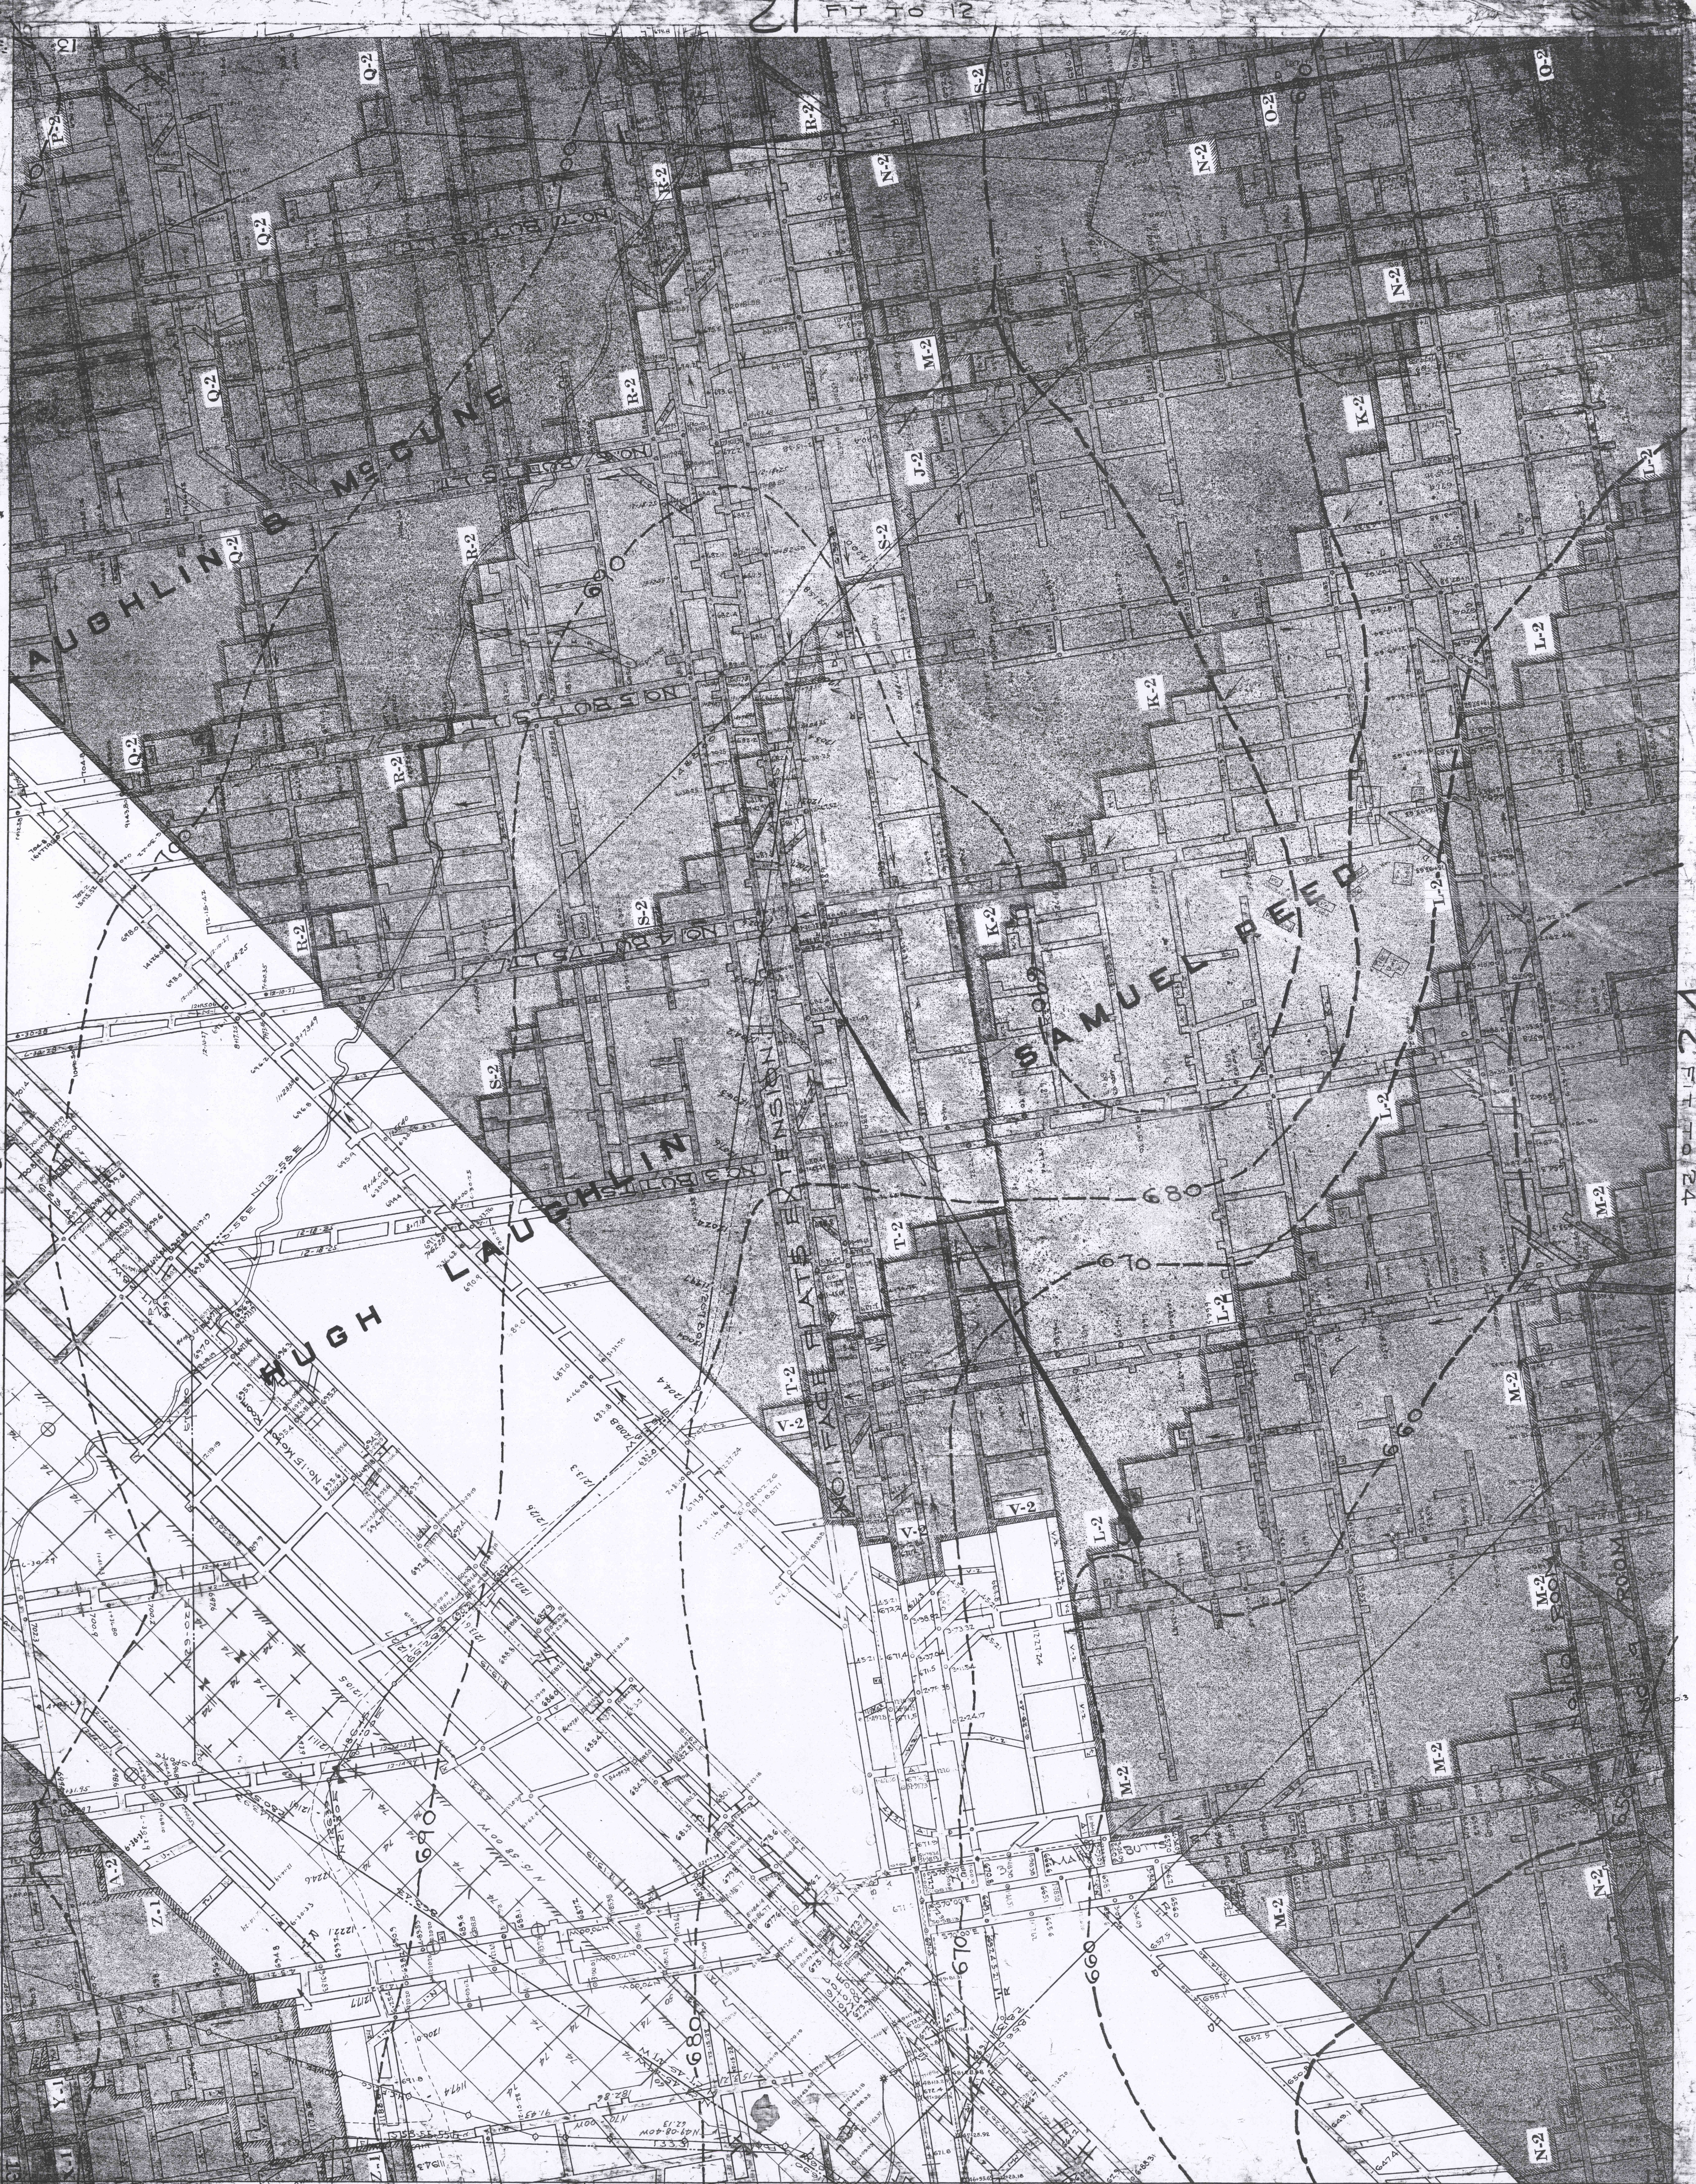

72011571