


22 11.10.22

SPACES GOAL TO BE LEFT UNMINED UNDERSTORY FOR SELF ENGELERS

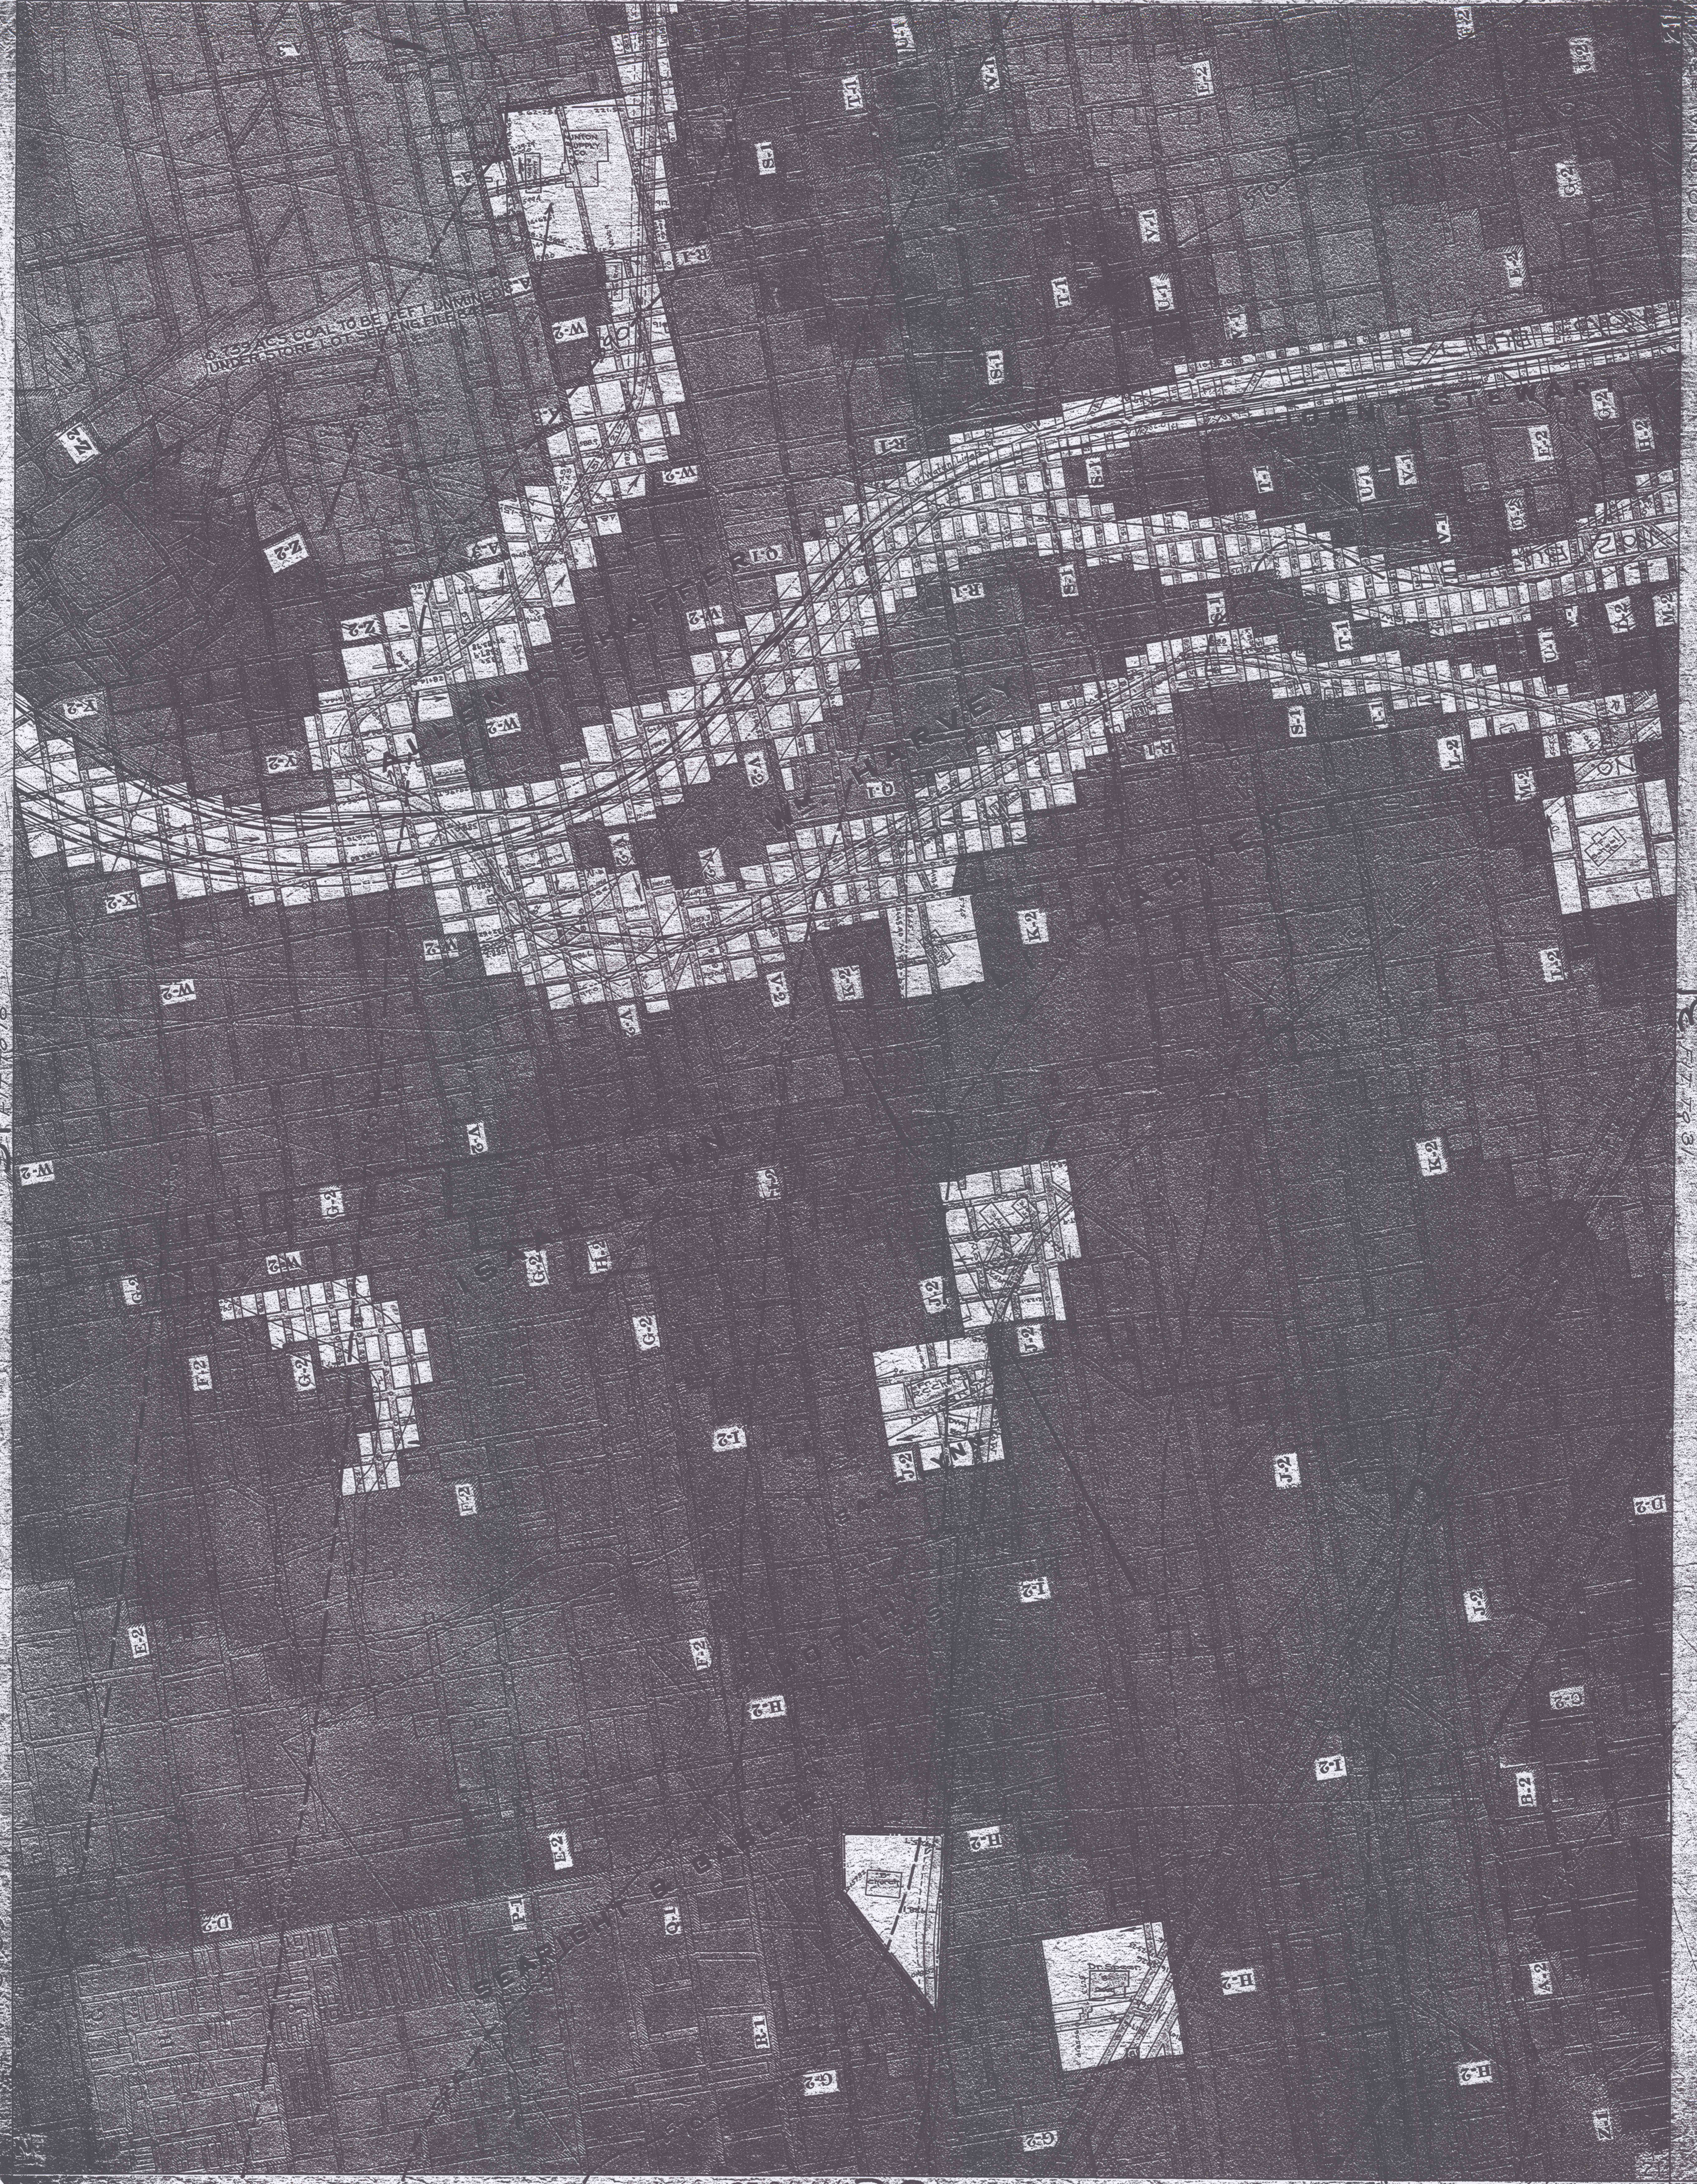

6

3

COLON

COLON

02 11.10.20