FIT TO 21 21

COLONIAL No 4
COLONIAL No 3
22

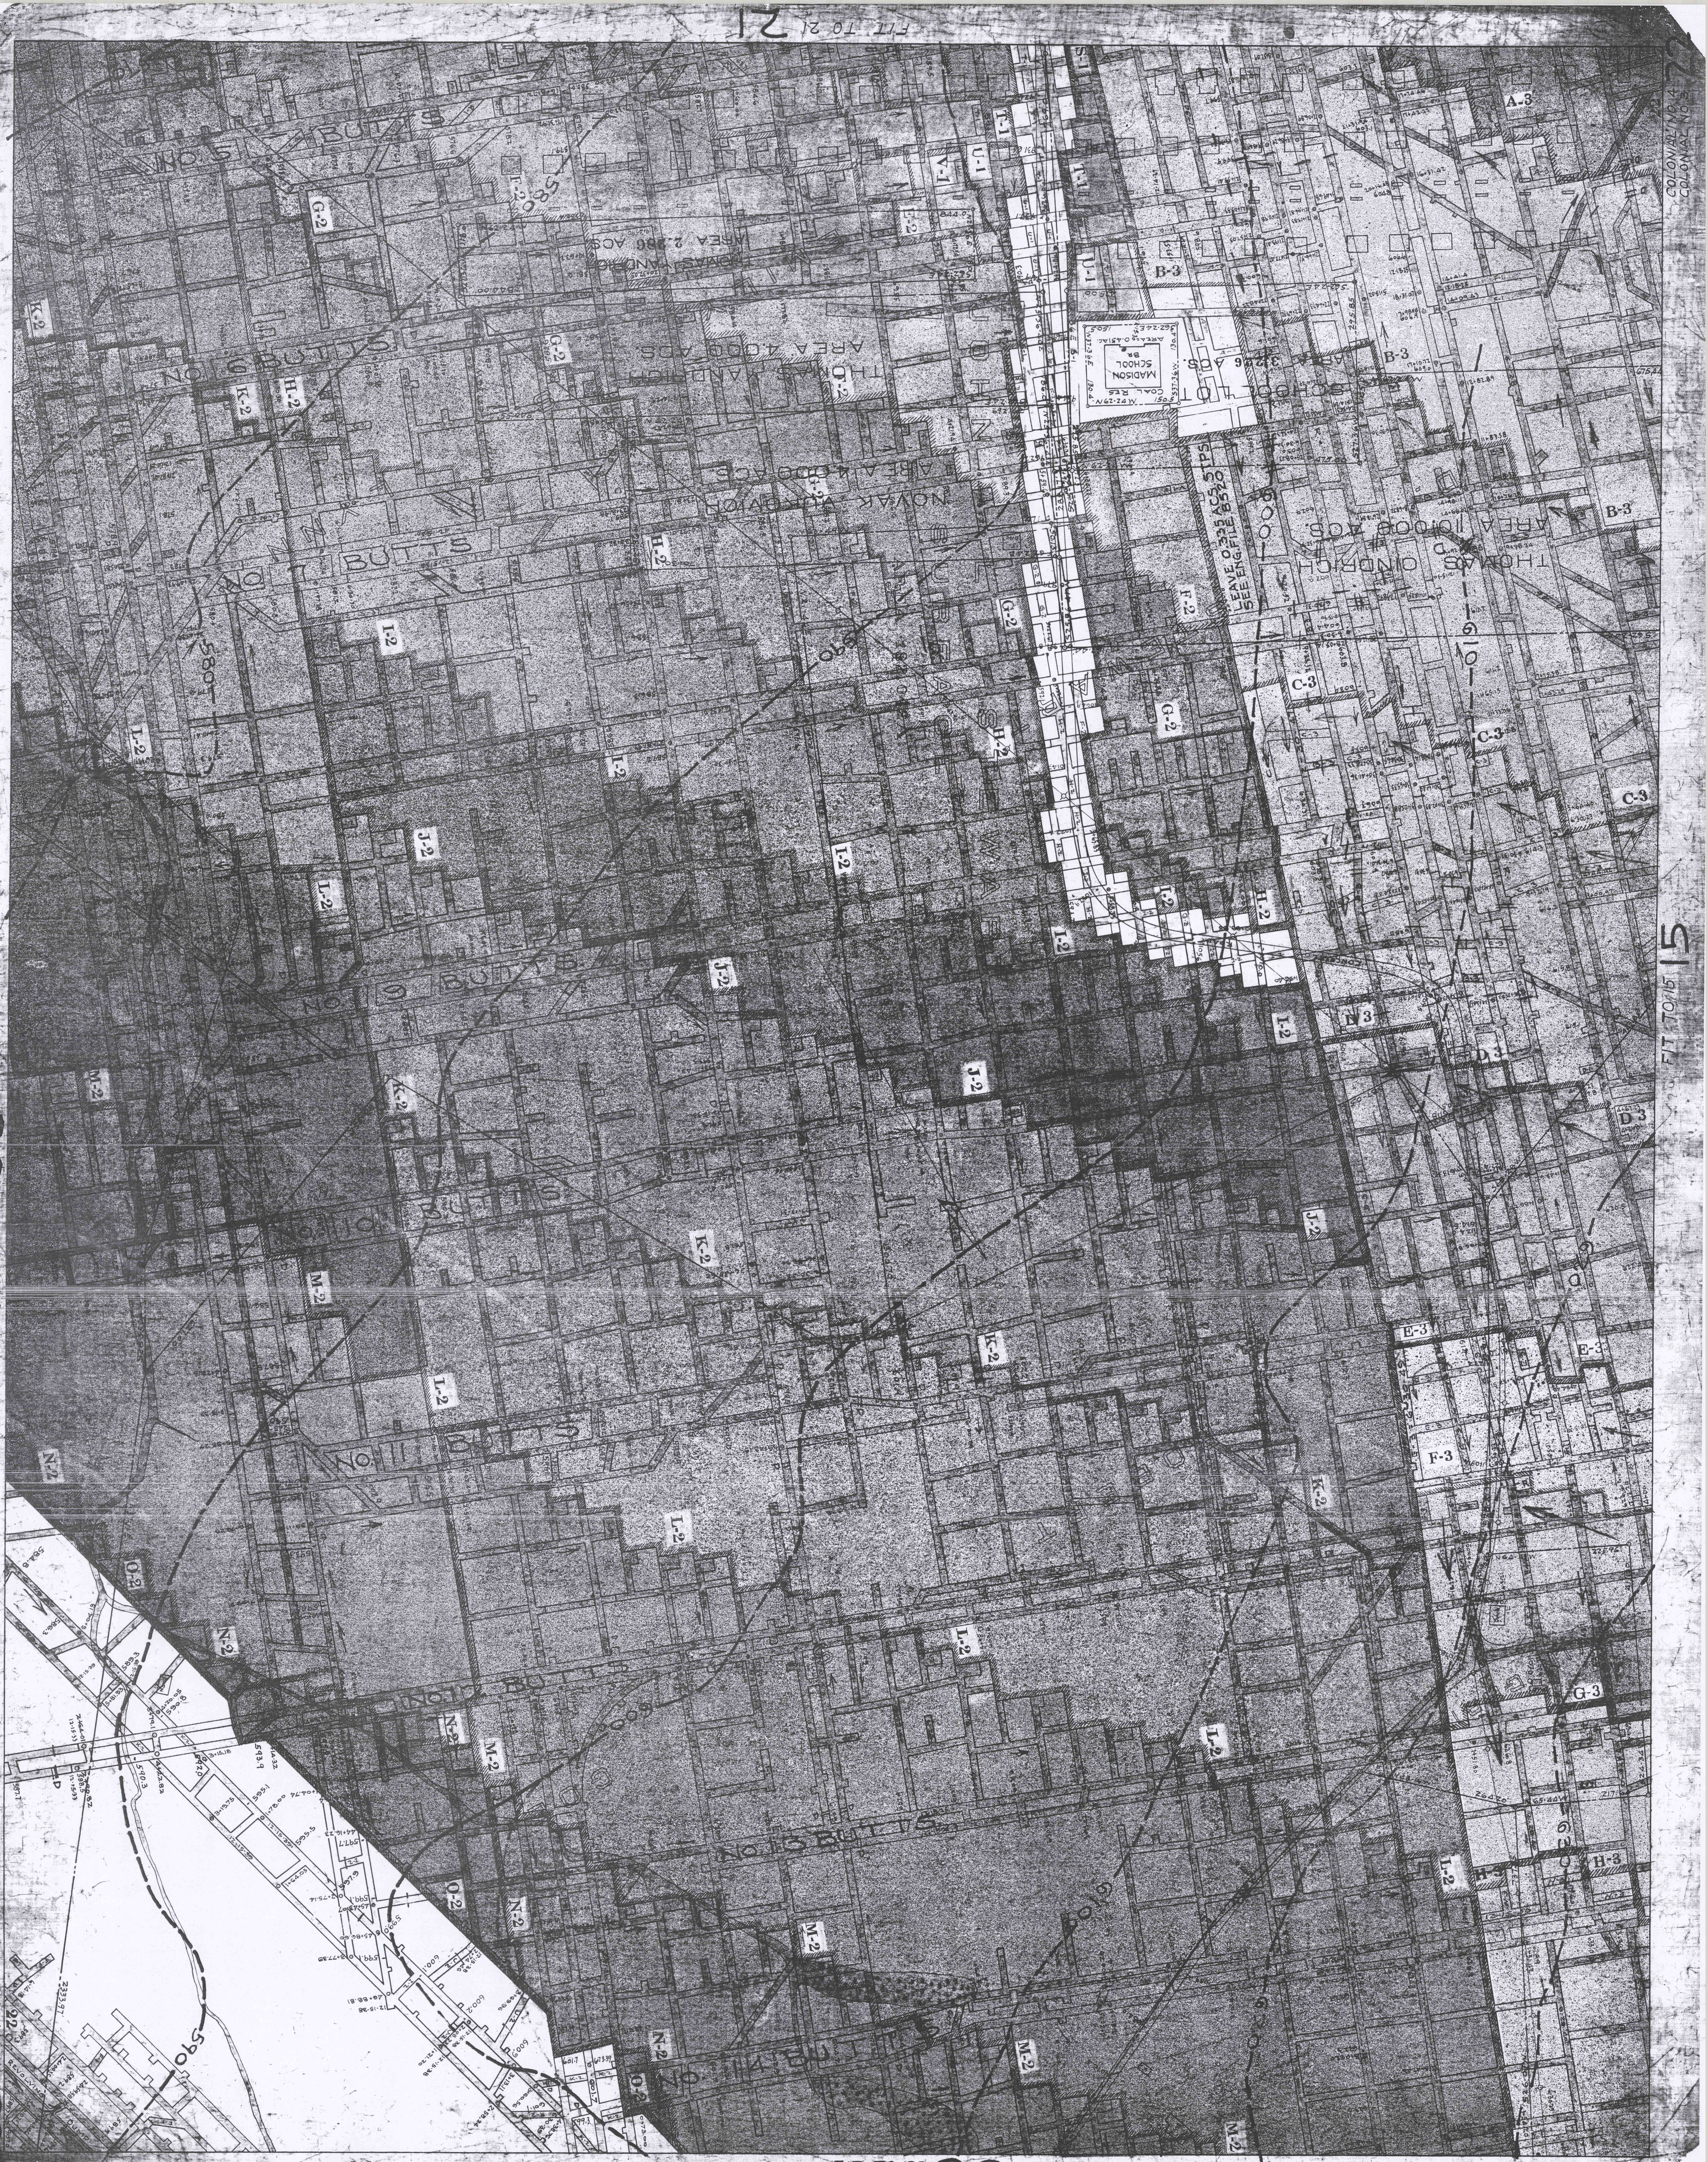
NO 5 BUTTS
NO 6 BUTTS
NO 7 BUTTS
NO 9 BUTTS
NO 10 BUTTS
NO 11 BUTTS
NO 12 BUTTS
NO 13 BUTTS
NO 14 BUTTS
AREA 2.286 ACS
THOMAS ANDRICH
AREA 4.000 ACS
THOMAS ANDRICH
AREA 4.000 ACS
NOVAK VUKOVICH
AREA 3.296 ACS
SCHOOL LOT
MADISON SCHOOL BR
COAL RES
AREA 0.451 AC
AREA 10.000 ACS
THOMAS OINDRICH
LEAVE 0.335 ACS STPS
SEE ENG. FILE 8520
REVOLVING DUMP
A-3
B-3
C-3
D-3
E-3
F-3
G-3
H-3
E-2
F-2
G-2
H-2
I-2
J-2
K-2
L-2
M-2
N-2
O-2
S-1
T-1
U-1
V-1
580
585
590
595
600
605
610
620

FIT TO 30 30

FIT TO 15 15

COLONIAL No 4
COLONIAL No 3
22

FIT TO 23 23