



COLONIAL NO. 3 MINE


UNION STATES STEEL CORP.

NOVEMBER 1917
FAYETTE CO. PA.

SCALE 1 INCH=100 FT.

PLAN OF LEVELS

DATE	WORKED BY	DATE	WORKED BY	DATE	WORKED BY
12-15-44	V-2 BRE	9-22-11	A-1 W.S.	12-11-26	K-1 AME
6-30-45	W-2 BRE	1-1-12	B-1 W.S.	6-30-27	L-1 AME
12-15-45	X-2 BRE	6-21-12	C-1 W.S.	12-10-28	M-1 W.S.
6-21-46	Z-2 AME	12-16-12	D-1 W.S.	12-16-28	N-1 AME
12-28-46	A-3 W.S.	12-16-12	E-1 W.S.	6-29-29	P-1 W.S.
12-30-47	B-3 AME	5-20-13	F-1 W.S.	12-14-29	Q-1 E.S.
6-30-48	C-3 AME	2-21-13	G-1 W.S.	6-30-30	R-1 E.S.
12-30-48	D-3 W.S.	9-23-13	H-1 W.S.	12-18-31	S-1 E.S.
12-15-49	F-3 AME	1-18-14	I-1 W.S.	6-30-31	T-1 E.S.
12-15-49	F-3 AME	3-24-14	J-1 W.S.	12-12-31	U-1 AME
6-30-50	G-3 W.S.	6-28-14	K-1 W.S.	6-30-32	V-1 CFH
12-15-50	H-3 AME	10-3-14	L-1 W.S.	12-15-32	W-1 AME
6-15-51	I-3 W.S.	12-21-14	M-1 W.S.	6-30-33	X-1 AME
12-15-51	J-3 W.S.	1-11-15	N-1 W.S.	12-12-33	Y-1 AME
6-25-52	K-3 W.S.	12-4-15	O-1 W.S.	6-30-34	Z-1 AME
12-15-52	L-3 W.S.	6-30-16	P-1 W.S.	12-12-34	A-2 AME
6-29-53	M-3 W.S.	12-30-16	Q-1 W.S.	6-21-35	B-2 AME
12-9-53	N-3 W.S.	6-21-17	R-1 W.S.	12-14-35	C-2 AME
6-15-54	O-3 W.S.	11-3-18	S-1 W.S.	6-30-36	D-2 AME
6-26-54	P-3 W.S.	6-24-18	T-1 W.S.	12-15-36	E-2 AME
6-13-59	Q-3 W.S.	12-21-18	U-1 W.S.	6-30-37	F-2 AME
		5-8-19	V-1 W.S.	12-15-37	G-2 W.S.
		12-28-19	W-1 W.S.	12-30-38	H-2 W.S.
		6-11-20	X-1 W.S.	12-30-38	I-2 W.S.
		1-31-20	Y-1 W.S.	6-30-39	J-2 W.S.
		6-30-22	Z-1 W.S.	12-19-39	K-2 W.S.
		12-26-22	C-1 W.S.	6-29-40	L-2 W.S.
		6-30-23	D-1 W.S.	12-14-40	M-2 W.S.
		12-25-23	E-1 W.S.	6-30-41	N-2 W.S.
		6-30-24	F-1 W.S.	12-18-41	O-2 W.S.
		12-21-24	G-1 W.S.	6-30-42	P-2 W.S.
		6-30-25	H-1 W.S.	12-17-42	Q-2 W.S.
		12-24-25	I-1 W.S.	Colonial No. 3 & 4 Assigned to Colonial No. 3.	
		6-30-26	J-1 W.S.		

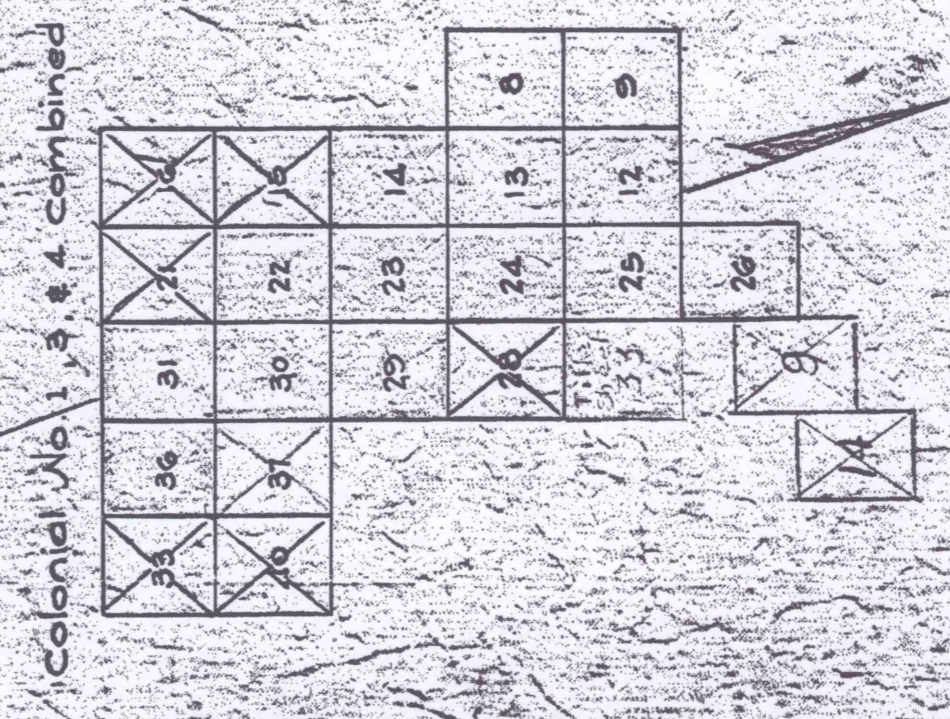

This print is certified to be an exact copy of the original map of COLONIAL NO. 3 MINE and to the best of my knowledge and belief shows the excavations in said mine.

Dr. W. J. ... Chief Engineer

Date of mine abandonment March 14, 1961